
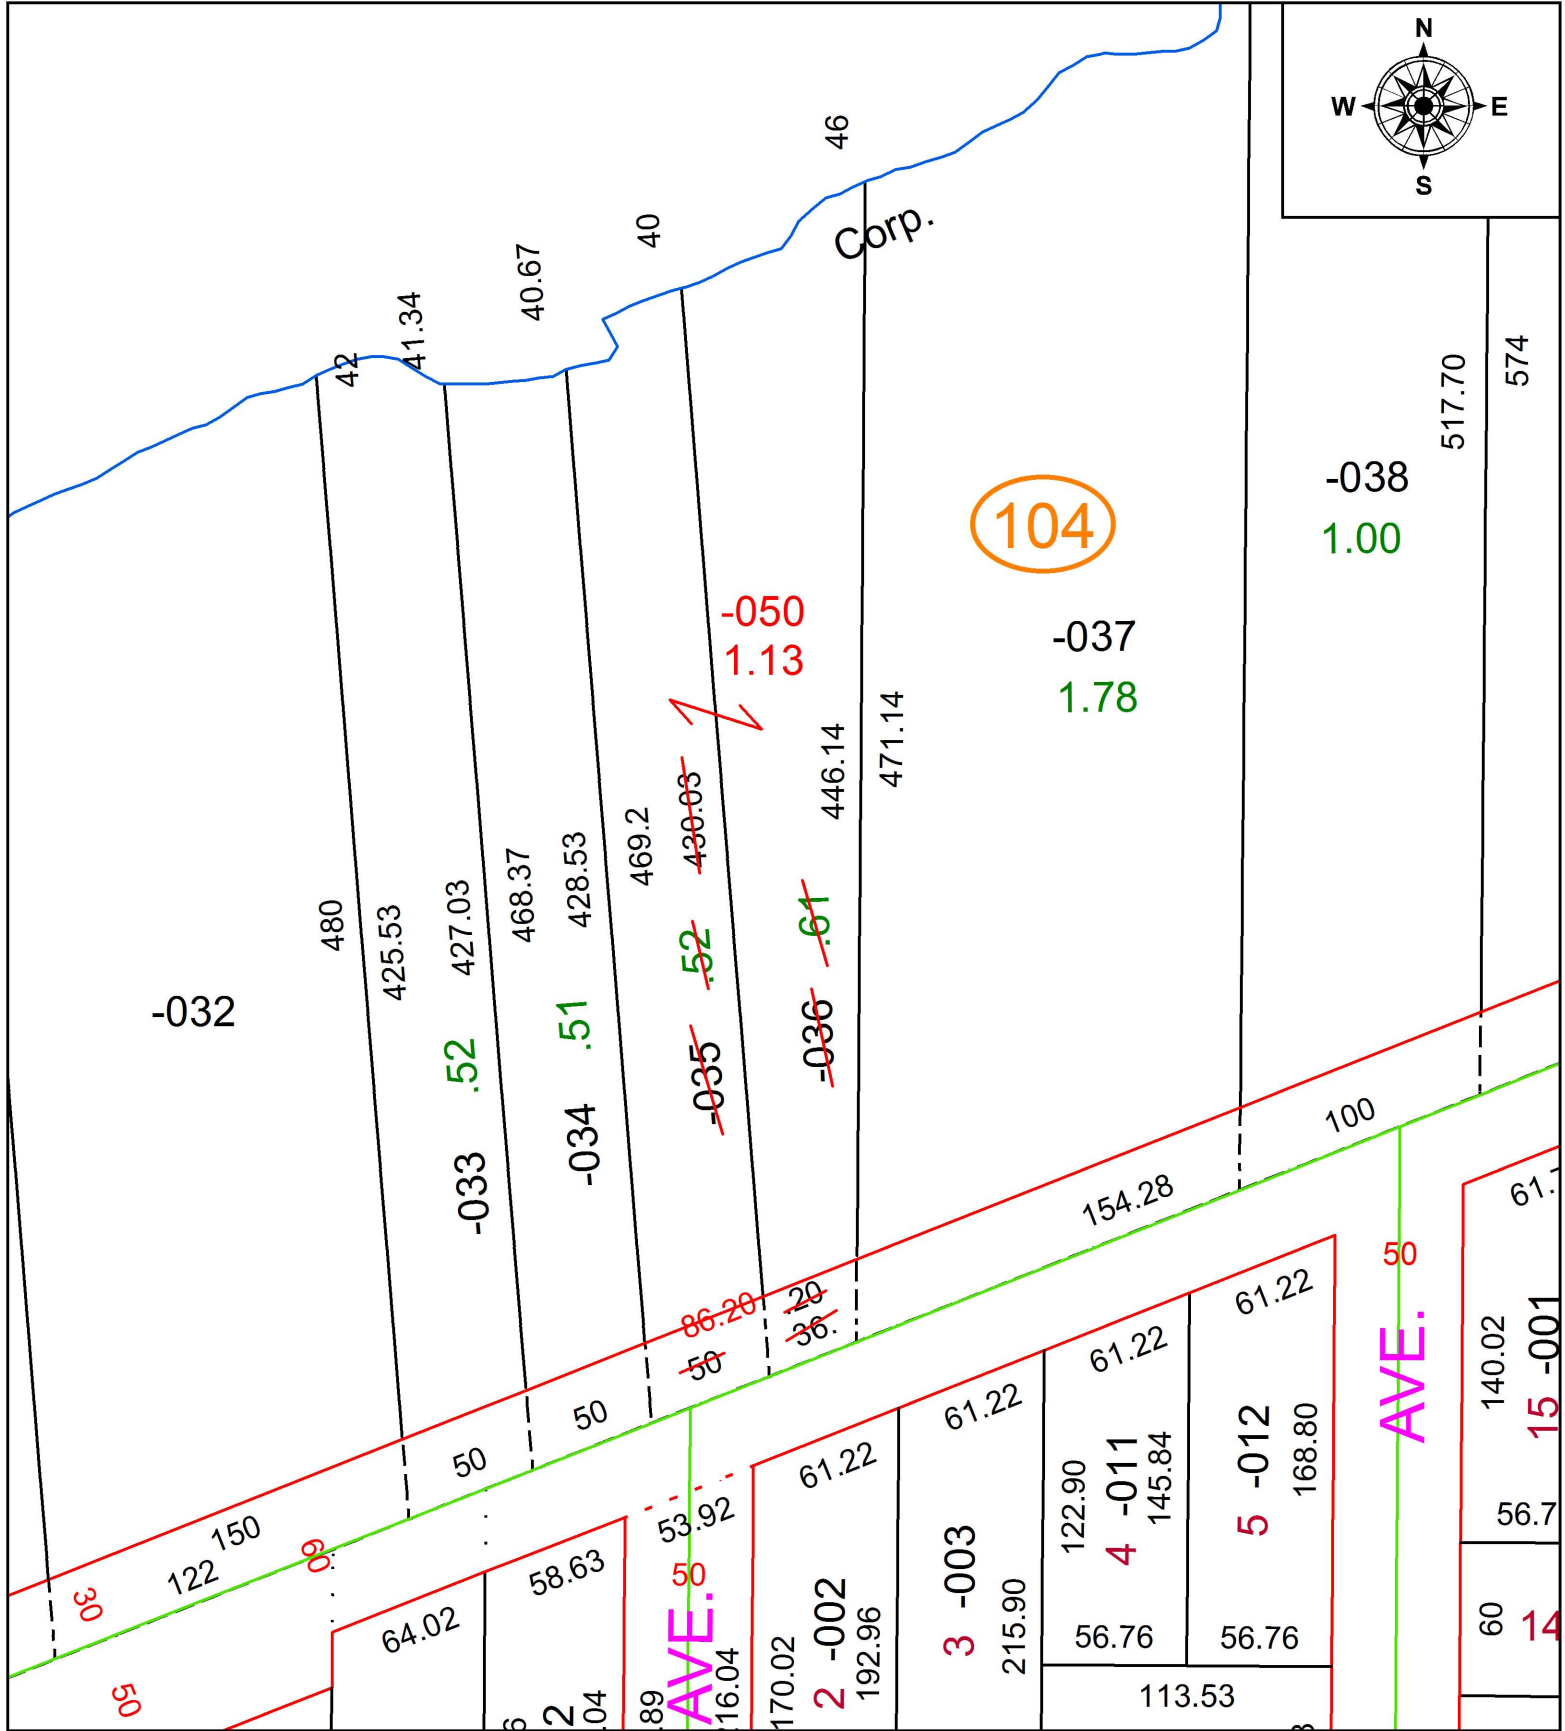


PARENT PARCEL: 04-00-007-104-035, -036

CHILD PARCEL: 04-00-007-104-050

STARTING POINT: INTERSECTION OF C/L OF LAKE RD. AND EAST LINE OF SEC. 7

17-03705-C

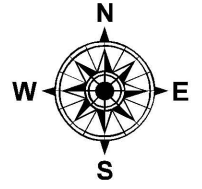

**SPLITS/DEEDS PROCESSED**

LORAIN COUNTY TAX MAP DEPARTMENT  
226 MIDDLE AVE. ELYRIA, OH

SURVEYED BY: \_\_\_\_\_ N/A  
CLOSURE: \_\_\_\_\_ N/A  
MAP PAGE(S): \_\_\_\_\_ 4-00-007  
APPROVED BY: \_\_\_\_\_ RRM DATE: \_\_\_\_\_ 7-13-17  
SCALE: \_\_\_\_\_ 1" = 75 \_\_\_\_\_ PRIOR INSTRUMENT: \_\_\_\_\_ 20150535762