
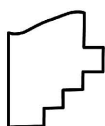
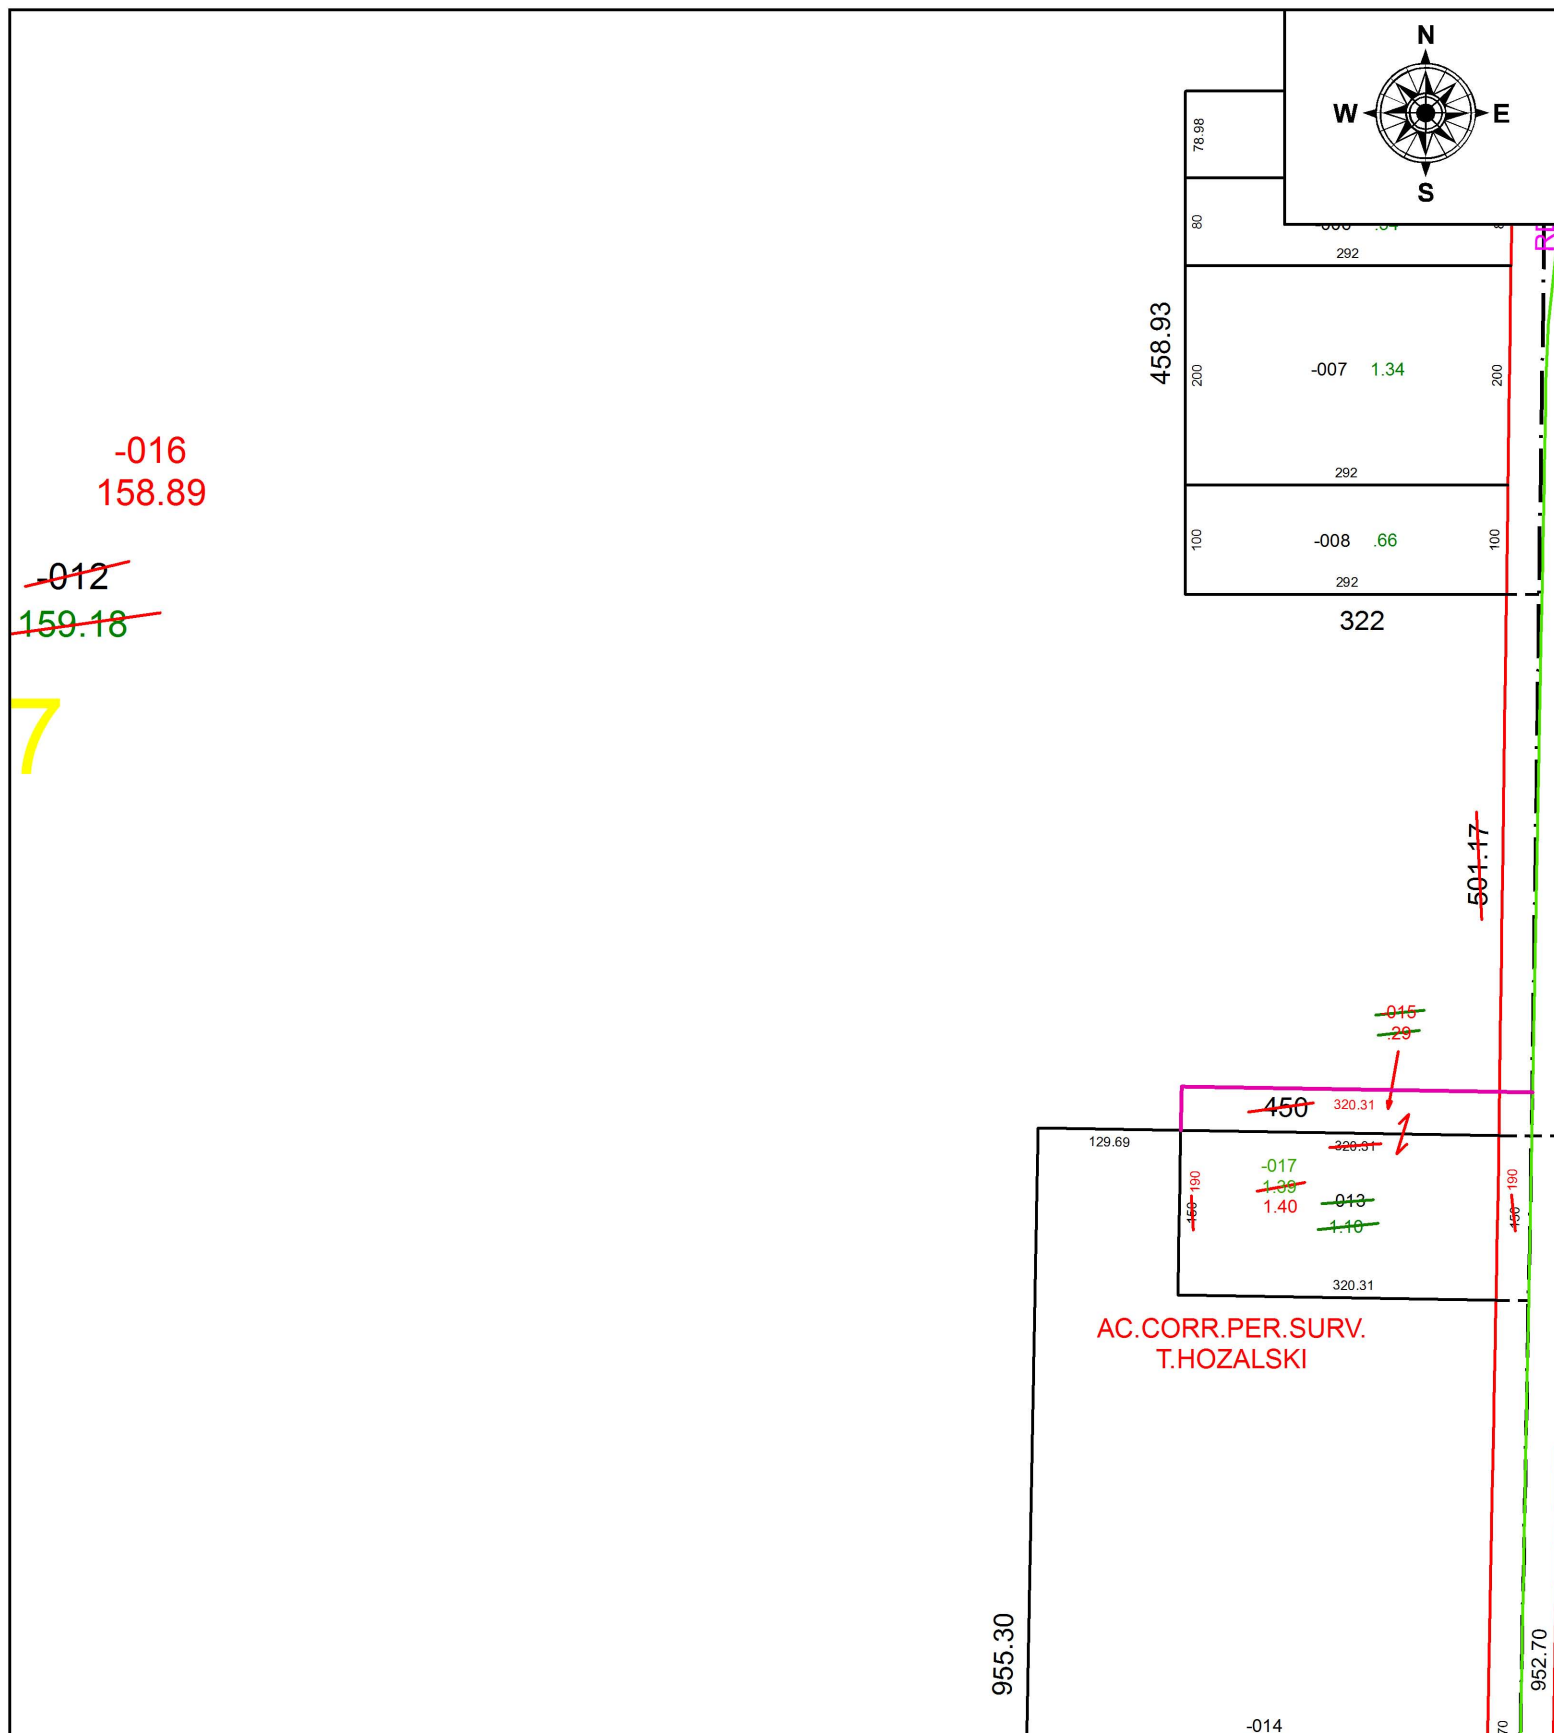


PARENT PARCEL: 09-00-007-000-012, -013

CHILD PARCEL: 09-00-007-000-015 THRU -017

STARTING POINT: SOUTHEAST CORNER OF O.L.7

17-03706

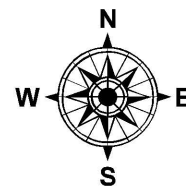

SPLITS/DEEDS PROCESSED
 LORAIN COUNTY TAX MAP DEPARTMENT
 226 MIDDLE AVE. ELYRIA, OH

SURVEYED BY: TIMOTHY D. HOZALSKI

CLOSURE: 1: 2147483648

MAP PAGE(S): 9-00-007

APPROVED BY: RRM DATE: 8-1-17

SCALE: 1" = 175 PRIOR INSTRUMENT: 20120439990