

PARENT PARCEL: 16-00-001-104-006

CHILD PARCEL: 16-00-001-104-017, -018

STARTING POINT: SOUTHEAST CORNER OF LAND CONVEYED TO MARGARET LAURETTA BARDON (DV 147/250)

17-03709-U



104

**UNCOMBINATION**

~~16-00-001-104-006~~

~~26 X 86~~



16-00-001-104-017

24 X 86

16-00-001-104-018

2 X 85

PER PRIOR DEEDS

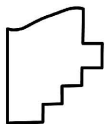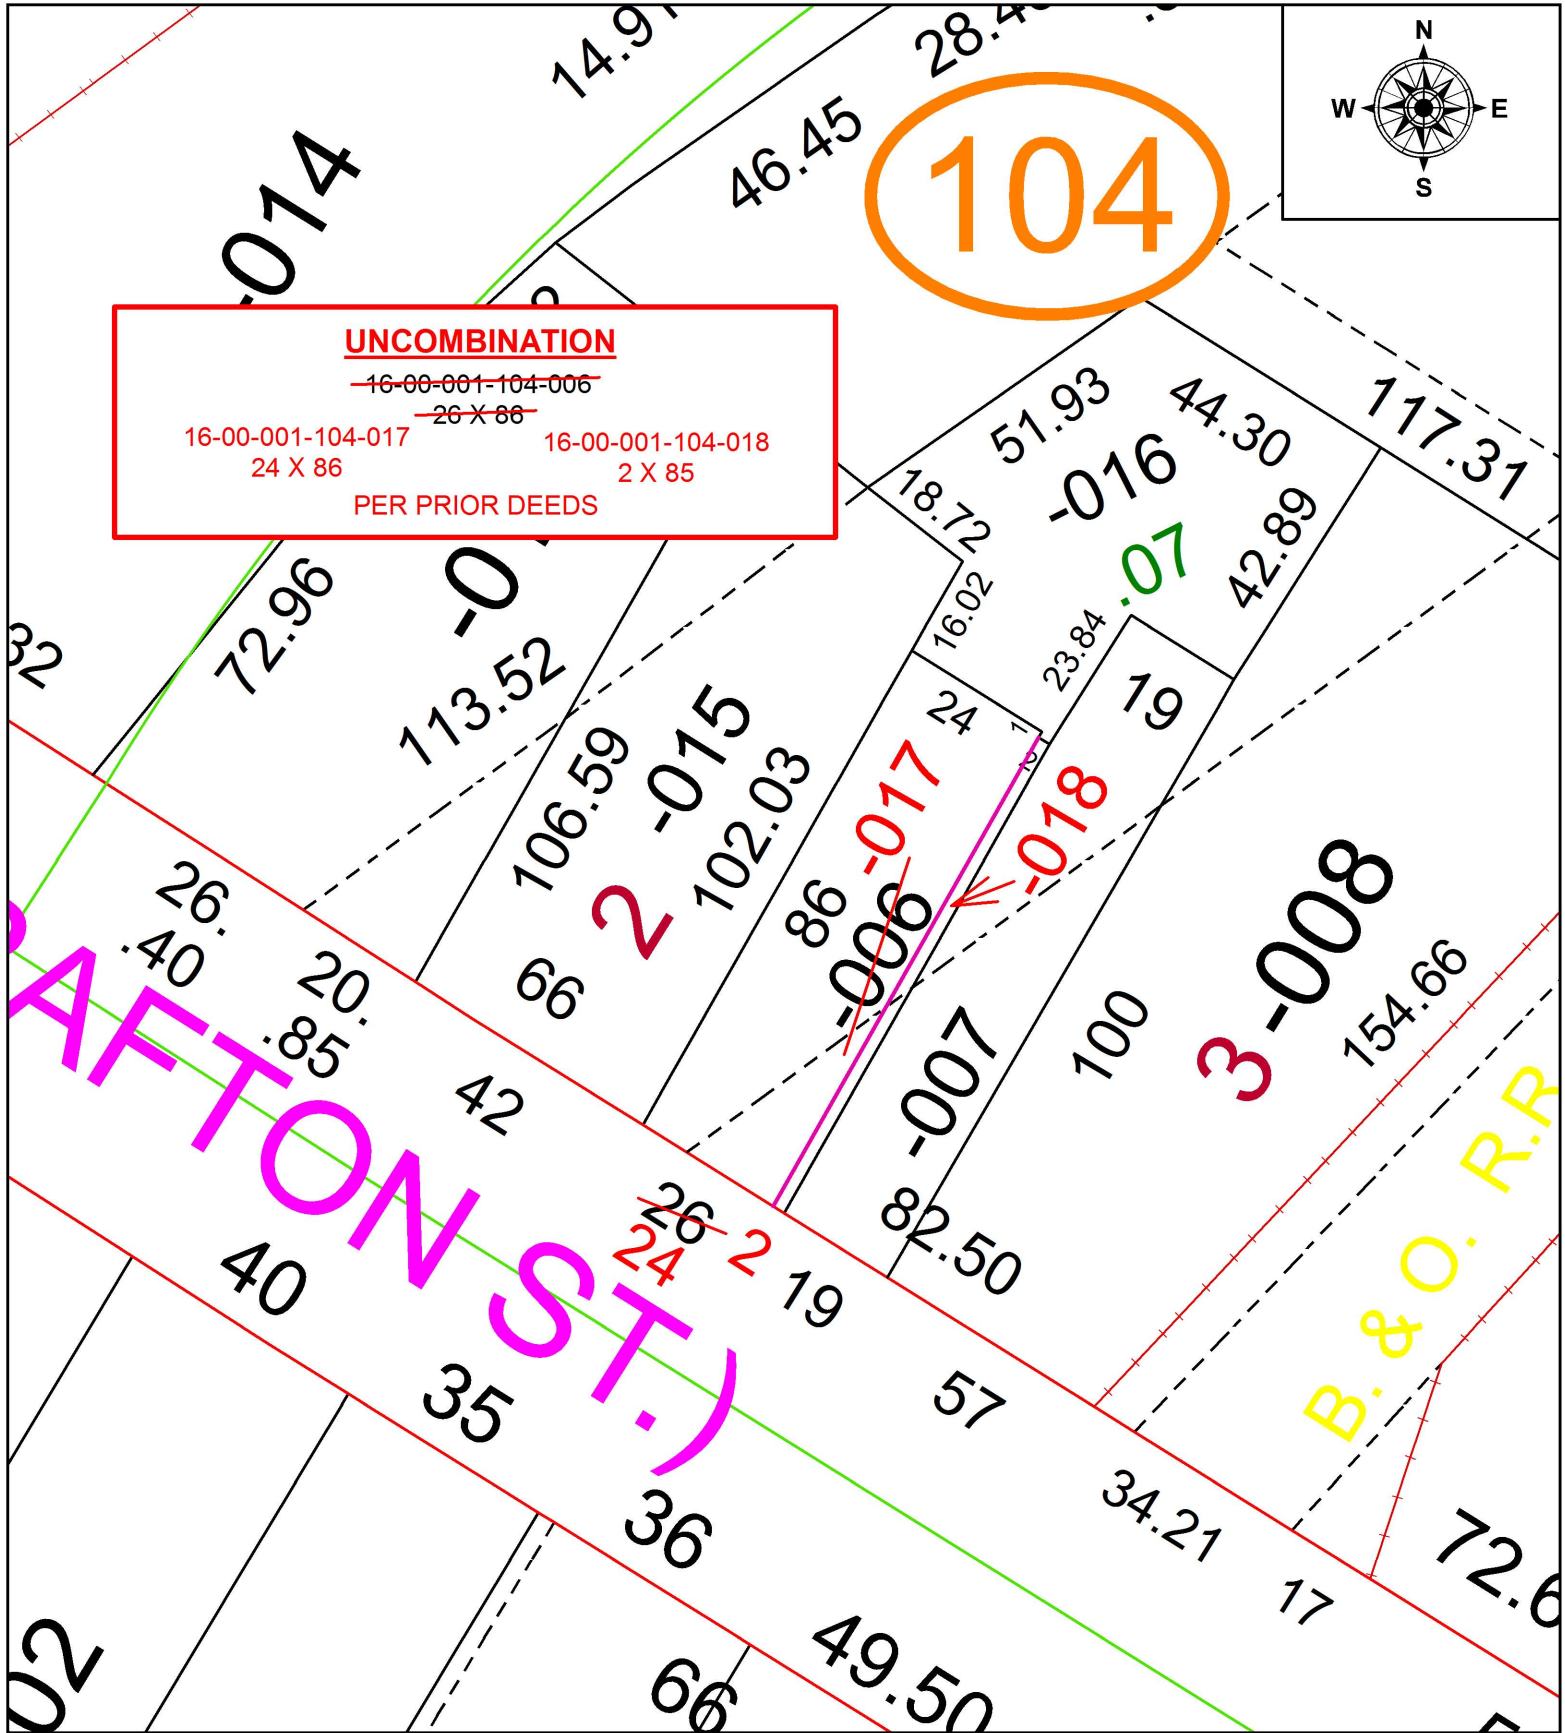

**SPLITS/DEEDS PROCESSED**

LORAIN COUNTY TAX MAP DEPARTMENT  
226 MIDDLE AVE. ELYRIA, OH

SURVEYED BY: N/A

CLOSURE: N/A

MAP PAGE(S): 16-00-001

APPROVED BY: RRM DATE: 7-24-17

SCALE: 1" = 30

PRIOR INSTRUMENT: 20160590590