
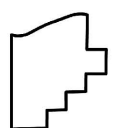


PARENT PARCEL: 09-00-110-000-004, 14-00-001-000-001, -002, 14-00-020-000-002, 15-00-001-000-001

CHILD PARCEL: 09-00-110-000-004, 14-00-001-000-005, 14-00-020-000-002, 15-00-001-000-001

STARTING POINT: SOUTHWEST CORNER OF O.L.1 PITTSFIELD TWP.

17-03712

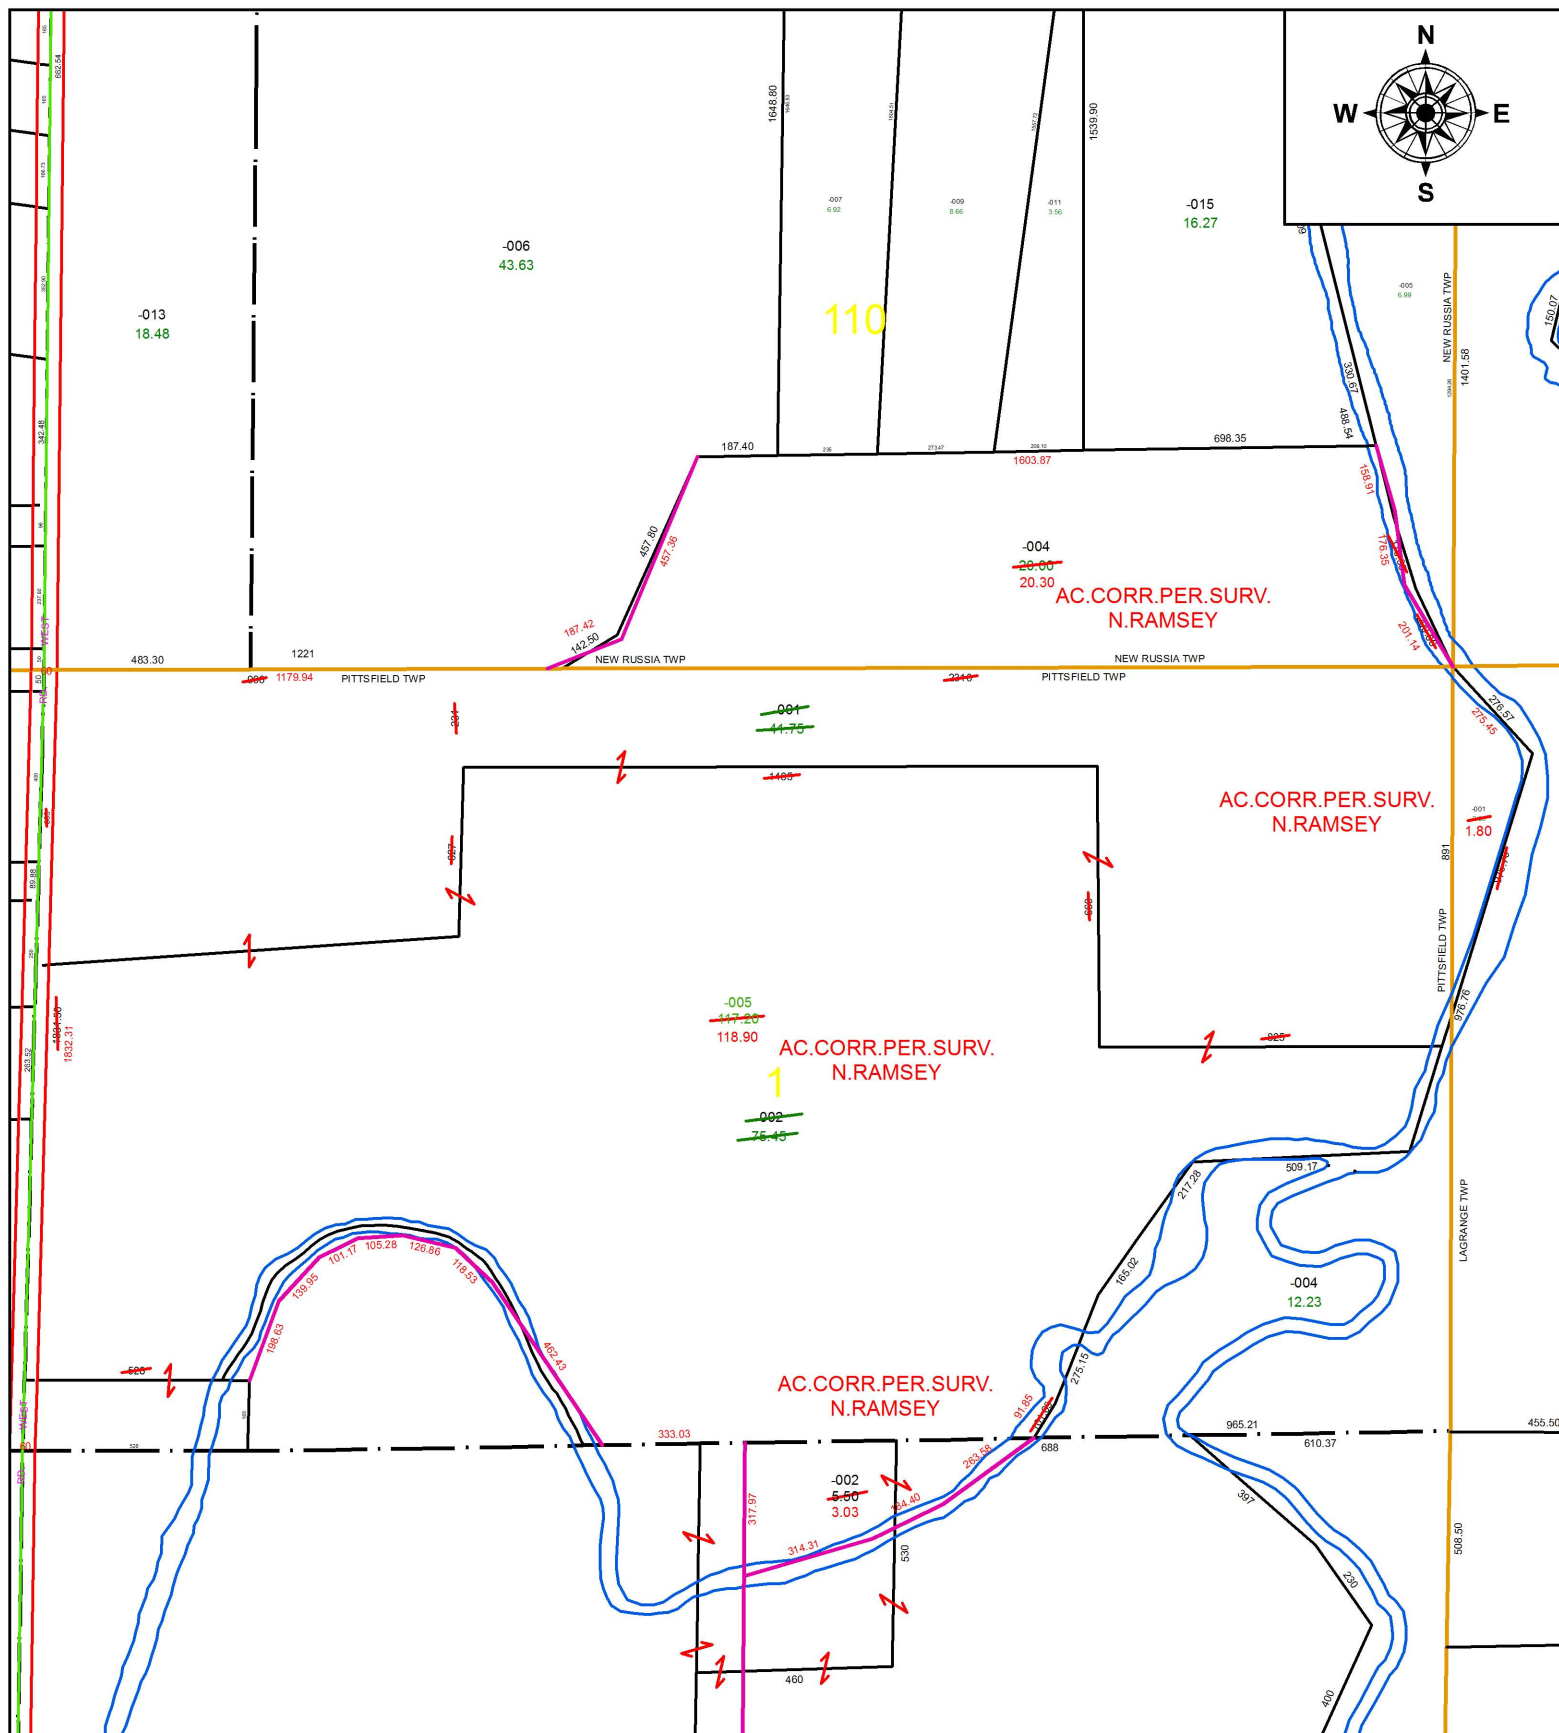

**SPLITS/DEEDS PROCESSED**  
 LORAIN COUNTY TAX MAP DEPARTMENT  
 226 MIDDLE AVE. ELYRIA, OH

**SURVEYED BY:** NATHAMIEL B. RAMSEY  
**CLOSURE:** 1: 1,594,417  
**MAP PAGE(S):** 9-H, 14-D, 15-A  
**APPROVED BY:** RRM **DATE:** 8-14-17  
**SCALE:** 1" = 450 **PRIOR INSTRUMENT:** 20150557413