


PARENT PARCEL: 09-00-107-000-013, -014

CHILD PARCEL: 09-00-107-000-023, -024

STARTING POINT: NORTHWEST CORNER OF O.L.107

17-03715

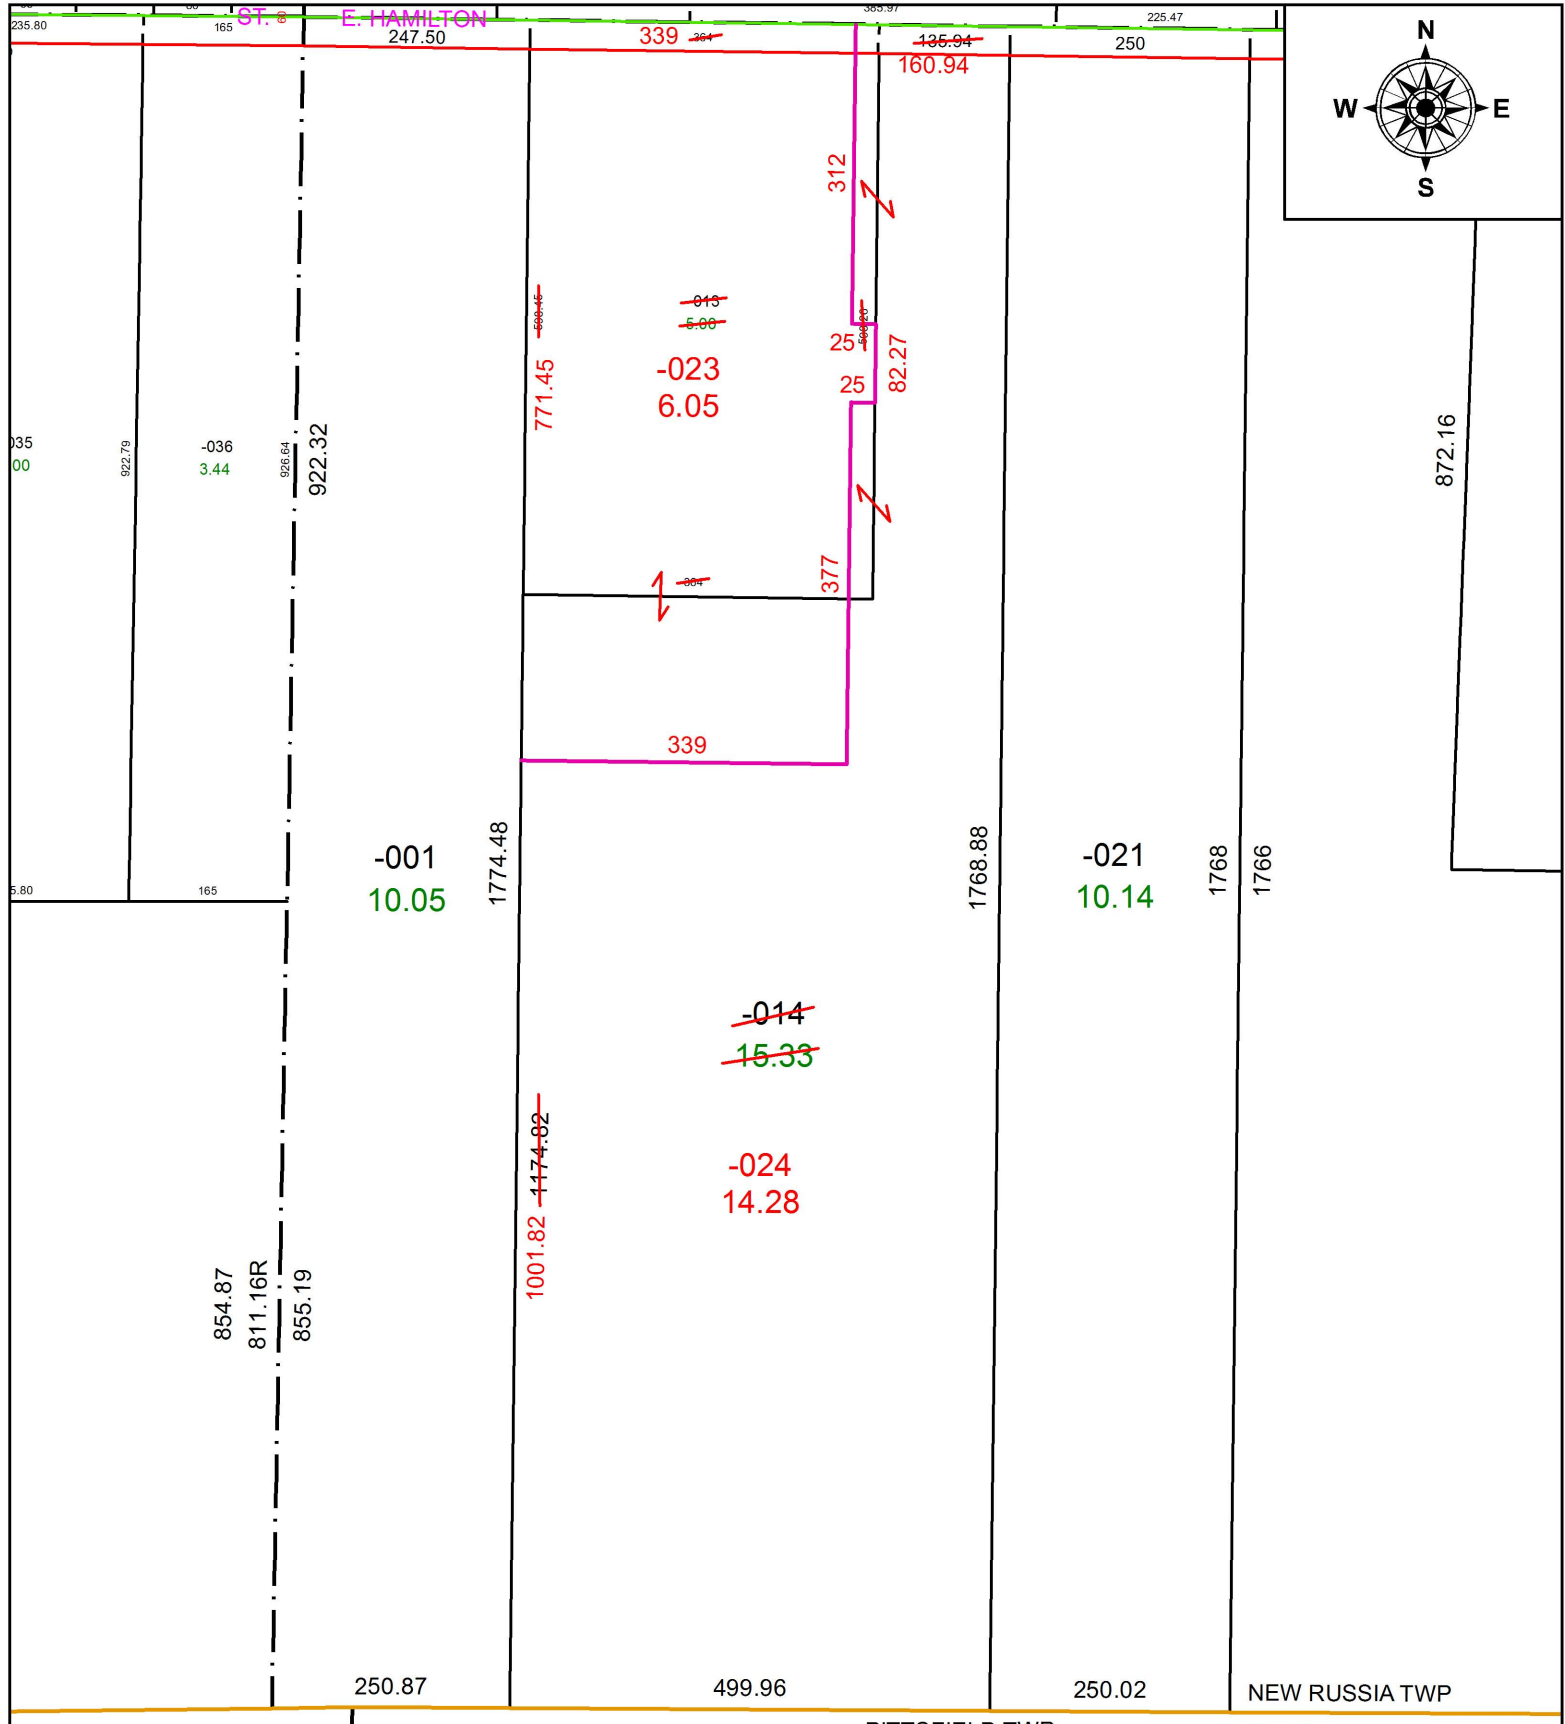

SPLITS/DEEDS PROCESSED
 LORAIN COUNTY TAX MAP DEPARTMENT
 226 MIDDLE AVE. ELYRIA, OH

SURVEYED BY: RICHARD J. KOLE
CLOSURE: 1: 73,883
MAP PAGE(S): 9-00-107
APPROVED BY: RRM **DATE:** 8-16-17
SCALE: 1" = 200 **PRIOR INSTRUMENT:** 20160603279