
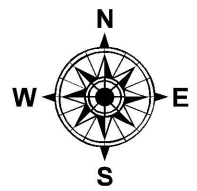


PARENT PARCEL: 03-00-004-000-080, 03-00-005-000-062

CHILD PARCEL: 03-00-004-000-082, -083, 03-00-005-000-062

STARTING POINT: INTERSECTION OF C/L OF FRENCH CREEK RD. AND EAST LINE OF O.L.5

17-03722

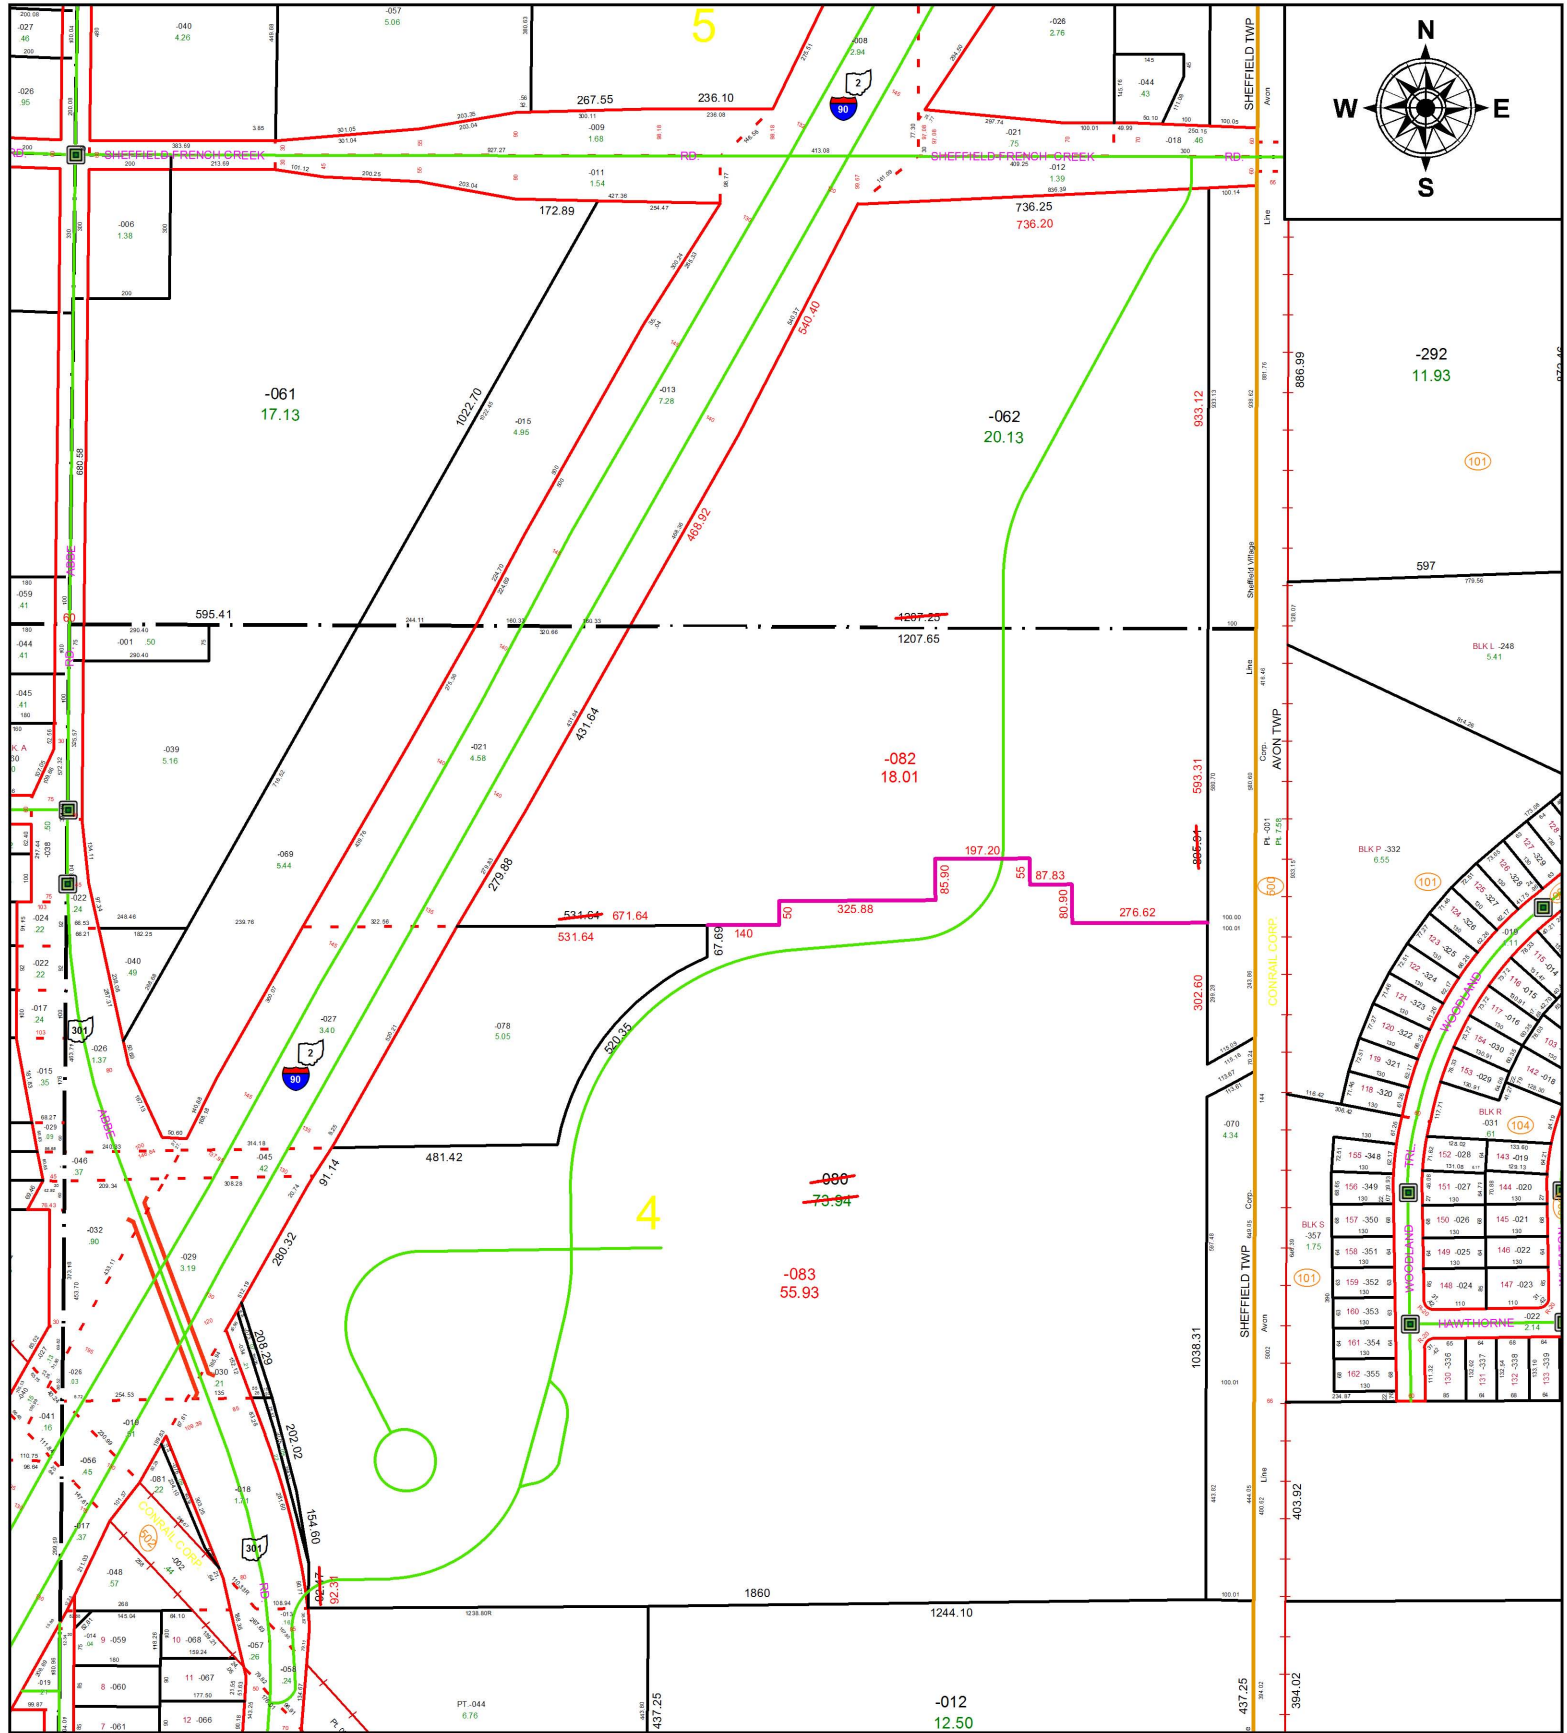

SPLITS/DEEDS PROCESSED

LORAIN COUNTY TAX MAP DEPARTMENT
226 MIDDLE AVE. ELYRIA, OH

SURVEYED BY: BRENT D. ANDERSON

CLOSURE: 1: 614,974

MAP PAGE(S): 3-00-004

APPROVED BY: RRM DATE: 8-31-17

SCALE: 1" = 400 PRIOR INSTRUMENT: 20160590574