



PARENT PARCEL: 02-02-020-102-013 & -015

CHILD PARCEL: MAP CORRECTION ONLY - PARCEL NUMBERS ON WRONG PARCELS

STARTING POINT: SURVEY BEFORE NEXT TRANSFER -012, -013, -015, & -016 DIM. DISCREPANCY

17-03725-C

102

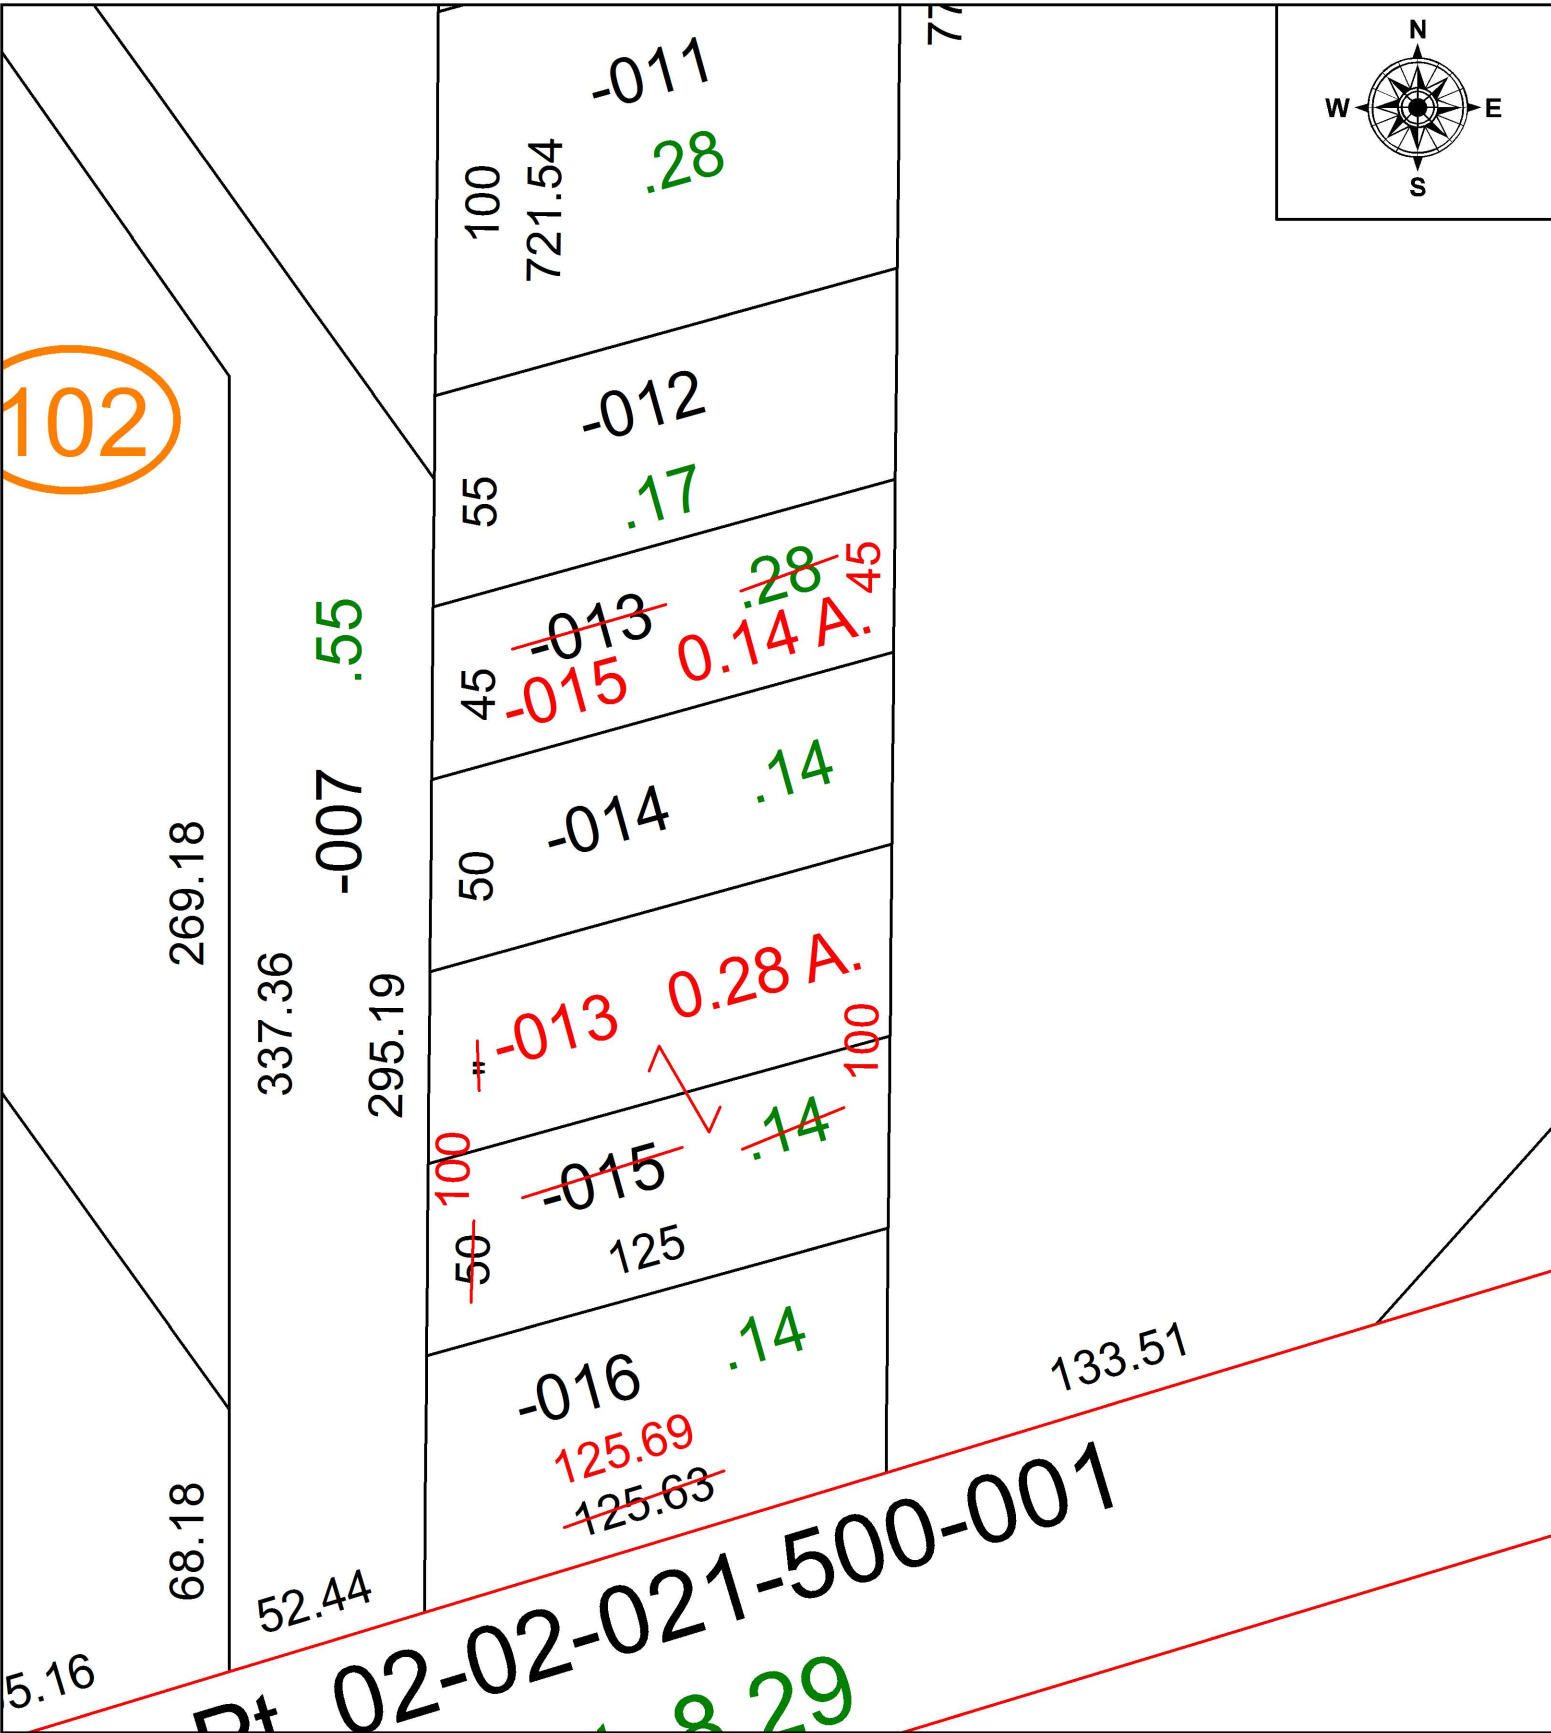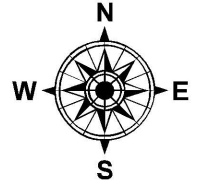

5.16

269.18

68.18

337.36

52.44

-007 .55

295.19

100  
721.54  
-011  
.28

55  
-012  
.17

45  
~~-013~~  
~~-015~~ 0.14 A. ~~.28~~ .45


50  
-014  
.14

50  
~~100~~  
~~-013~~ 0.28 A.  
~~-015~~ 125  
~~.14~~ 100

-016  
125.69  
125.63  
.14

133.51

Dt 02-02-021-500-001  
8 29

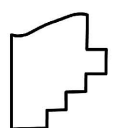

**SPLITS/DEEDS PROCESSED**  
LORAIN COUNTY TAX MAP DEPARTMENT  
226 MIDDLE AVE. ELYRIA, OH

SURVEYED BY: NA  
CLOSURE: NA  
MAP PAGE(S): 02-02-020  
APPROVED BY: TJS DATE: 8/9/17  
SCALE: 1" = 50' PRIOR INSTRUMENT: DV 707/348