


PARENT PARCEL: 15-00-098-108-174, -286

CHILD PARCEL: 15-00-098-108-174, -291, -292

STARTING POINT: NORTHEAST CORNER OF S/L 473 IN PHEASANT RUN VILLAGE PH.1

17-03727

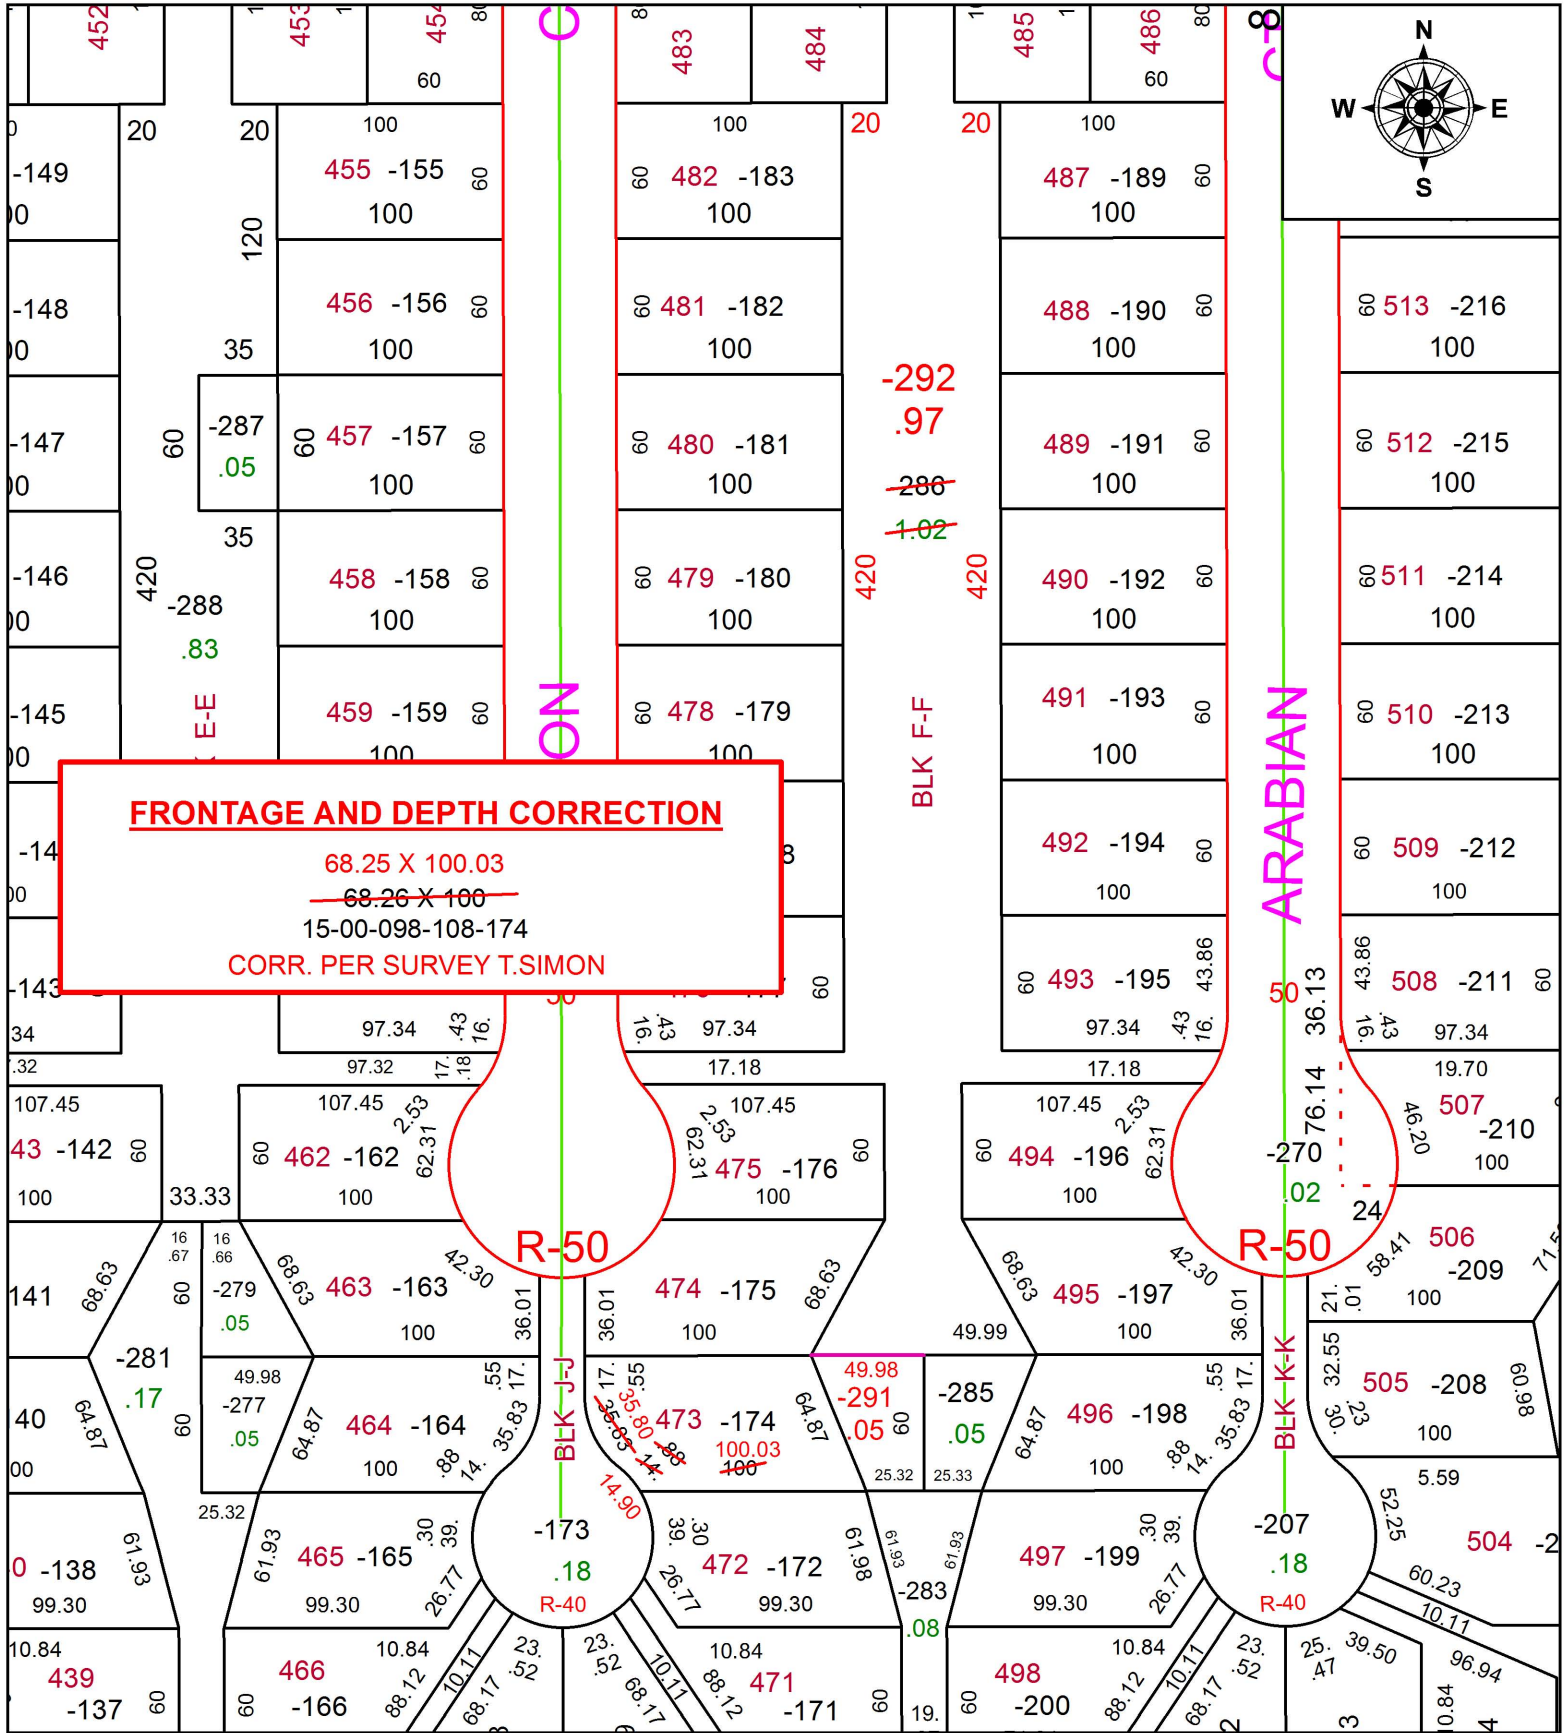

FRONTAGE AND DEPTH CORRECTION

68.25 X 100.03
~~68.26 X 100~~
 15-00-098-108-174
 CORR. PER SURVEY T.SIMON

SPLITS/DEEDS PROCESSED

LORAIN COUNTY TAX MAP DEPARTMENT
 226 MIDDLE AVE. ELYRIA, OH

SURVEYED BY: THOMAS A. SIMON
 CLOSURE: 1: 75,629
 MAP PAGE(S): 15-00-098
 APPROVED BY: RRM DATE: 9-19-17
 SCALE: 1" = 85 PRIOR INSTRUMENT: 20150554268