
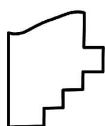


PARENT PARCEL: 11-00-082-000-039

CHILD PARCEL: XX-XX-XXX-XXX-XXX

STARTING POINT: 2"DISC, IN MON. BOX, CL OF S.R. 57 & CL OF NOVAK RD.

17-03732-C

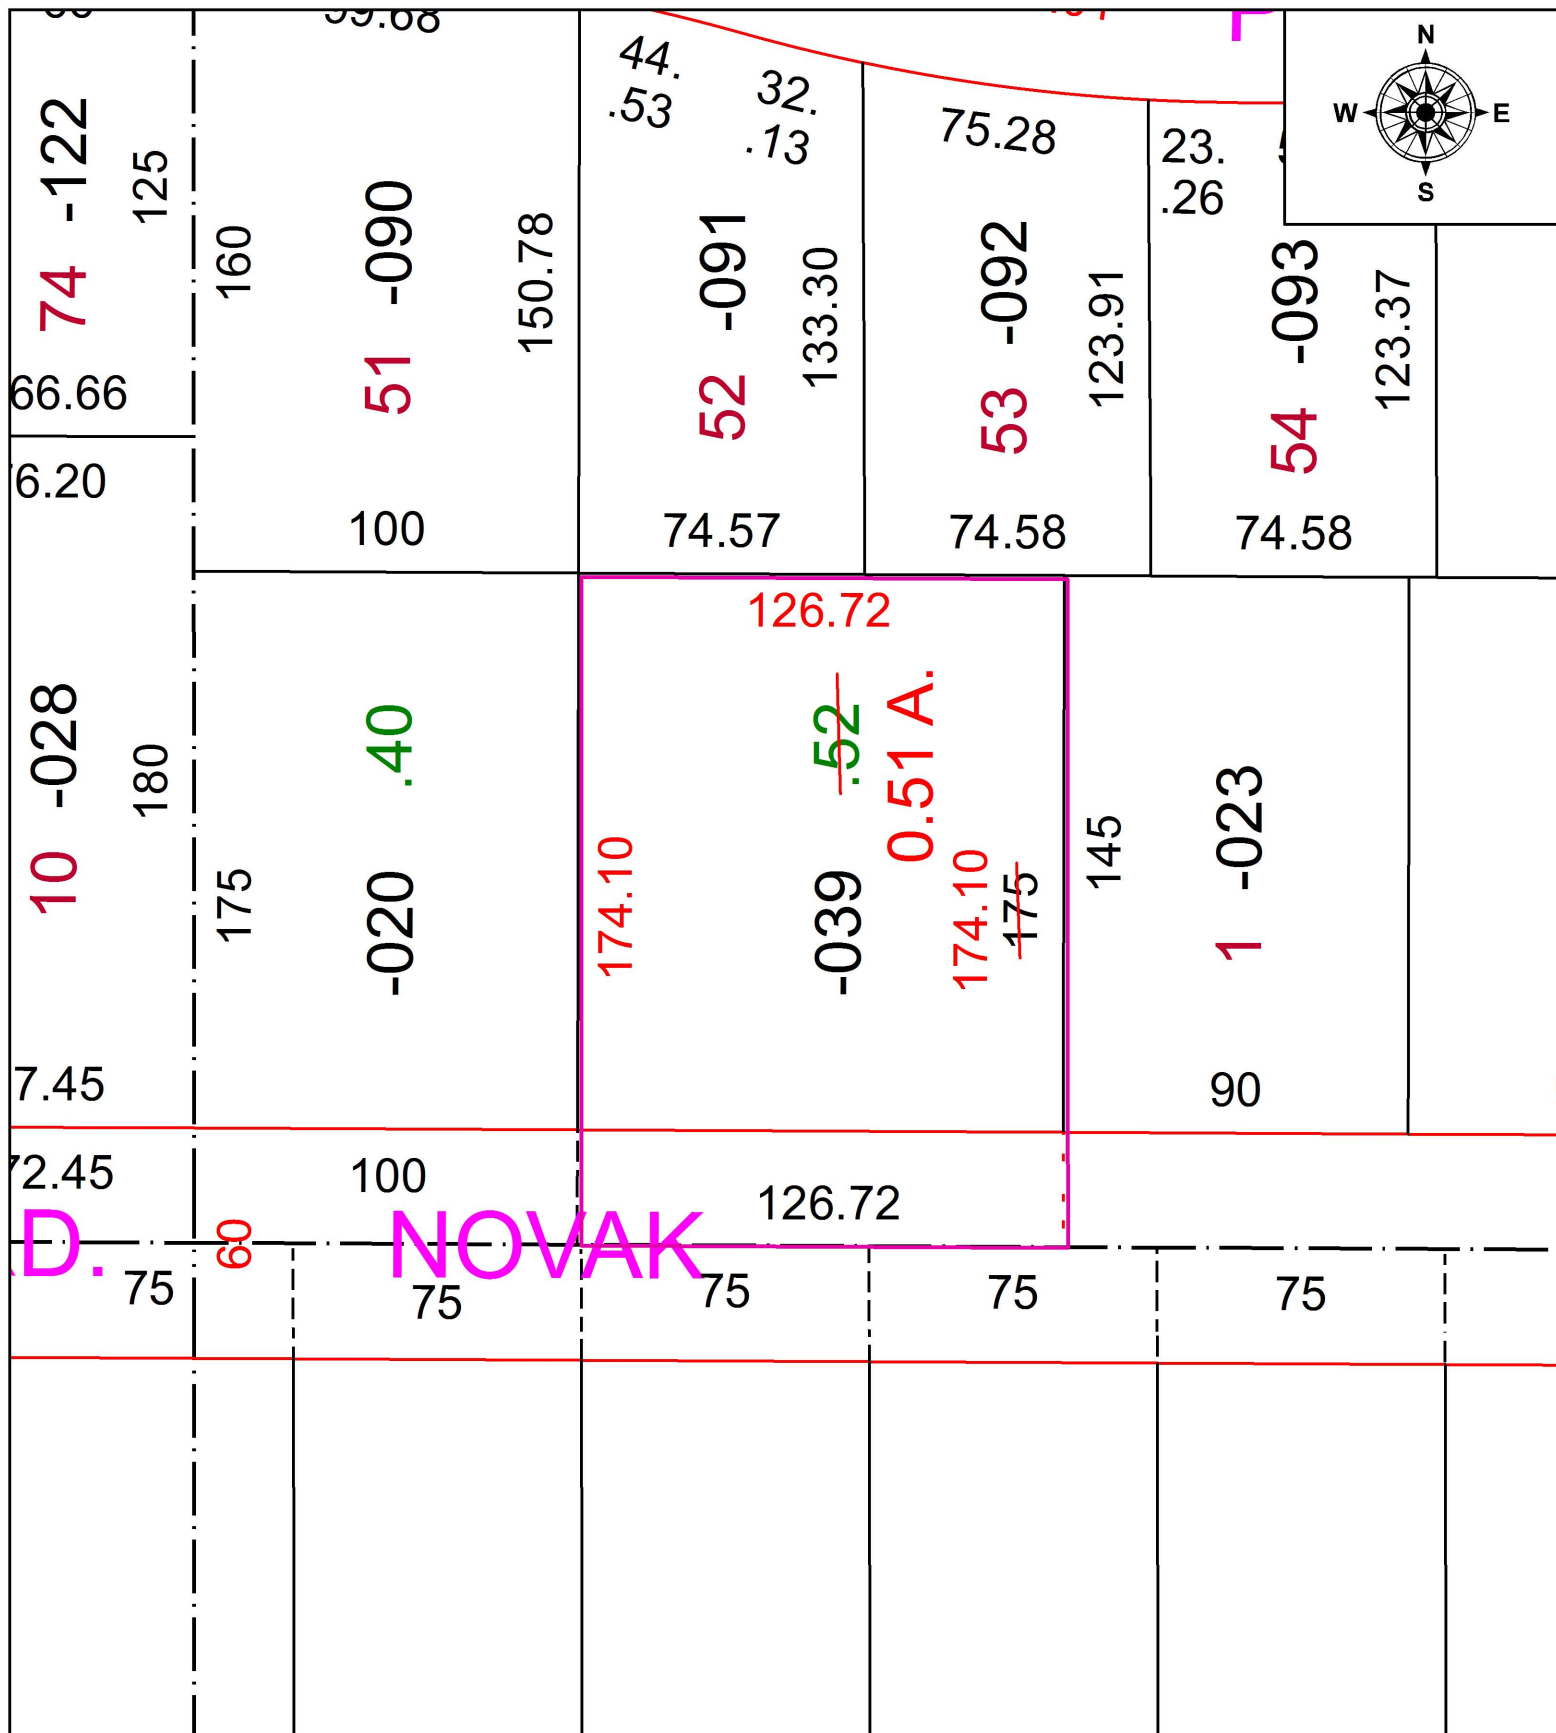

SPLITS/DEEDS PROCESSED
LORAIN COUNTY TAX MAP DEPARTMENT
226 MIDDLE AVE. ELYRIA, OH

SURVEYED BY: W.R. WALLACE
 CLOSURE: 1:489651
 MAP PAGE(S): 11-00-082
 APPROVED BY: TJS DATE: 8/24/17
 SCALE: 1" = 200 PRIOR INSTRUMENT: 2011-0379740