

PARENT PARCEL: 06-24-037-101-001, -002

CHILD PARCEL: 06-24-037-101-002, -013, -014

STARTING POINT: SOUTHWEST CORNER OF S/L 11 IN LAKE AVENUE ESTATES


17-03733



1236.62

330.25

~~254~~
254.48

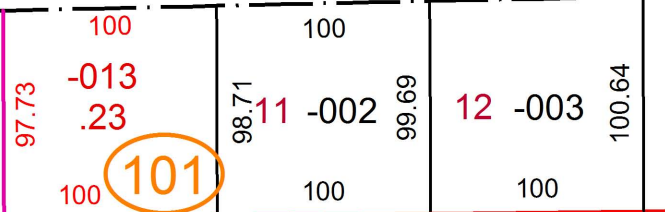

EARLENE

~~001~~
~~2.60~~
-014
~~2.37~~
2.42 AC.CORR.PER.SURV.
W.BARBOSA

49.14

100

100 10-001 100

9-00

101

479.40

479.40


102

-012
3.44

311.54

-011
1.71

311.54

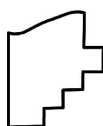

SPLITS/DEEDS PROCESSED
LORAIN COUNTY TAX MAP DEPARTMENT
226 MIDDLE AVE. ELYRIA, OH

SURVEYED BY: WILFREDO BARBOSA
CLOSURE: 1: 74,675
MAP PAGE(S): 6-42
APPROVED BY: RRM DATE: 10-5-17
SCALE: 1" = 90 PRIOR INSTRUMENT: 20060155308