


PARENT PARCEL: 12-00-046-000-018, -019

CHILD PARCEL: XX-XX-XXX-XXX-XXX

STARTING POINT: INTERSECTION OF EAST LINE OF COLUMBIA WEST RIVER RD. AND NORTH LINE OF BRIARWOOD LN

17-03736-C

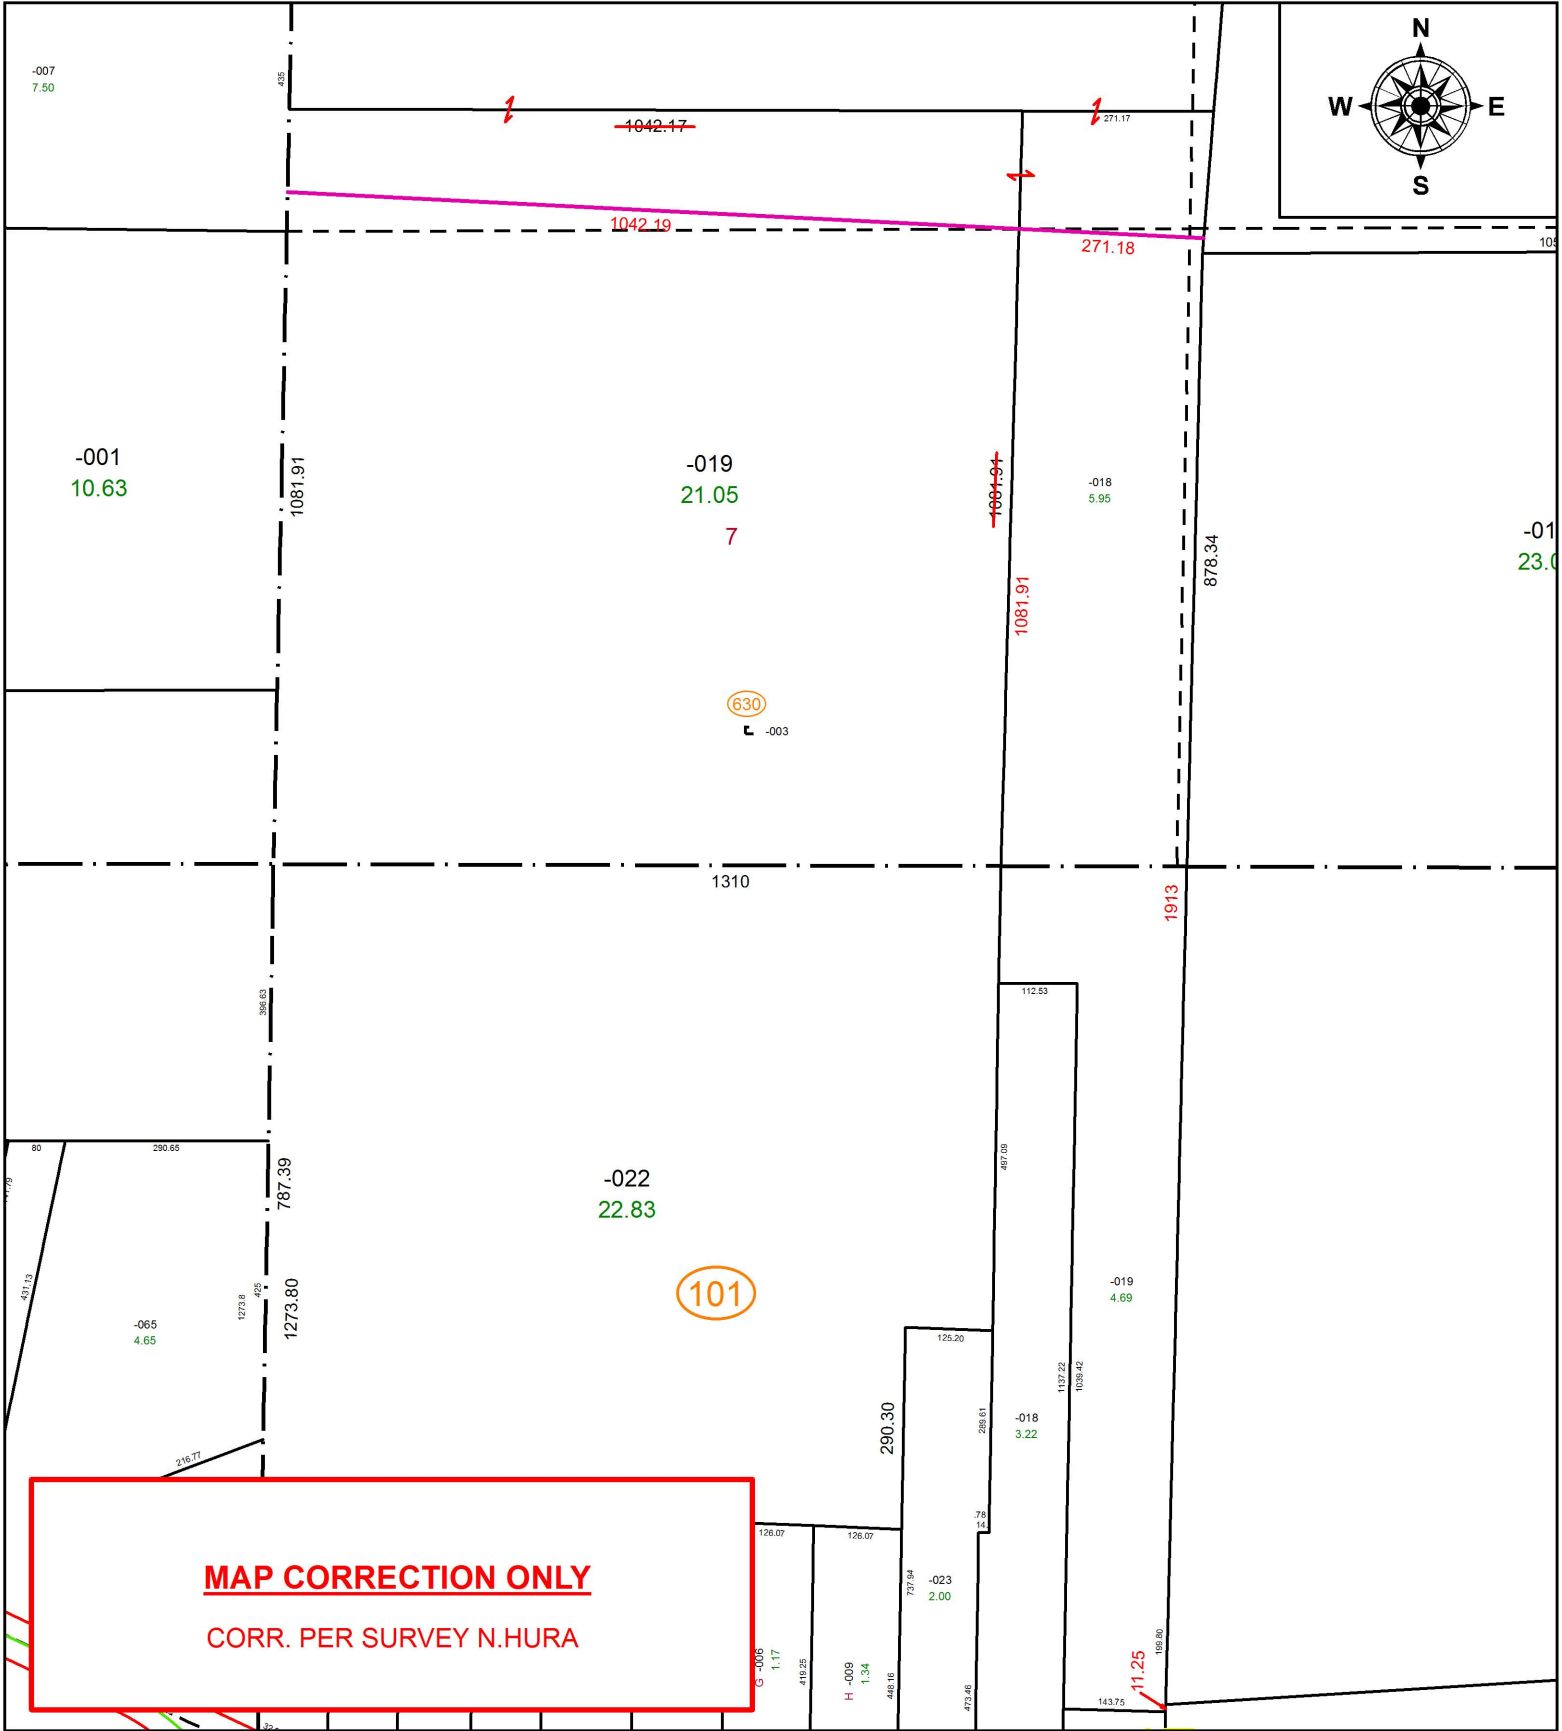

MAP CORRECTION ONLY
 CORR. PER SURVEY N.HURA

SPLITS/DEEDS PROCESSED
 LORAIN COUNTY TAX MAP DEPARTMENT
 226 MIDDLE AVE. ELYRIA, OH

SURVEYED BY: NORMAN R. HURA
 CLOSURE: N/A
 MAP PAGE(S): 12-00-046
 APPROVED BY: RRM DATE: 9-6-17
 SCALE: 1" = 275 PRIOR INSTRUMENT: 20170623174