
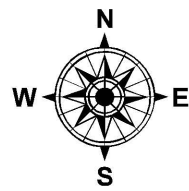


PARENT PARCEL: 05-00-021-103-001, -044

CHILD PARCEL: 05-00-021-103-095 THRU -097

STARTING POINT: INTERSECTION OF C/L OF KOLBE RD. AND C/L OF COOPER FOSTER PARK RD.

17-03739

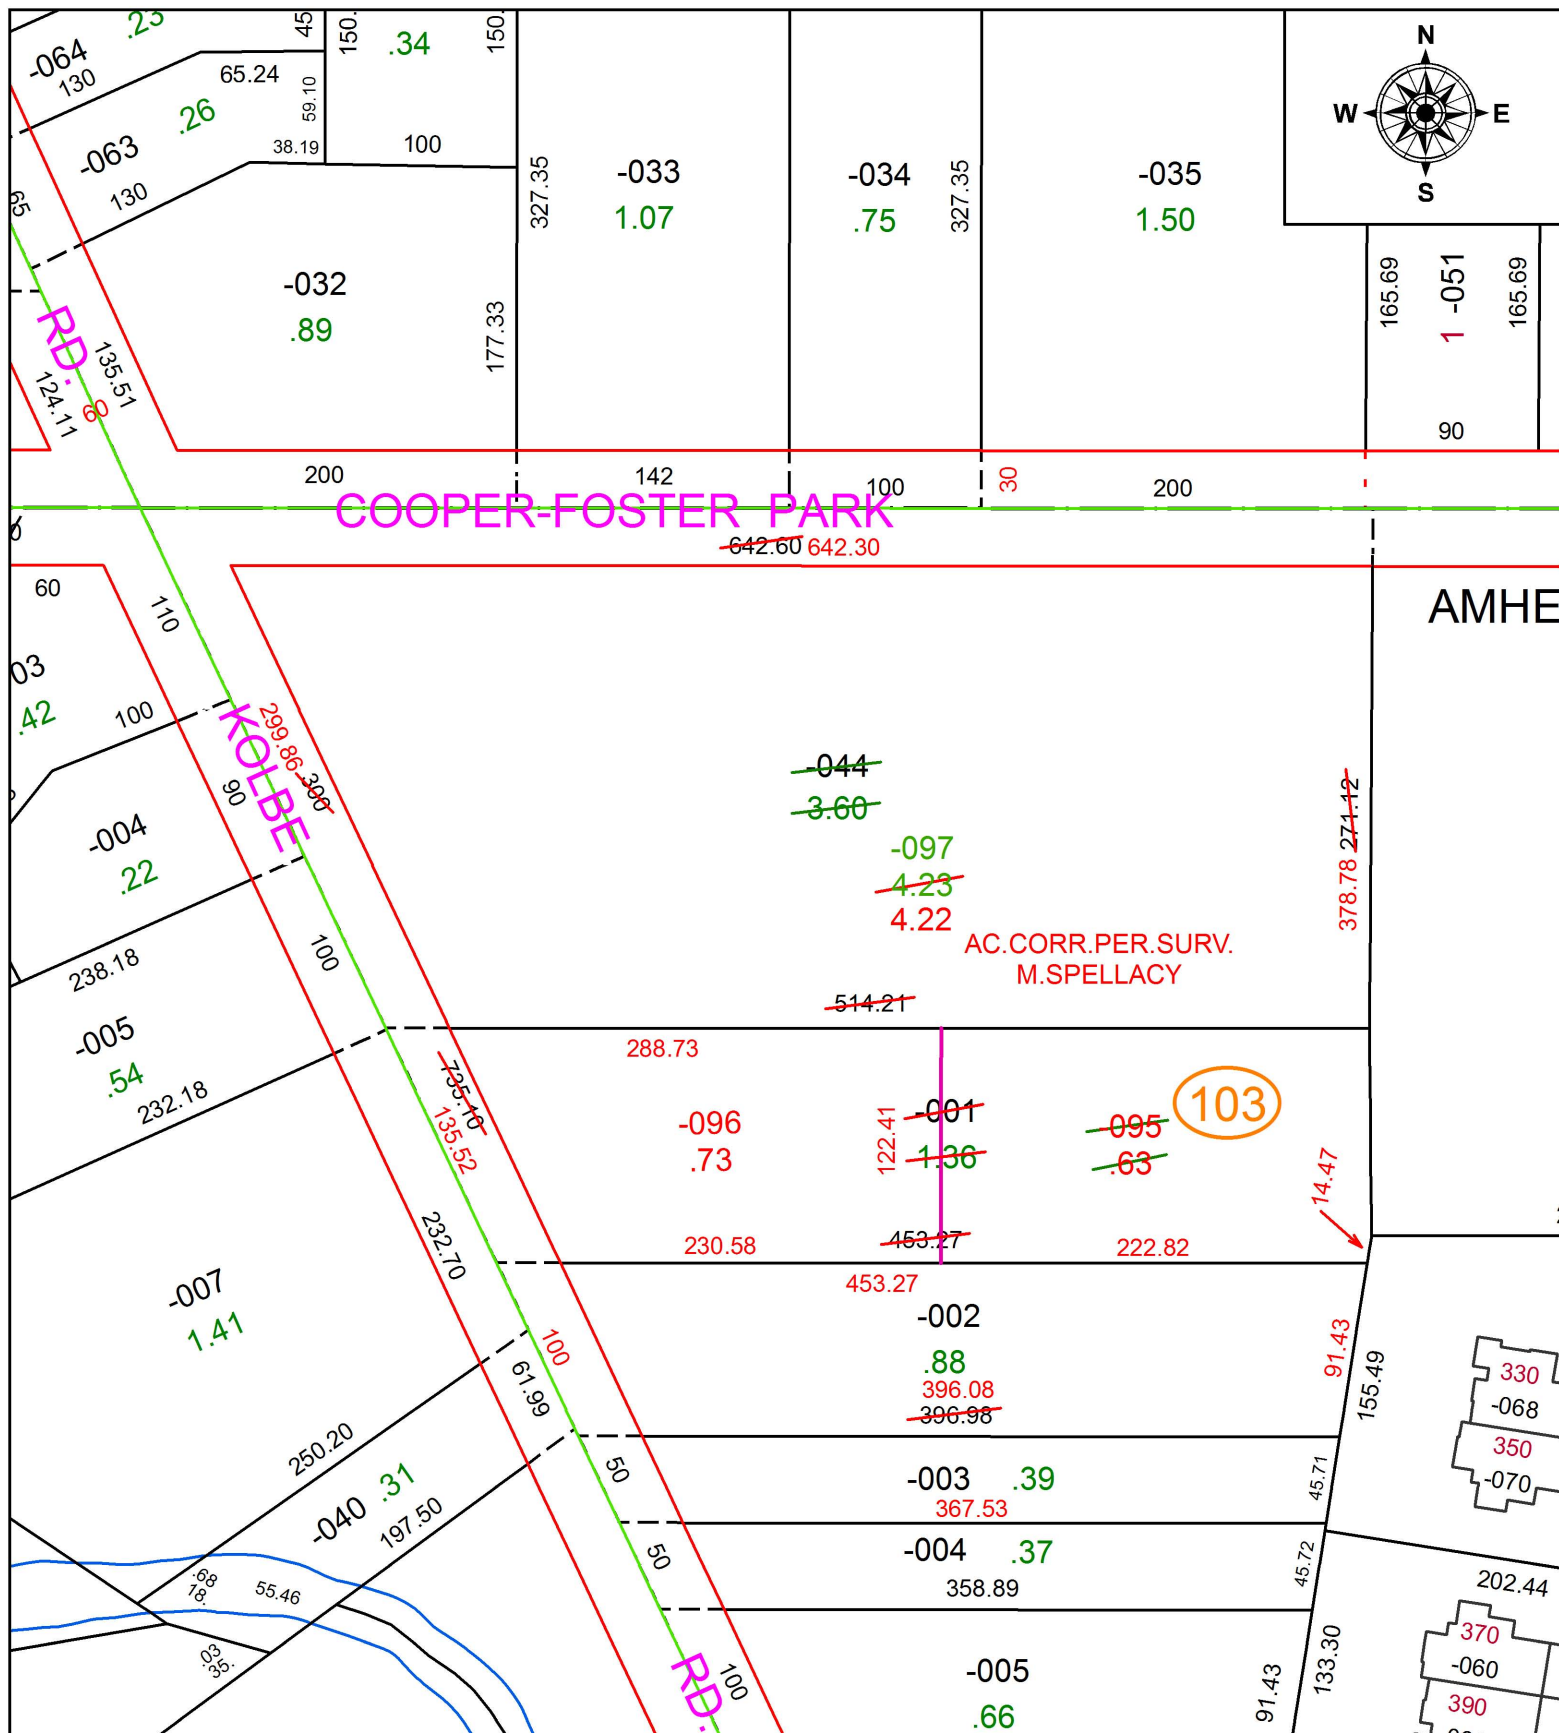

COOPER-FOSTER PARK


KOLBE RD.

KOLBE RD.

AMHE

103

AC. CORR. PER. SURV.
M. SPELLACY

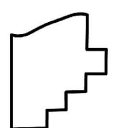

SPLITS/DEEDS PROCESSED
 LORAIN COUNTY TAX MAP DEPARTMENT
 226 MIDDLE AVE. ELYRIA, OH

SURVEYED BY: MICHAEL P. SPELLACY
 CLOSURE: 1: 76,305
 MAP PAGE(S): 5-00-021
 APPROVED BY: RRM DATE: 10-26-17
 SCALE: 1" = 100 PRIOR INSTRUMENT: 20060121419