
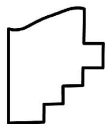


PARENT PARCEL: 06-23-016-102-038

CHILD PARCEL: 06-23-016-102-049 THRU -051

STARTING POINT: I.P. MON. BOX, CL OF GRISWOLD RD. & CL OF TILLOTSON & I.P. MON. BOX CL OF GRISWOLD RD. & CL OF MORAN ST.

17-03741

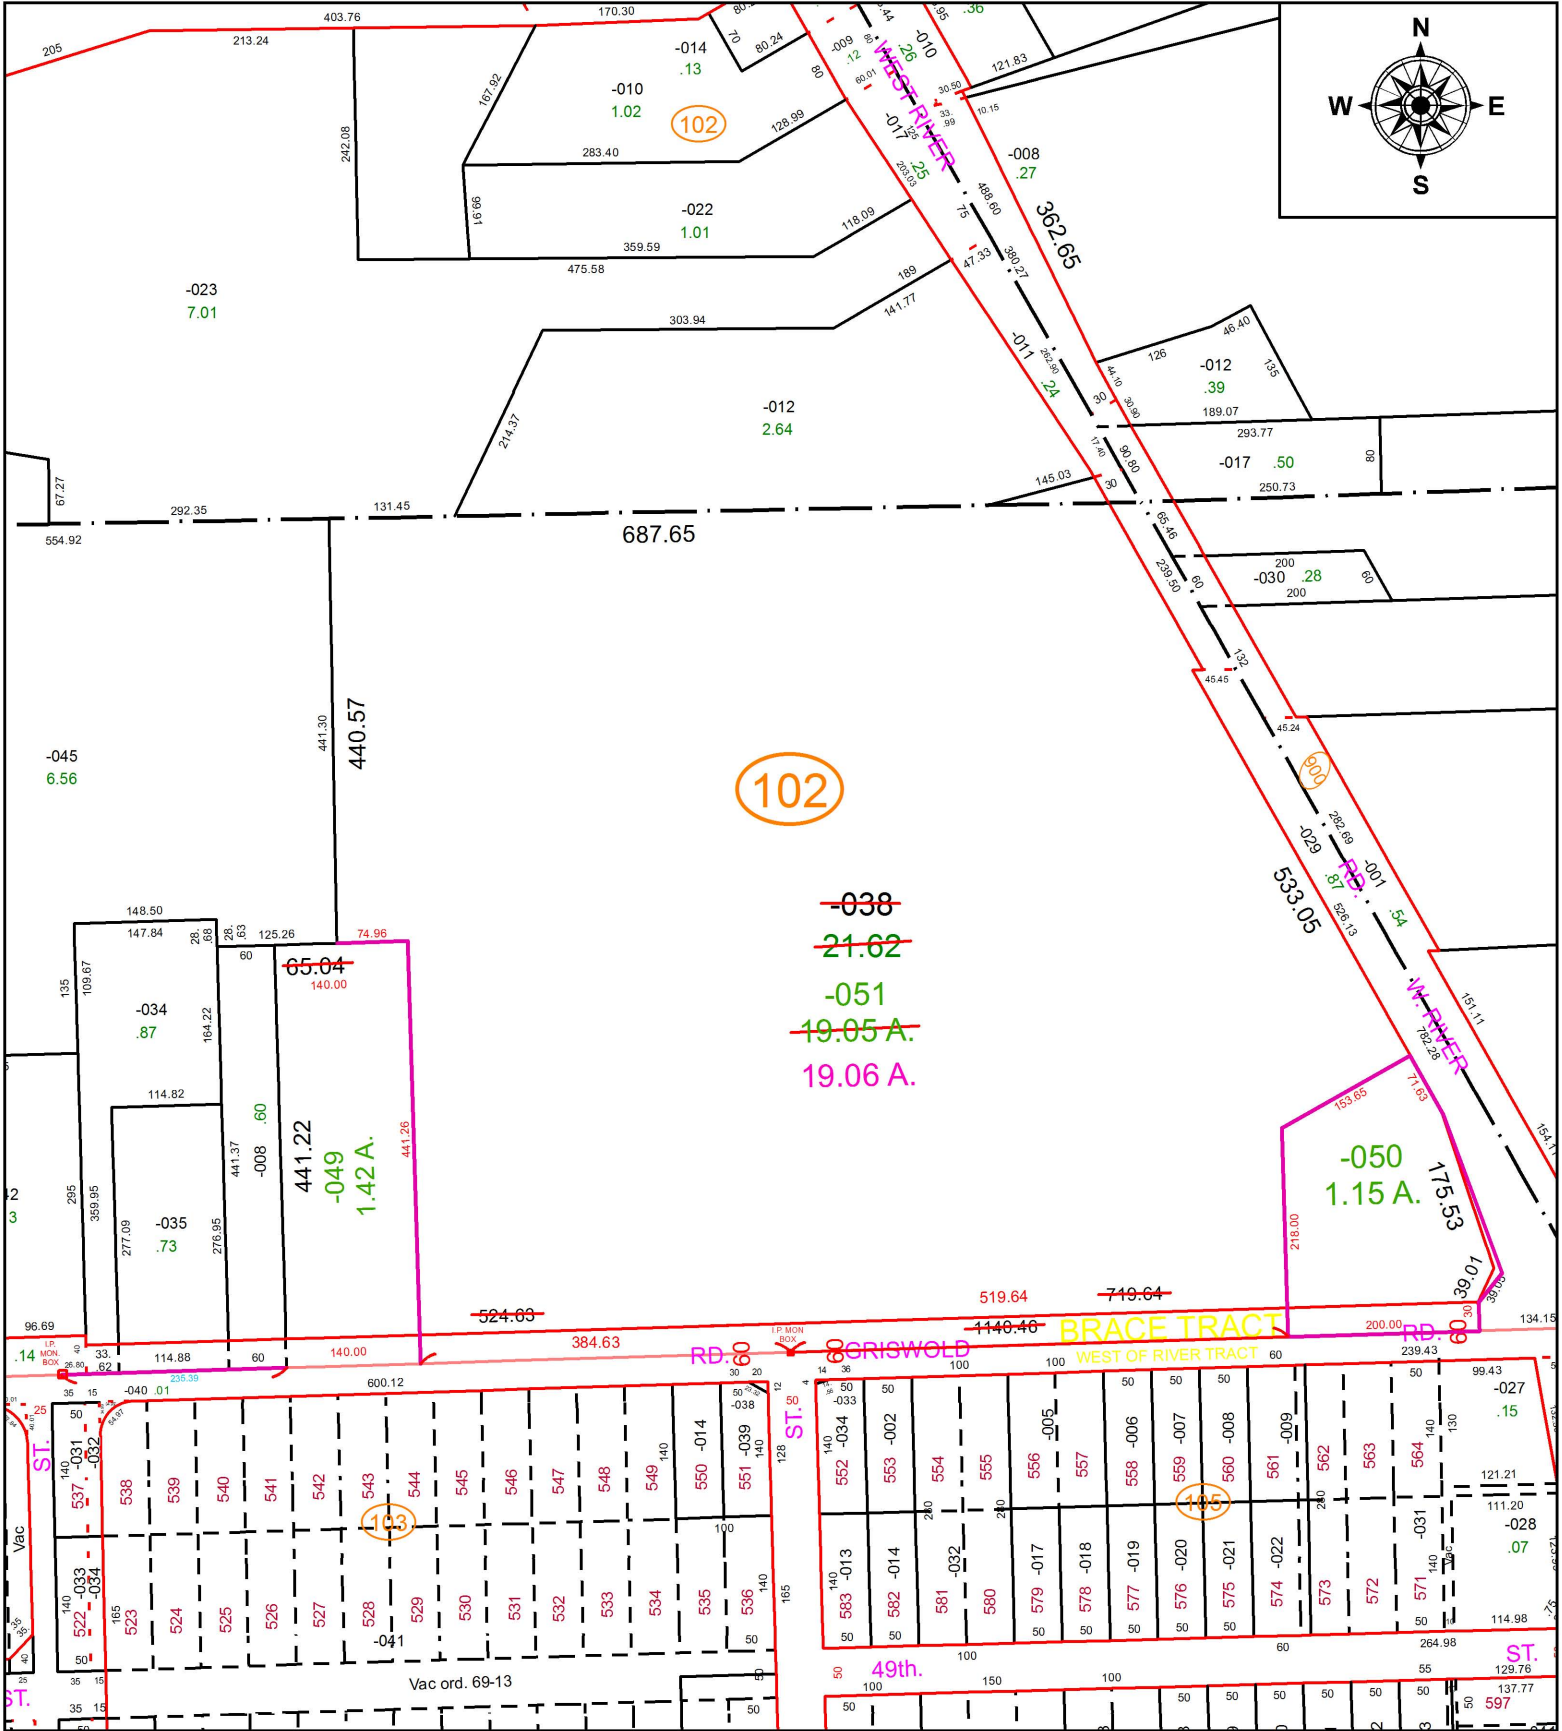

SPLITS/DEEDS PROCESSED
 LORAIN COUNTY TAX MAP DEPARTMENT
 226 MIDDLE AVE. ELYRIA, OH

SURVEYED BY: TEVOR A. BIXLER
 CLOSURE: 1: 33,000
 MAP PAGE(S): 06-23-016
 APPROVED BY: TJS DATE: 11/6/17
 SCALE: 1" = 200 PRIOR INSTRUMENT: 20170626998