
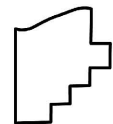


PARENT PARCEL: 04-00-020-104-485

CHILD PARCEL: XX-XX-XXX-XXX-XXX

STARTING POINT: INTERSECTION OF C/L OF LEAR-NAGLE RD. AND C/L OF DORCHESTER DR.

17-03743-A

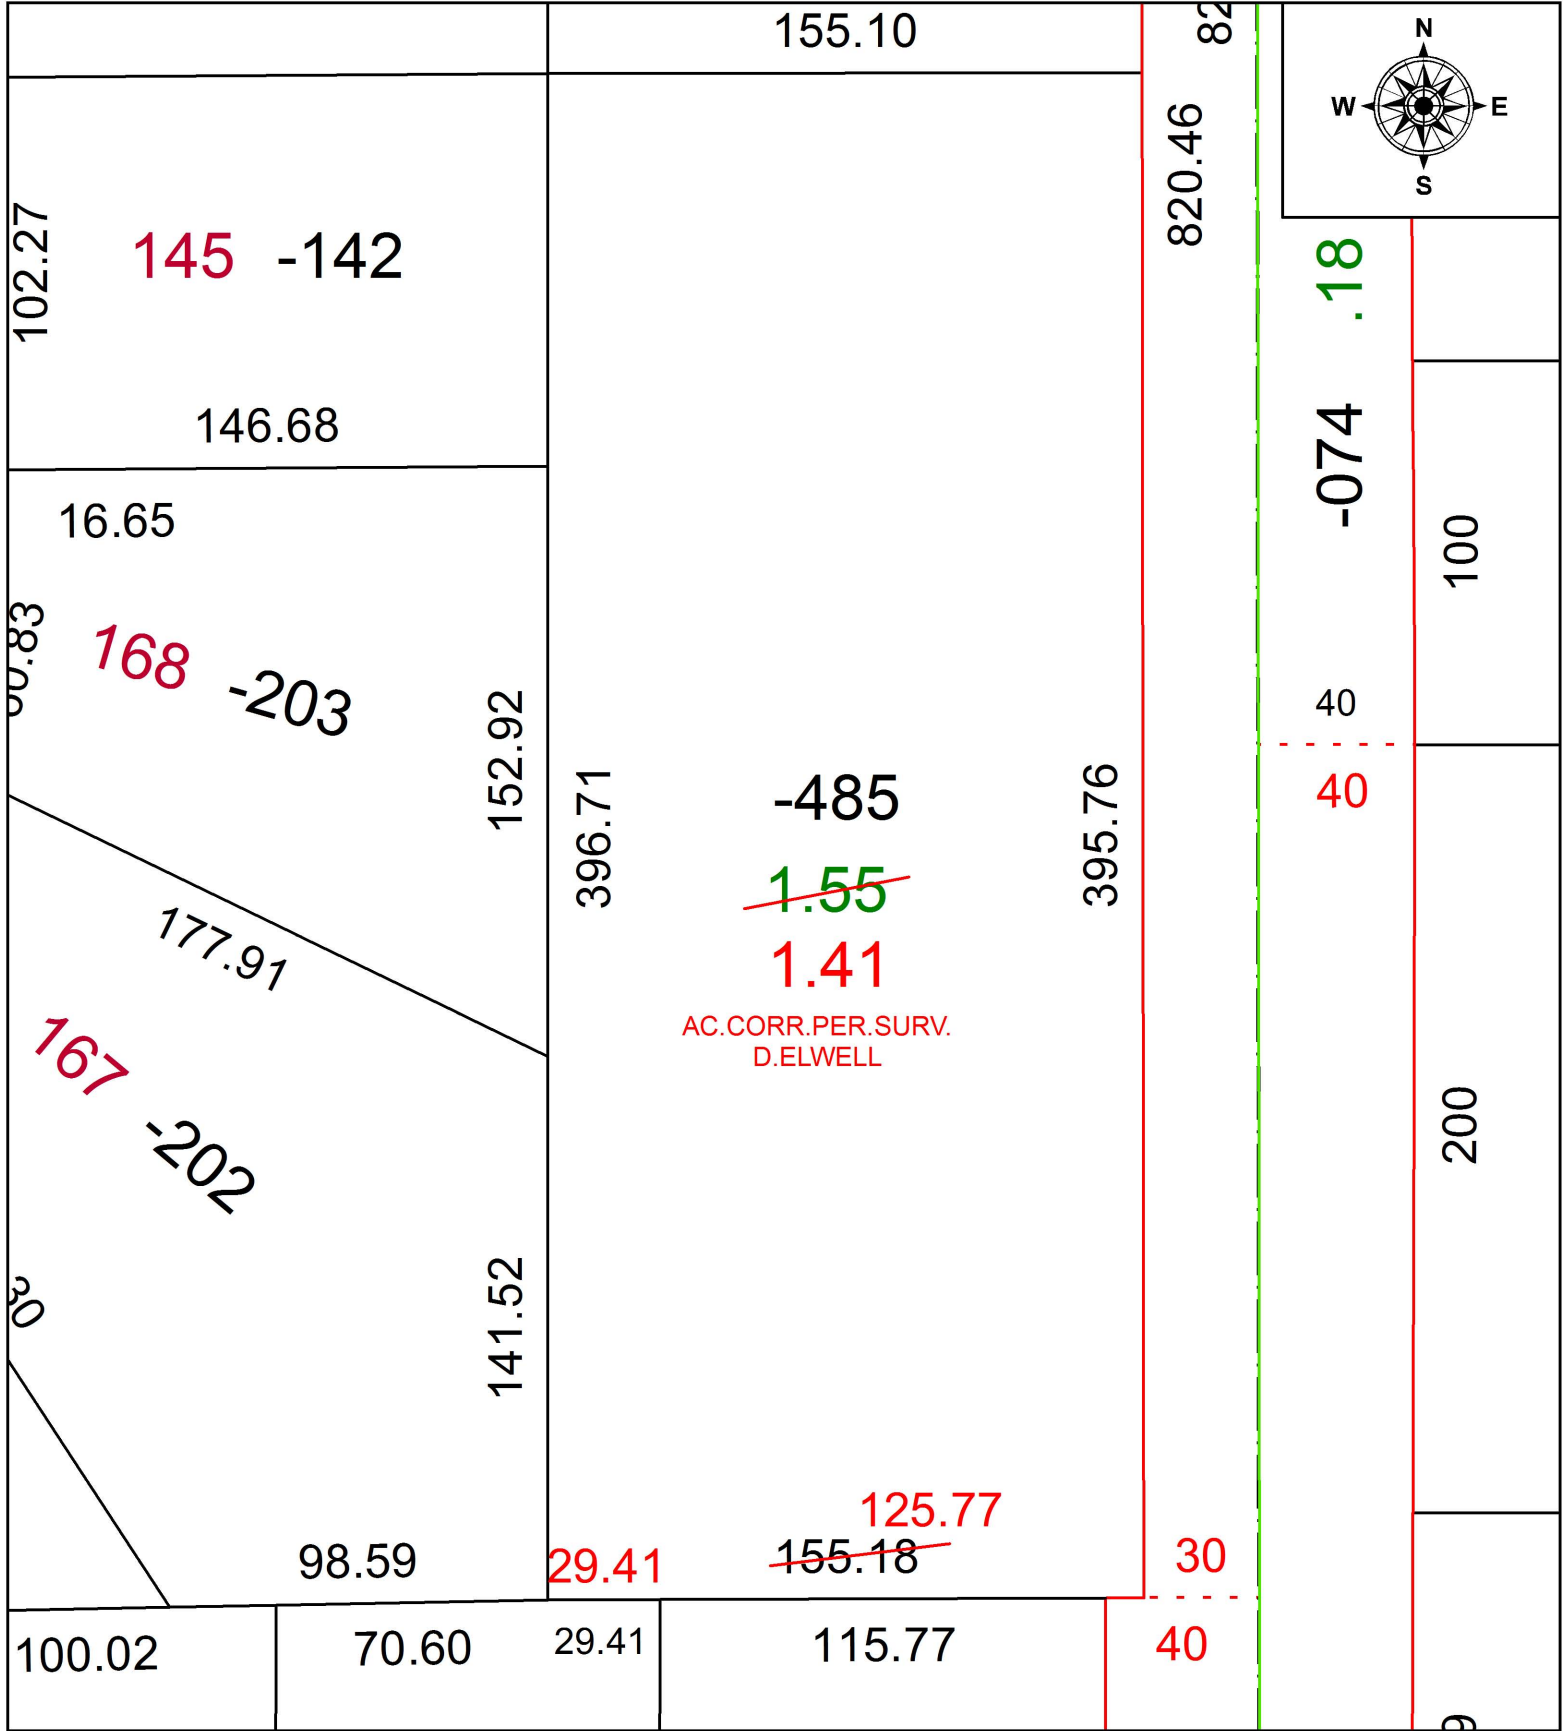

SPLITS/DEEDS PROCESSED
 LORAIN COUNTY TAX MAP DEPARTMENT
 226 MIDDLE AVE. ELYRIA, OH

SURVEYED BY: DAVID ELWELL
 CLOSURE: 1: 82,457
 MAP PAGE(S): 4-00-020
 APPROVED BY: RRM DATE: 9-14-17
 SCALE: 1" = 50 PRIOR INSTRUMENT: OR 526/837