


PARENT PARCEL: 02-01-006-111-001, -003

CHILD PARCEL: XX-XX-XXX-XXX-XXX

STARTING POINT: PARTS OF S/L'S 261 AND 262 IN DURANDS PLAT OF CHARLESTON (VOL.J PG.446)

17-03745-C

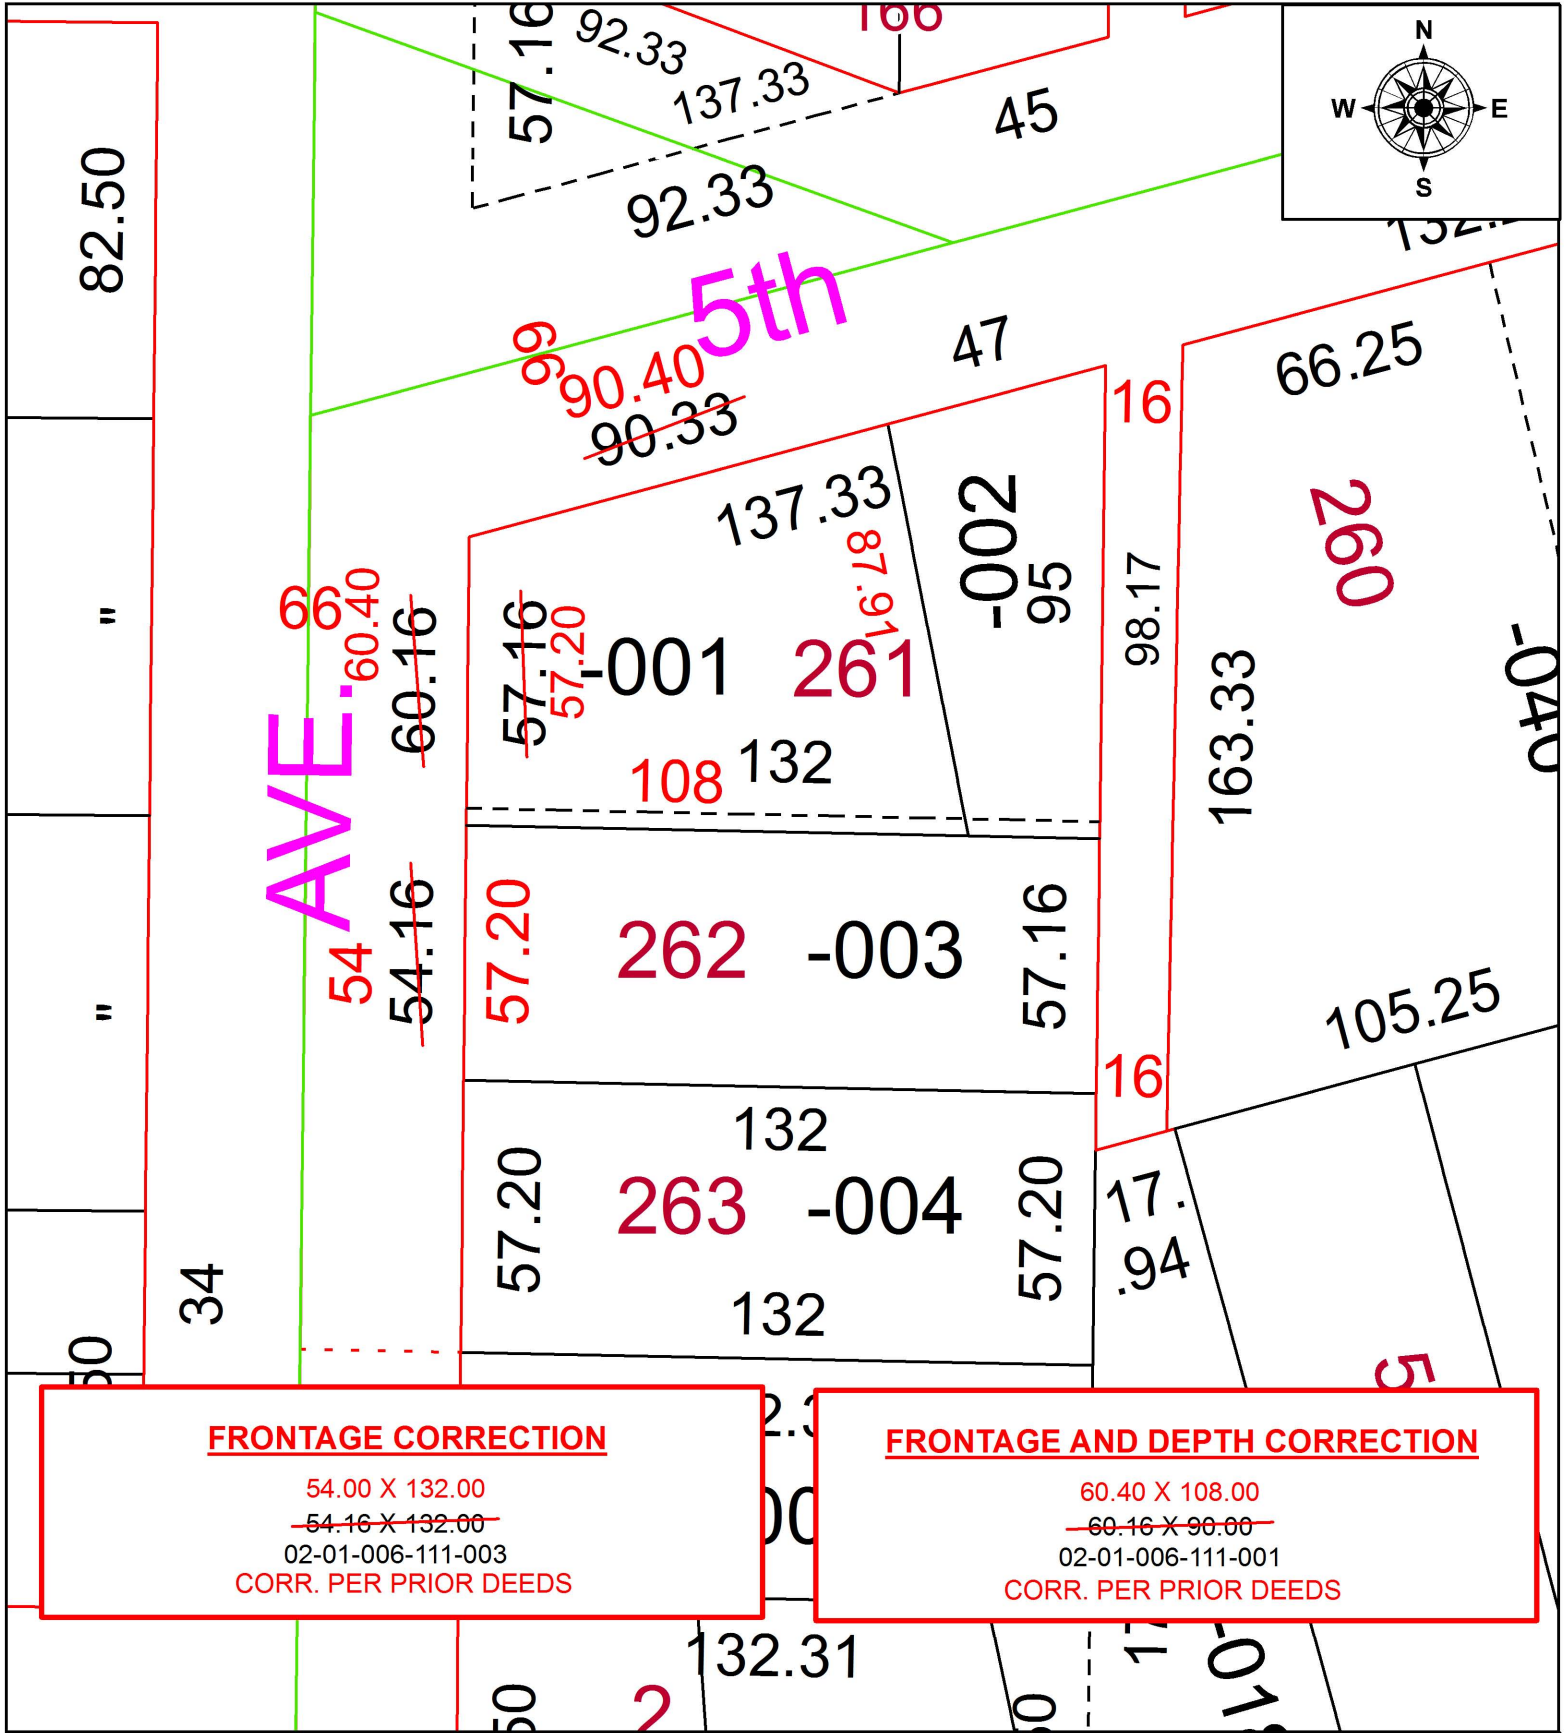


FRONTAGE CORRECTION

54.00 X 132.00
~~54.16 X 132.00~~
 02-01-006-111-003
 CORR. PER PRIOR DEEDS

FRONTAGE AND DEPTH CORRECTION

60.40 X 108.00
~~60.16 X 90.00~~
 02-01-006-111-001
 CORR. PER PRIOR DEEDS

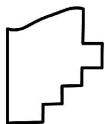

SPLITS/DEEDS PROCESSED
 LORAIN COUNTY TAX MAP DEPARTMENT
 226 MIDDLE AVE. ELYRIA, OH

SURVEYED BY: _____ N/A
 CLOSURE: _____ N/A
 MAP PAGE(S): _____ 2-01-006
 APPROVED BY: _____ RRM DATE: _____ 9-18-17
 SCALE: _____ 1" = 40 _____ PRIOR INSTRUMENT: _____ 20100343642