


PARENT PARCEL: 18-00-028-111-024, -025, -026, -029

CHILD PARCEL: XX-XX-XXX-XXX-XXX

STARTING POINT: SOUTHEAST CORNER OF S/L 23 IN D.J. JOHN'S ADD.(VOL.1 PG.36)

17-03747-C

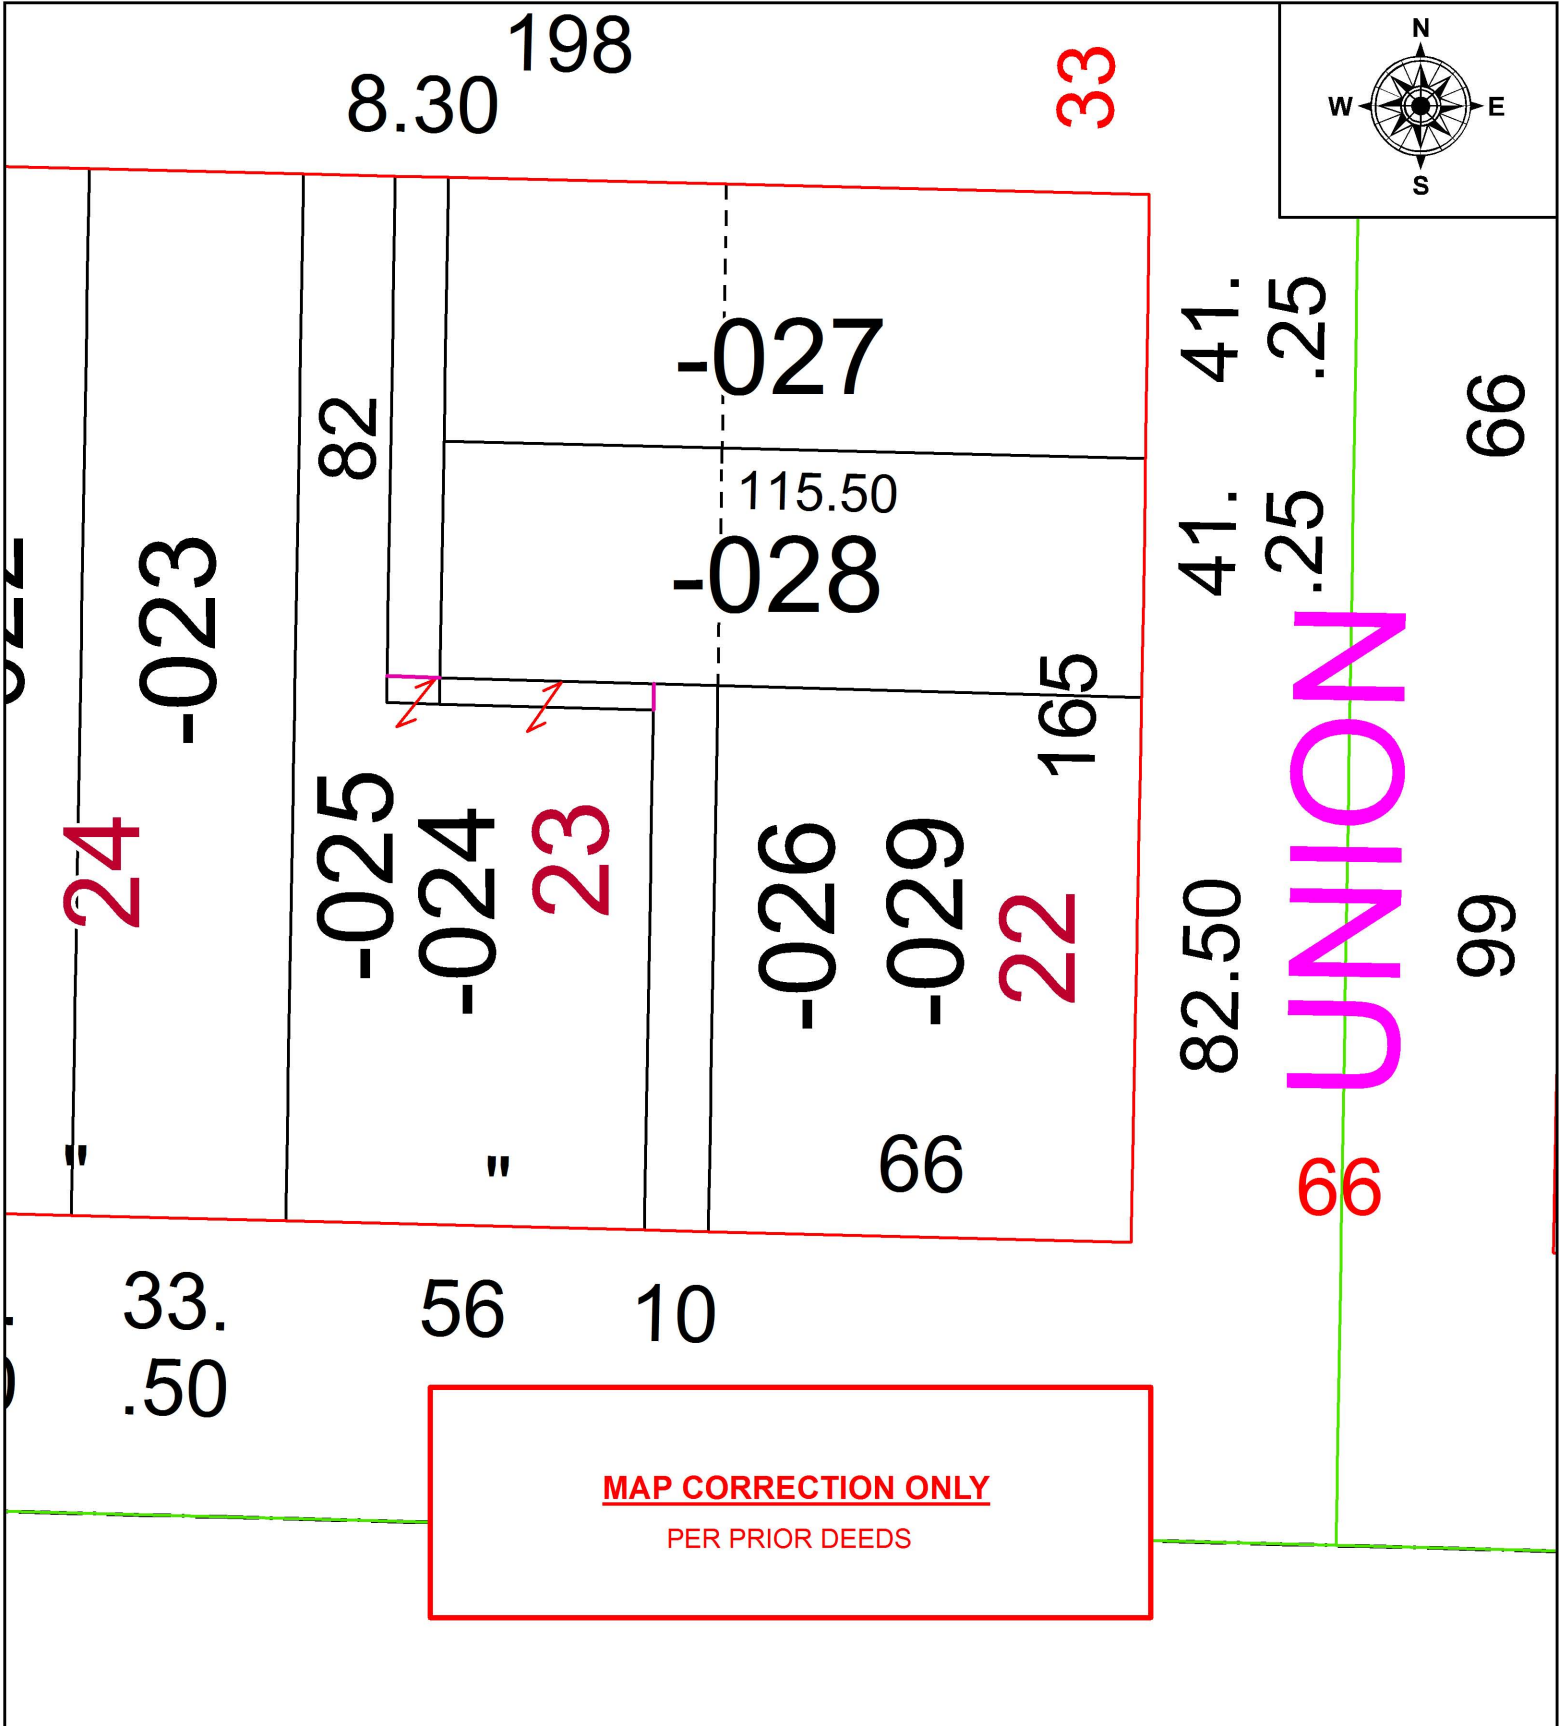

SPLITS/DEEDS PROCESSED
 LORAIN COUNTY TAX MAP DEPARTMENT
 226 MIDDLE AVE. ELYRIA, OH

SURVEYED BY: _____ N/A
 CLOSURE: _____ N/A
 MAP PAGE(S): _____ 18-00-028
 APPROVED BY: _____ RRM DATE: _____ 9-21-17
 SCALE: _____ 1" = 30 _____ PRIOR INSTRUMENT: _____ OR 1187/555