


PARENT PARCEL: 12-00-058-000-045

CHILD PARCEL: 12-00-058-630-001

STARTING POINT:

17-03753-G

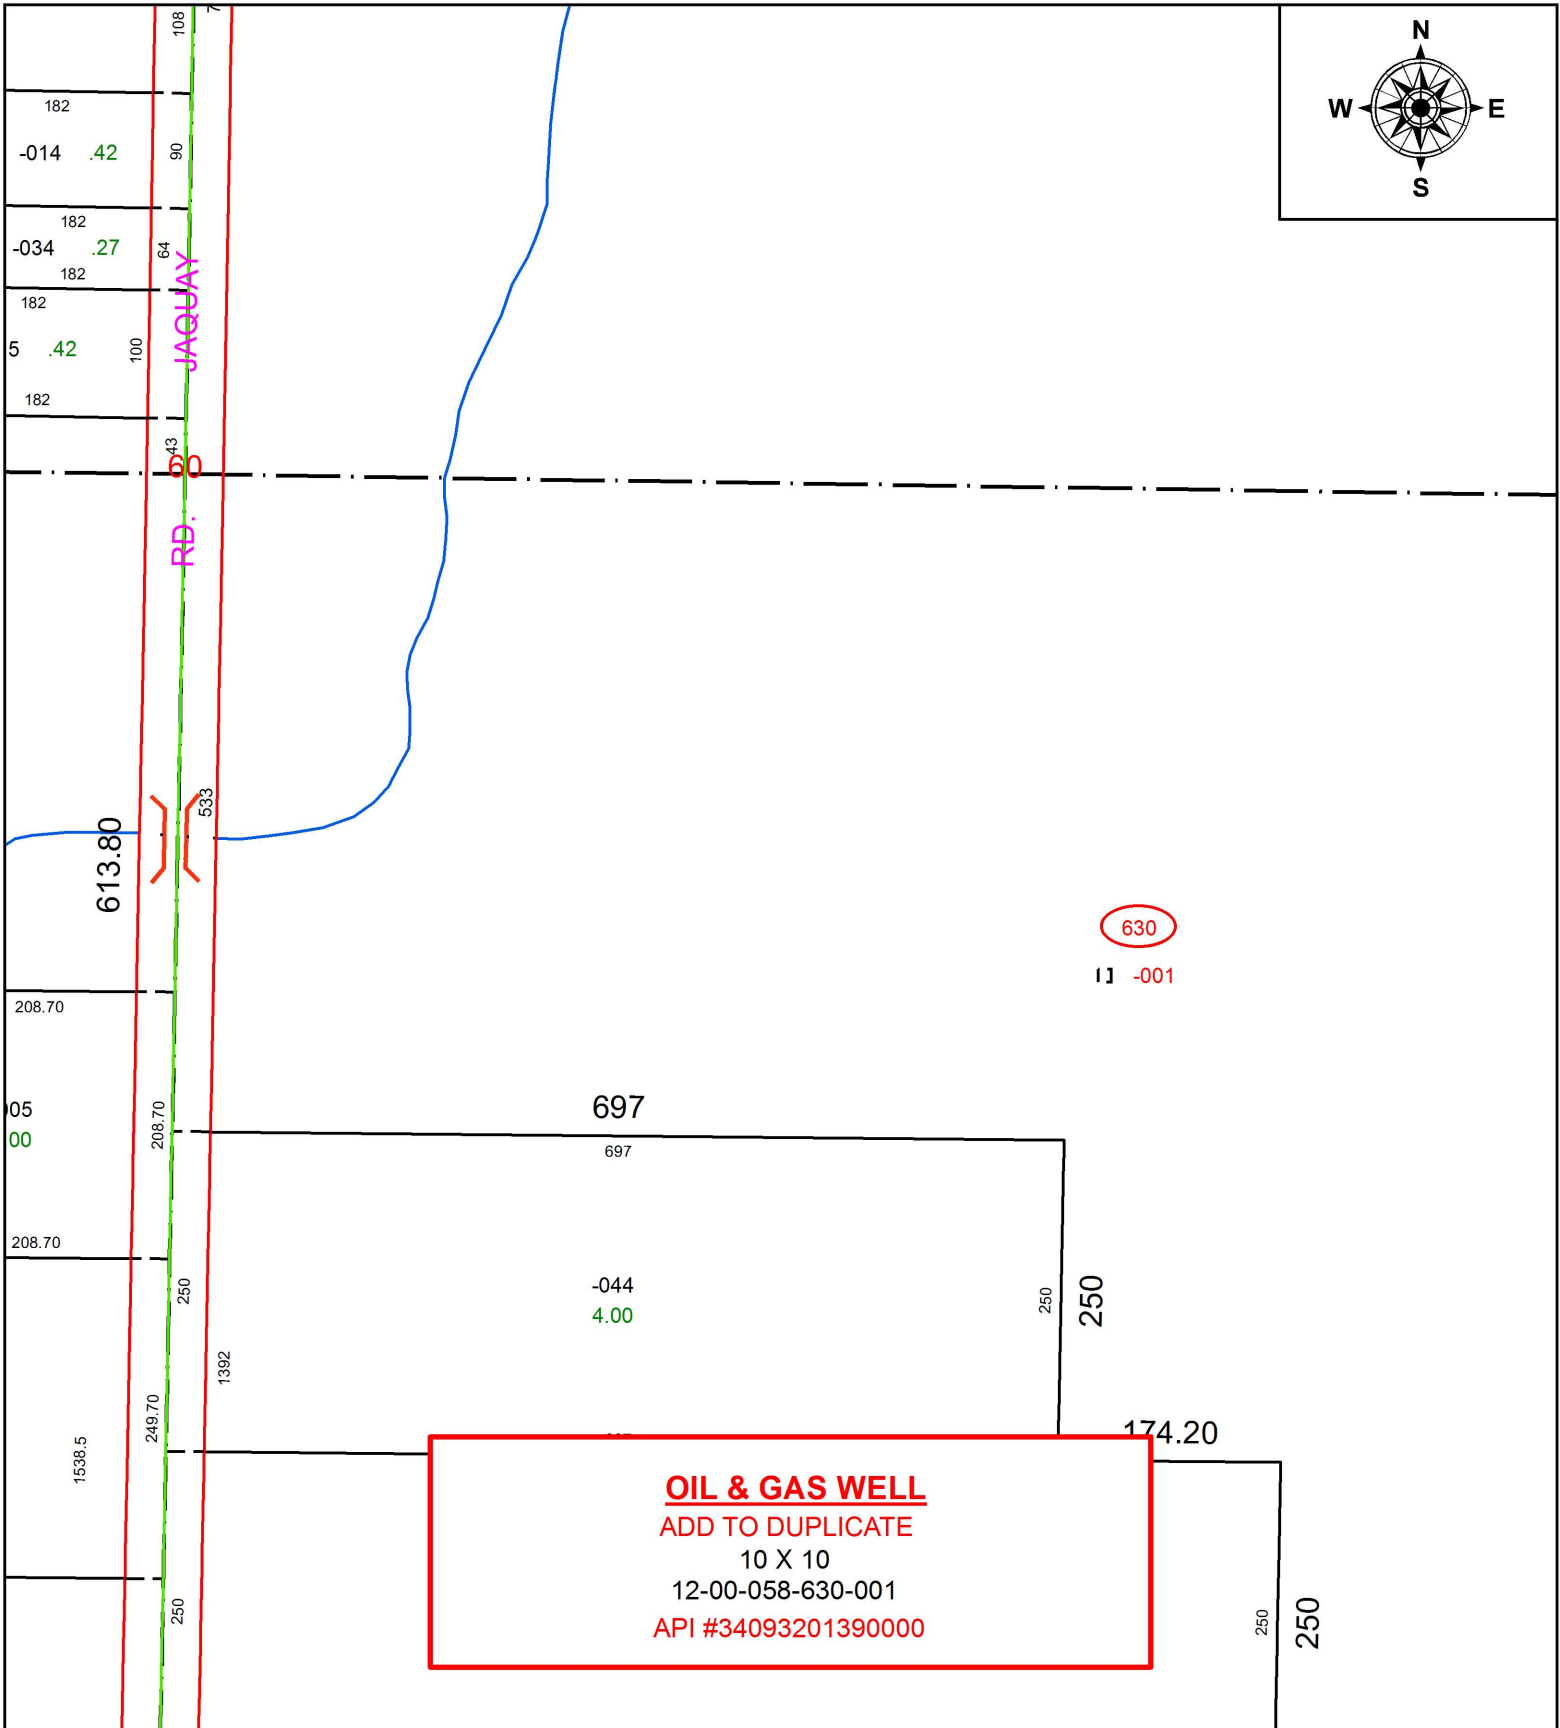

OIL & GAS WELL
 ADD TO DUPLICATE
 10 X 10
 12-00-058-630-001
 API #34093201390000



SPLITS/DEEDS PROCESSED
 LORAIN COUNTY TAX MAP DEPARTMENT
 226 MIDDLE AVE. ELYRIA, OH

SURVEYED BY: _____ N/A
 CLOSURE: _____ N/A
 MAP PAGE(S): _____ 12-00-058
 APPROVED BY: _____ RRM DATE: _____ 9-25-17
 SCALE: _____ 1" = 150 PRIORITY INSTRUMENT: _____ N/A