
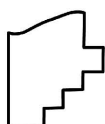


PARENT PARCEL: 01-00-004-129-056, 01-00-013-000-056, -057

CHILD PARCEL: 01-00-004-129-056, 01-00-013-000-072

STARTING POINT: NORTHEAST CORNER OF O.L.13

17-03756

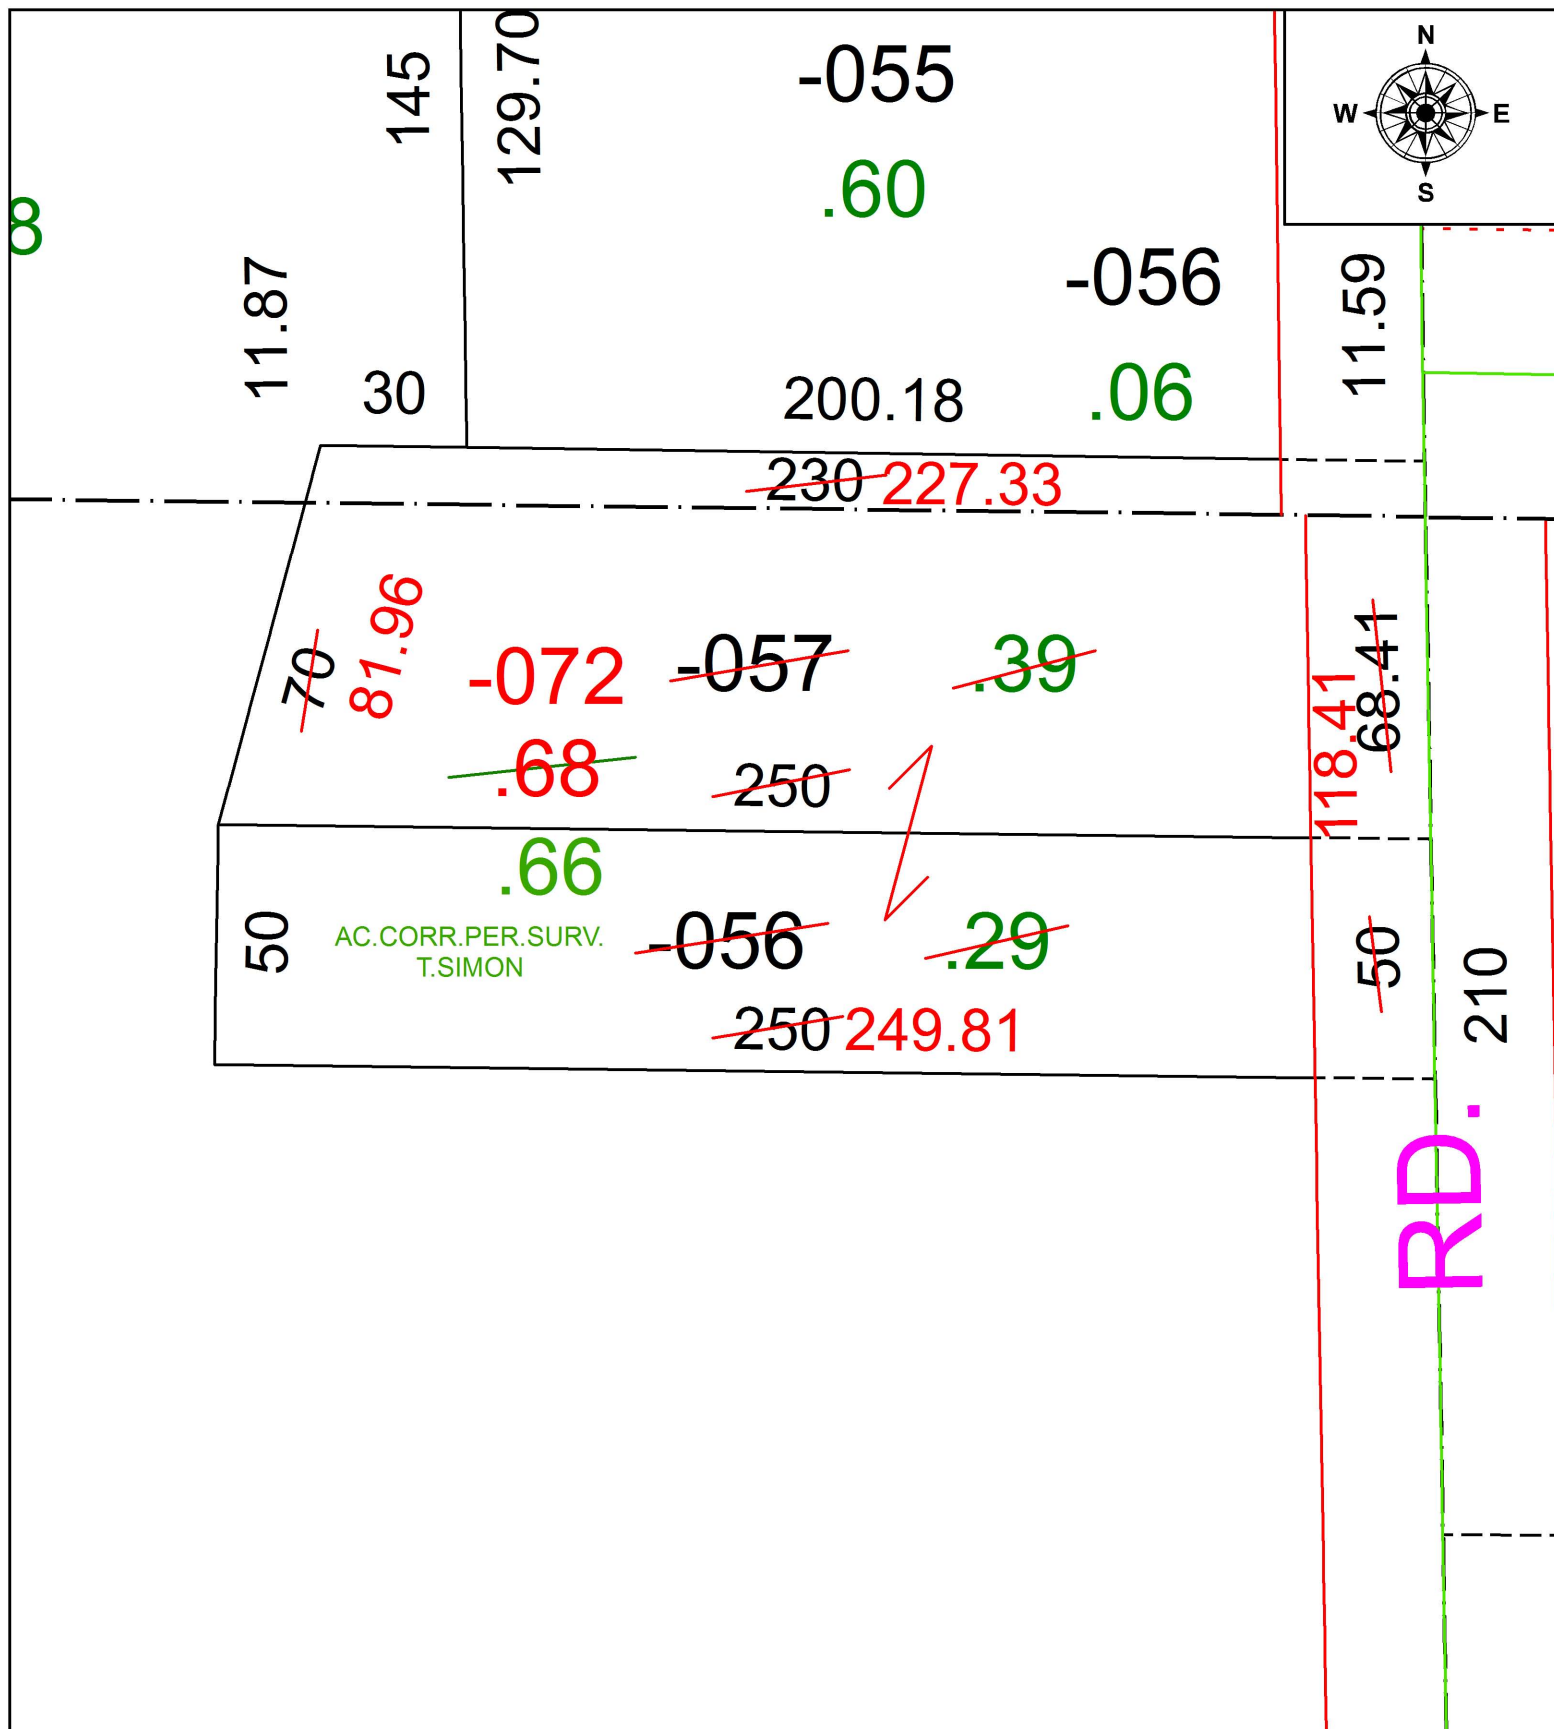

SPLITS/DEEDS PROCESSED
LORAIN COUNTY TAX MAP DEPARTMENT
226 MIDDLE AVE. ELYRIA, OH

SURVEYED BY:	THOMAS A. SIMON
CLOSURE:	1: 317,018
MAP PAGE(S):	1-00-013
APPROVED BY:	RRM DATE: 12-7-17
SCALE:	1" = 40 PRIOR INSTRUMENT: 20150566493