


PARENT PARCEL: 07-00-031-000-119

CHILD PARCEL: 07-00-031-000-177 THRU -181

STARTING POINT: INTERSECTION OF C/L OF STONEY RIDGE RD. AND NORTH LINE OF O.L.33

17-03759

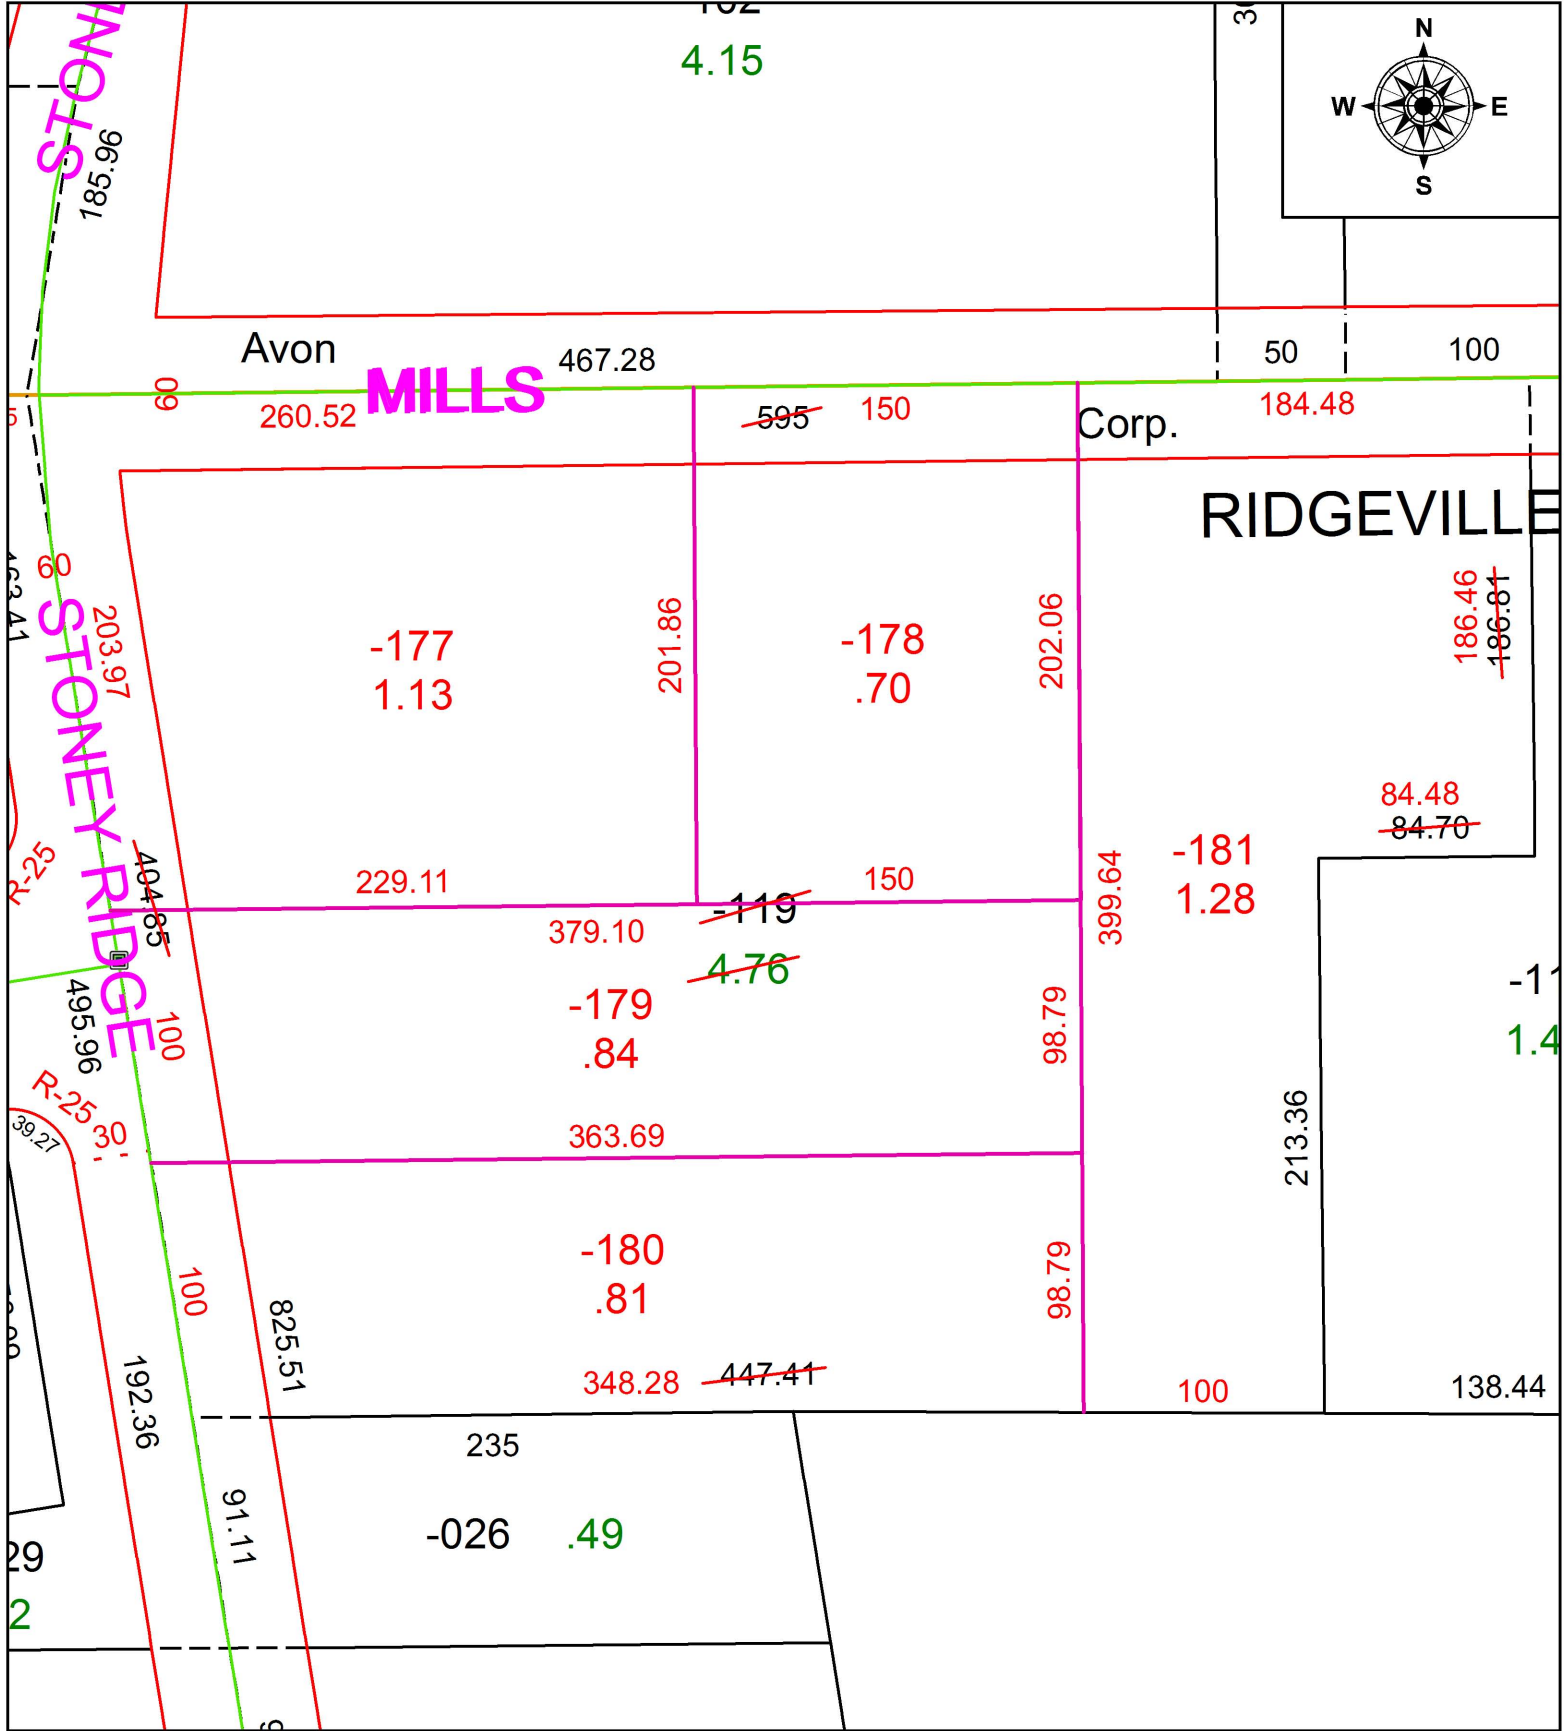

SPLITS/DEEDS PROCESSED
 LORAIN COUNTY TAX MAP DEPARTMENT
 226 MIDDLE AVE. ELYRIA, OH

SURVEYED BY: AMY M. KELLY
 CLOSURE: 1: 51,421
 MAP PAGE(S): 7-00-031
 APPROVED BY: RRM DATE: 12-20-17
 SCALE: 1" = 75 PRIOR INSTRUMENT: 20030974511