
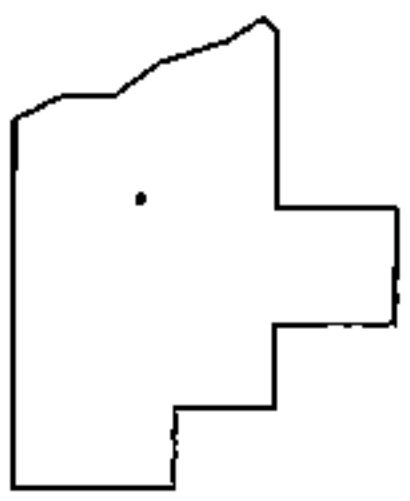
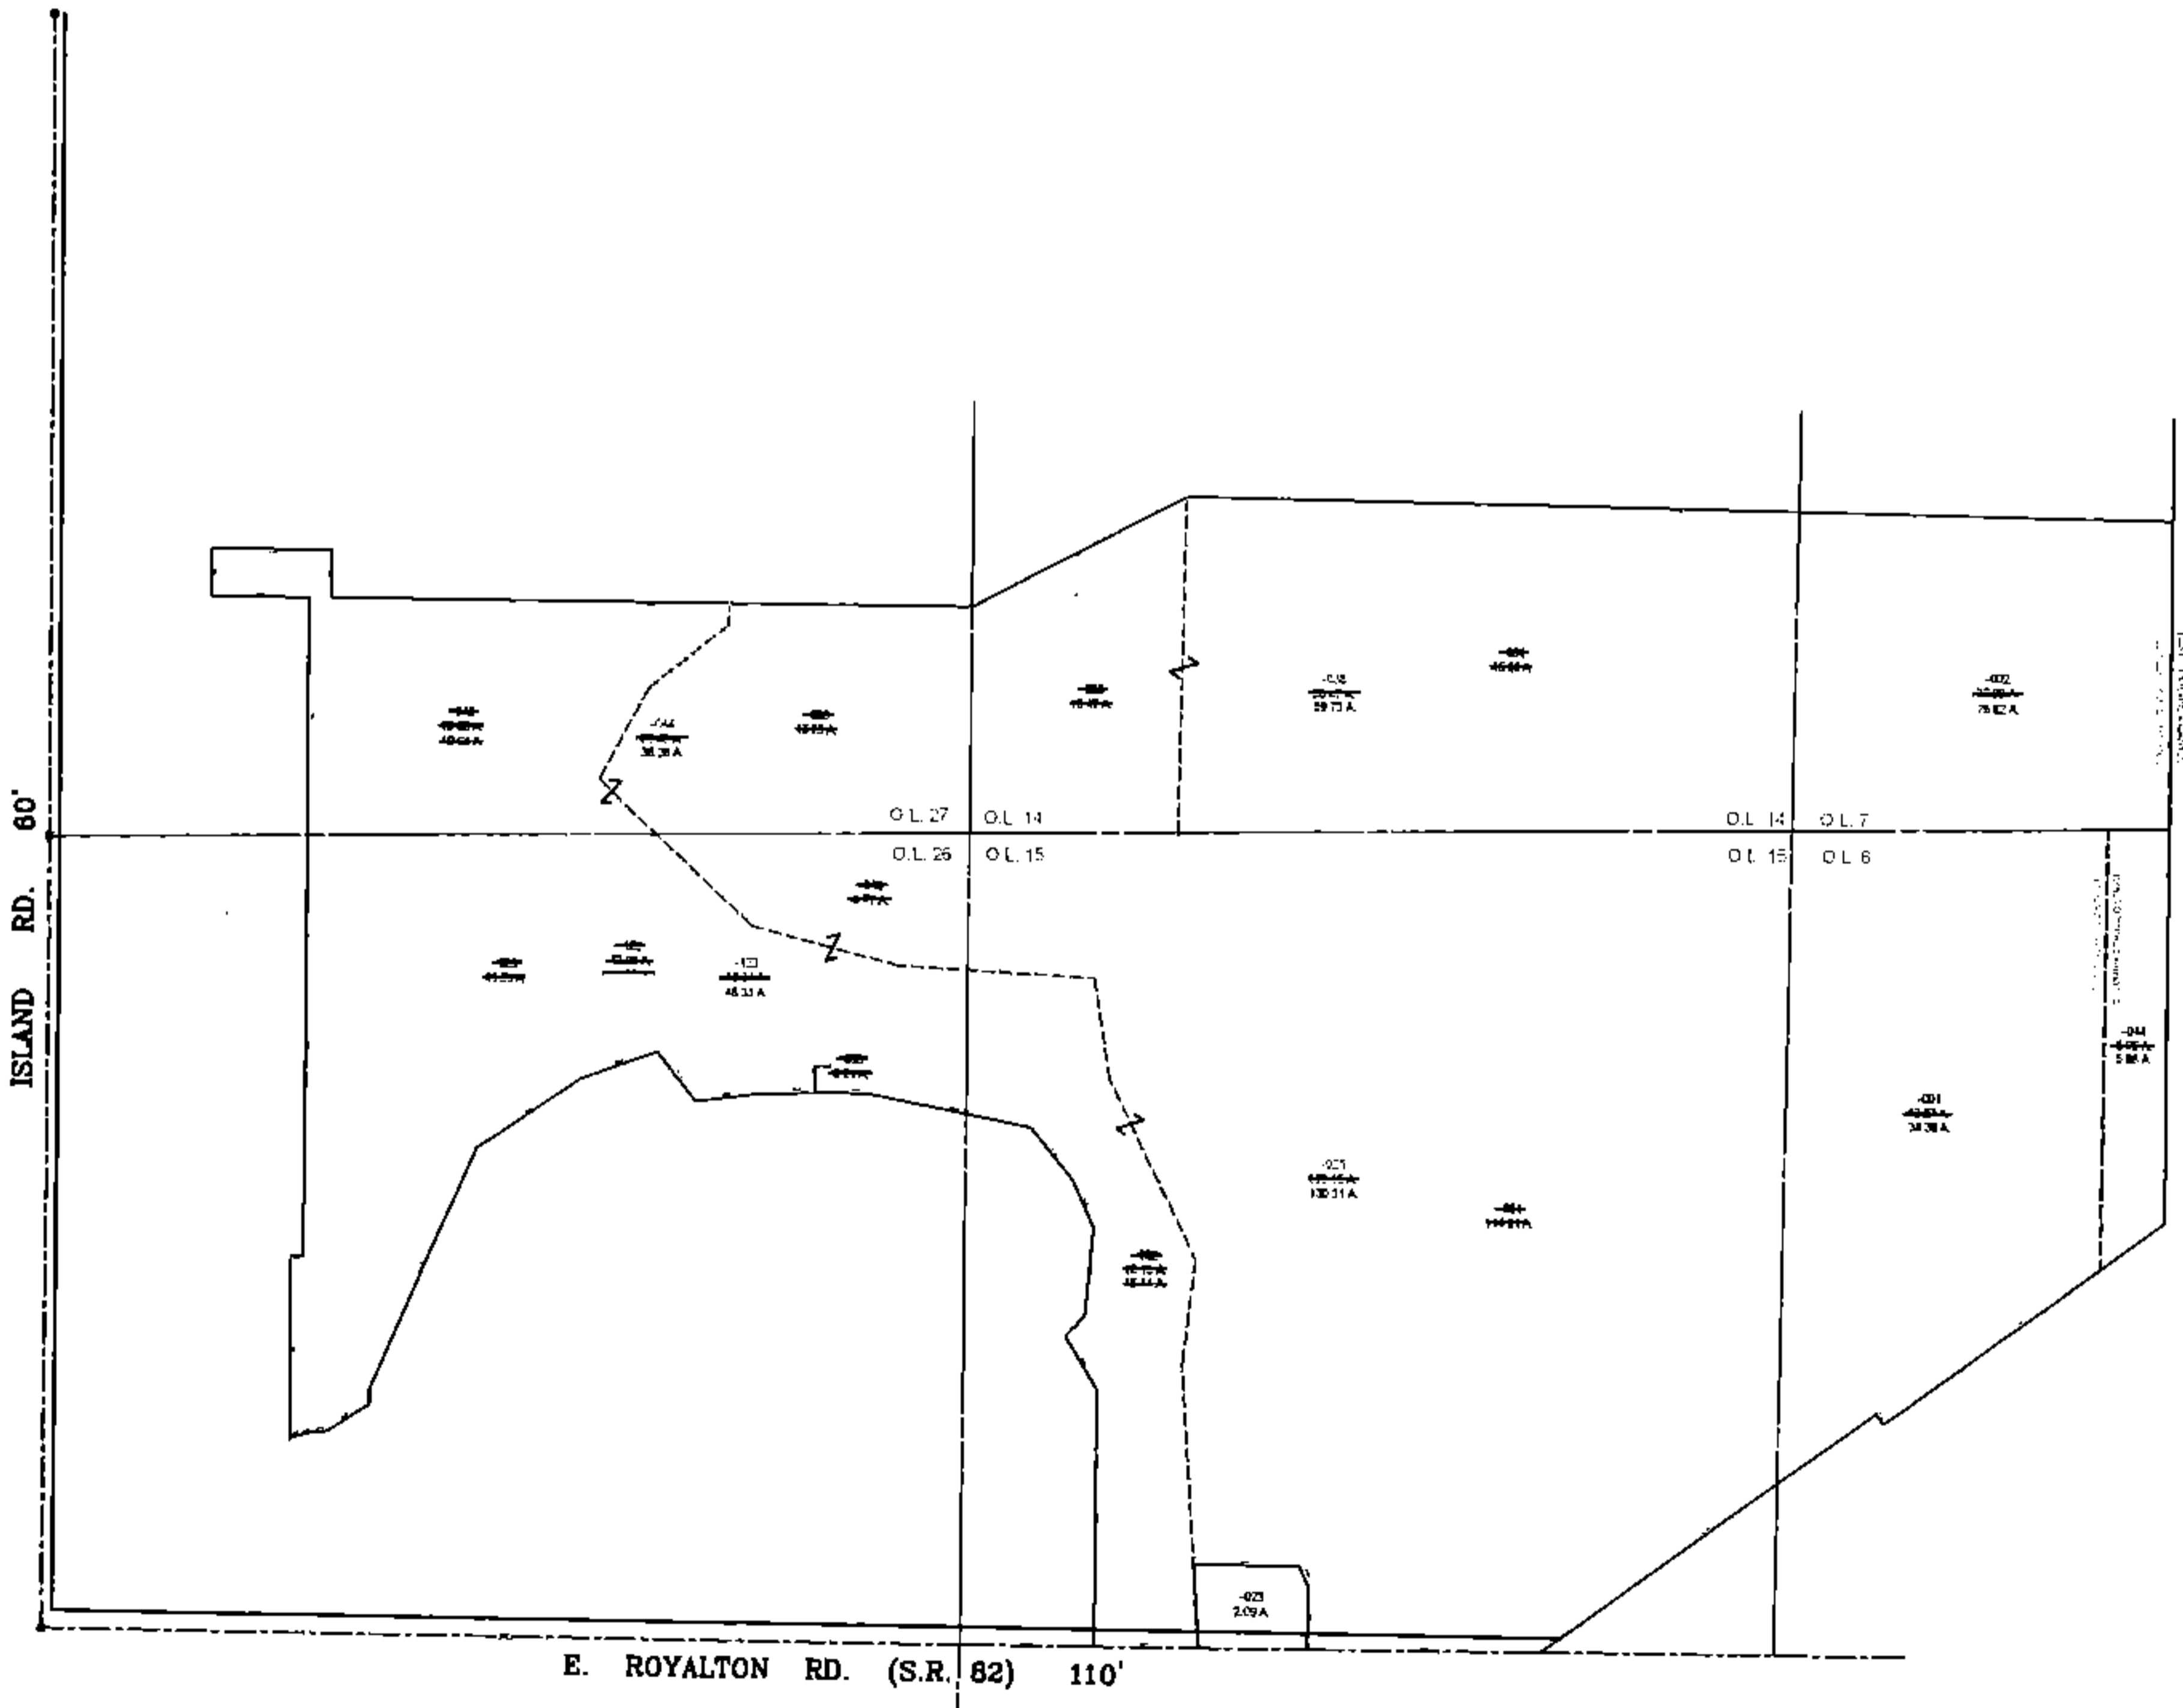


STRAIGHT TRANS: 11-00-006-000-001, & -044
 STRAIGHT TRANS: 11-00-007-000-002
 PARENT PARCEL: 11-00-014-000-004, & -030
 PARENT PARCEL: 11-00-015-000-022 & -024
 PARENT PARCEL: 11-00-026-000-048, -088, -089
 PARENT PARCEL: 11-00-027-000-039 & -043

17-03764

CHILD PARCEL: 11-00-014-000-038, 11-00-015-000-025
 CHILD PARCEL: 11-00-026-000-122 & -123, 11-00-027-000-044
 STARTING POINT: I.P. MON. BOX, CL OF E. ROYALTON RD. (S.R. 82) & CL OF ISLAND RD.

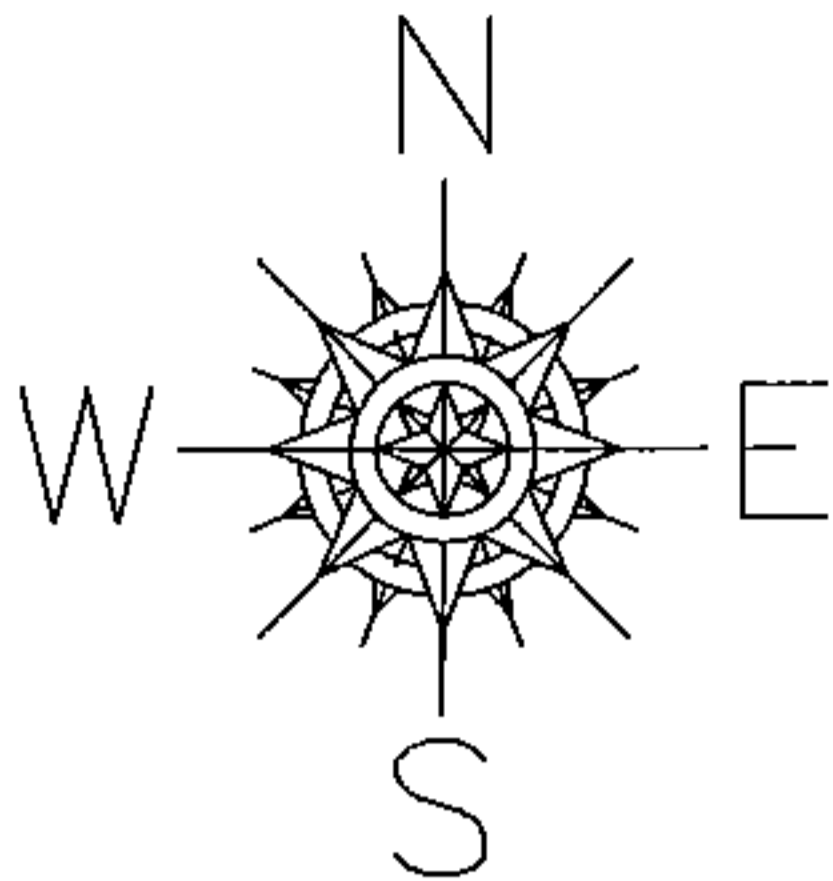

SPLITS/DEEDS PROCESSED
 LORAIN COUNTY TAX MAP DEPARTMENT
 226 MIDDLE AVE. ELYRIA, OHIO

SURVEYED BY: ALEX MARKS
 CLOSURE: 0.01 : 10,000
 MAP PAGE(S): 11-00-006, -007, -014, -015, -026, -027
 APPROVED BY: TJS DATE: 1/12/18
 SCALE: 1" = 1,000 PRIOR INSTRUMENT: DV XXXX/XXX