
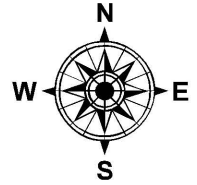


PARENT PARCEL: 01-00-034-000-027, -033, 01-00-035-000-035


CHILD PARCEL: 01-00-034-000-055, 01-00-035-000-035

STARTING POINT: INTERSECTION OF C/L OF VERMILION RD. AND C/L OF COOPER FOSTER PARK RD.

18-03768

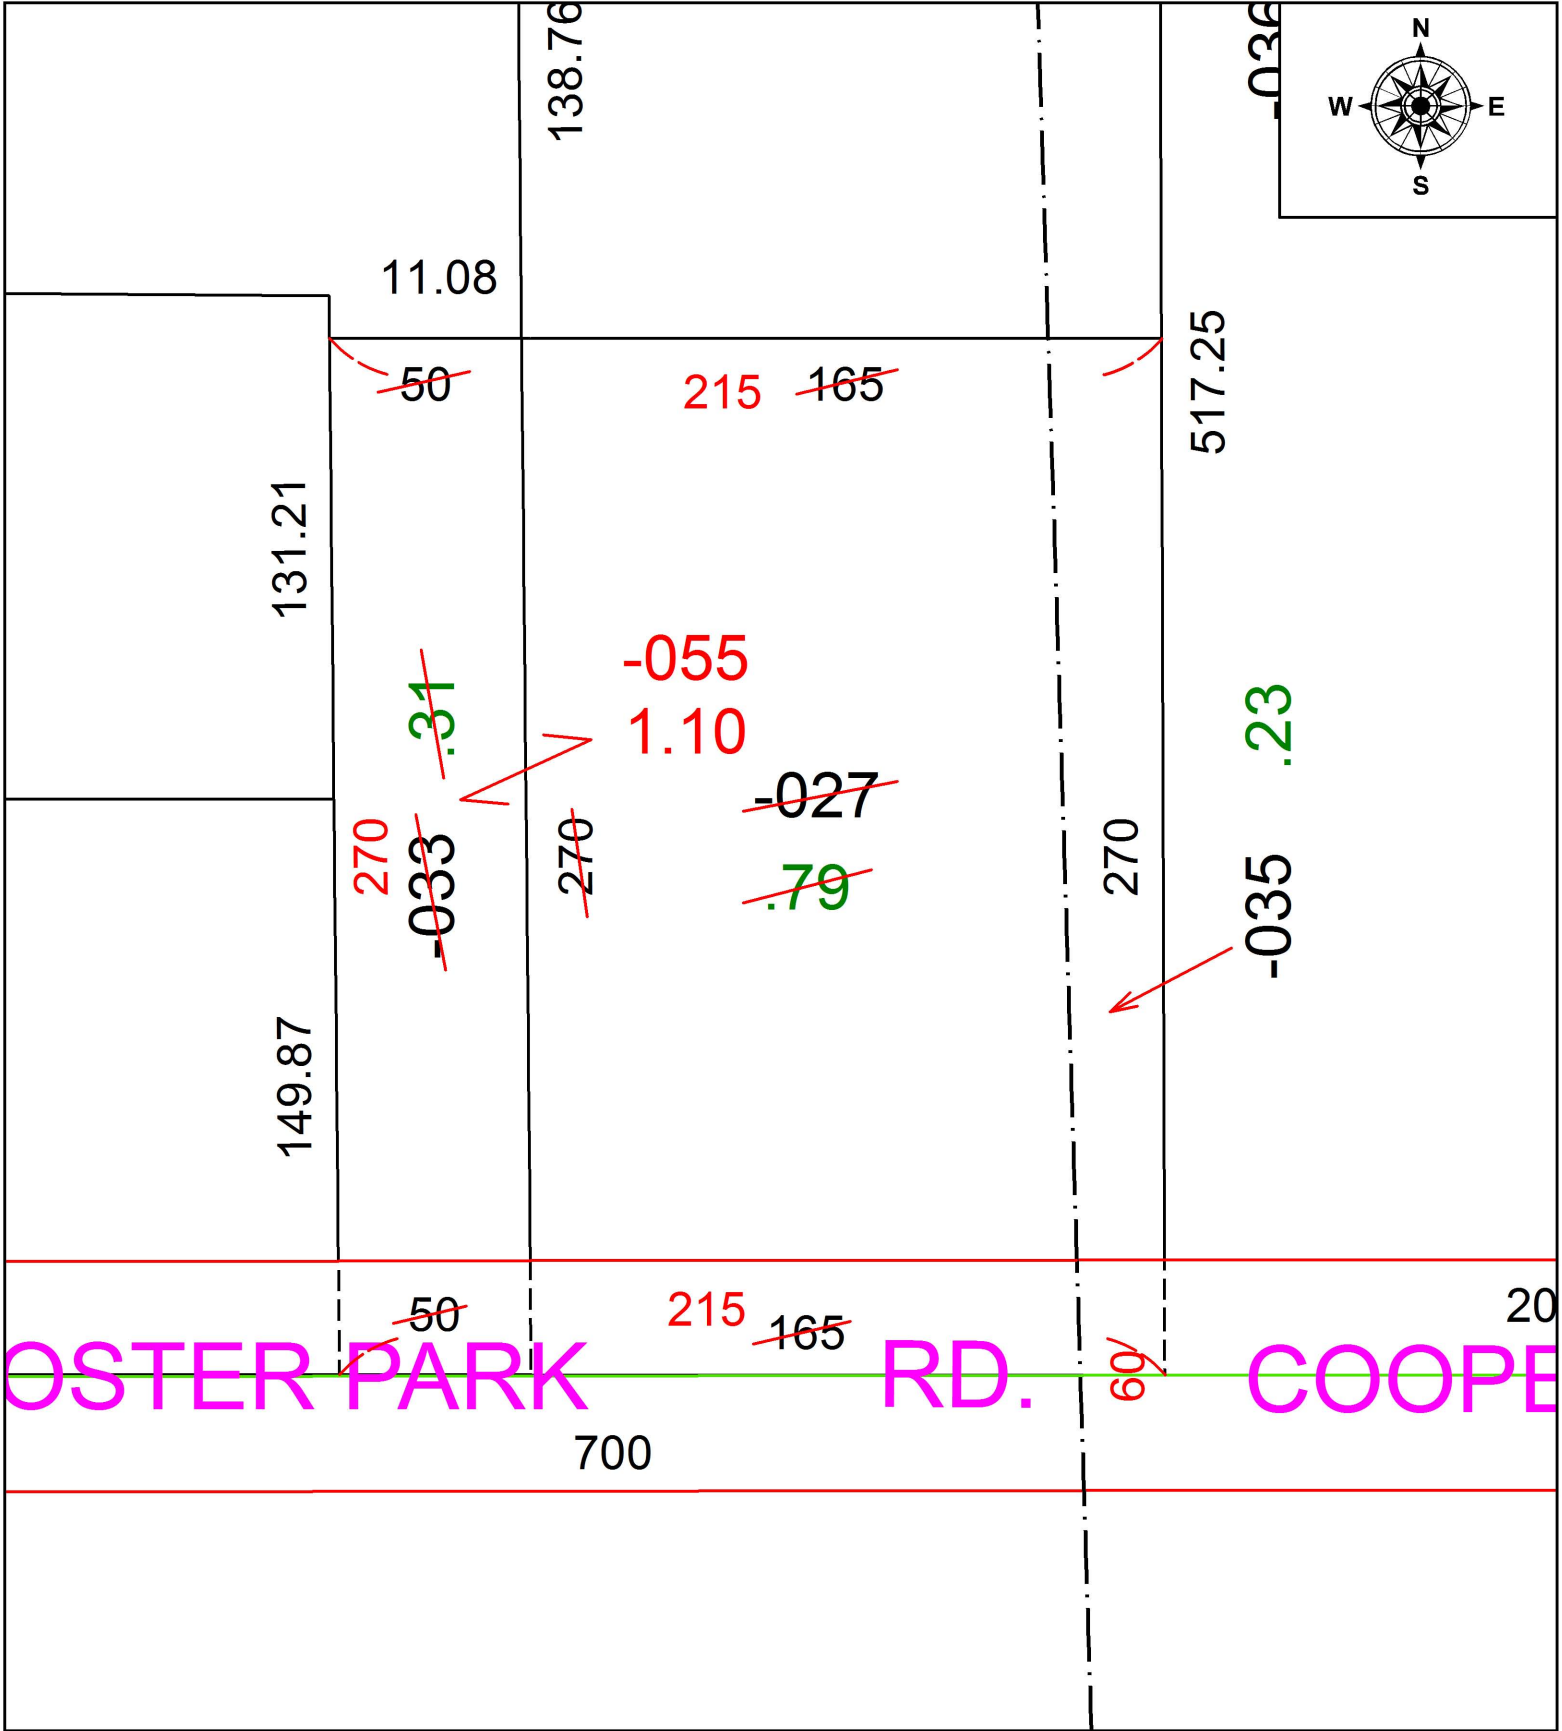

OSTER PARK RD. COOPER FOSTER PARK RD.

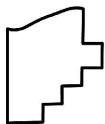

SPLITS/DEEDS PROCESSED
 LORAIN COUNTY TAX MAP DEPARTMENT
 226 MIDDLE AVE. ELYRIA, OH

SURVEYED BY: PATRICK A. MCGANNON
 CLOSURE: 1: 2147483648
 MAP PAGE(S): 1-00-034
 APPROVED BY: RRM DATE: 1-5-18
 SCALE: 1" = 50 PRIOR INSTRUMENT: 20100333007