


PARENT PARCEL: 09-00-074-101-050

CHILD PARCEL: 09-00-074-630-001

STARTING POINT:

17-03769-G

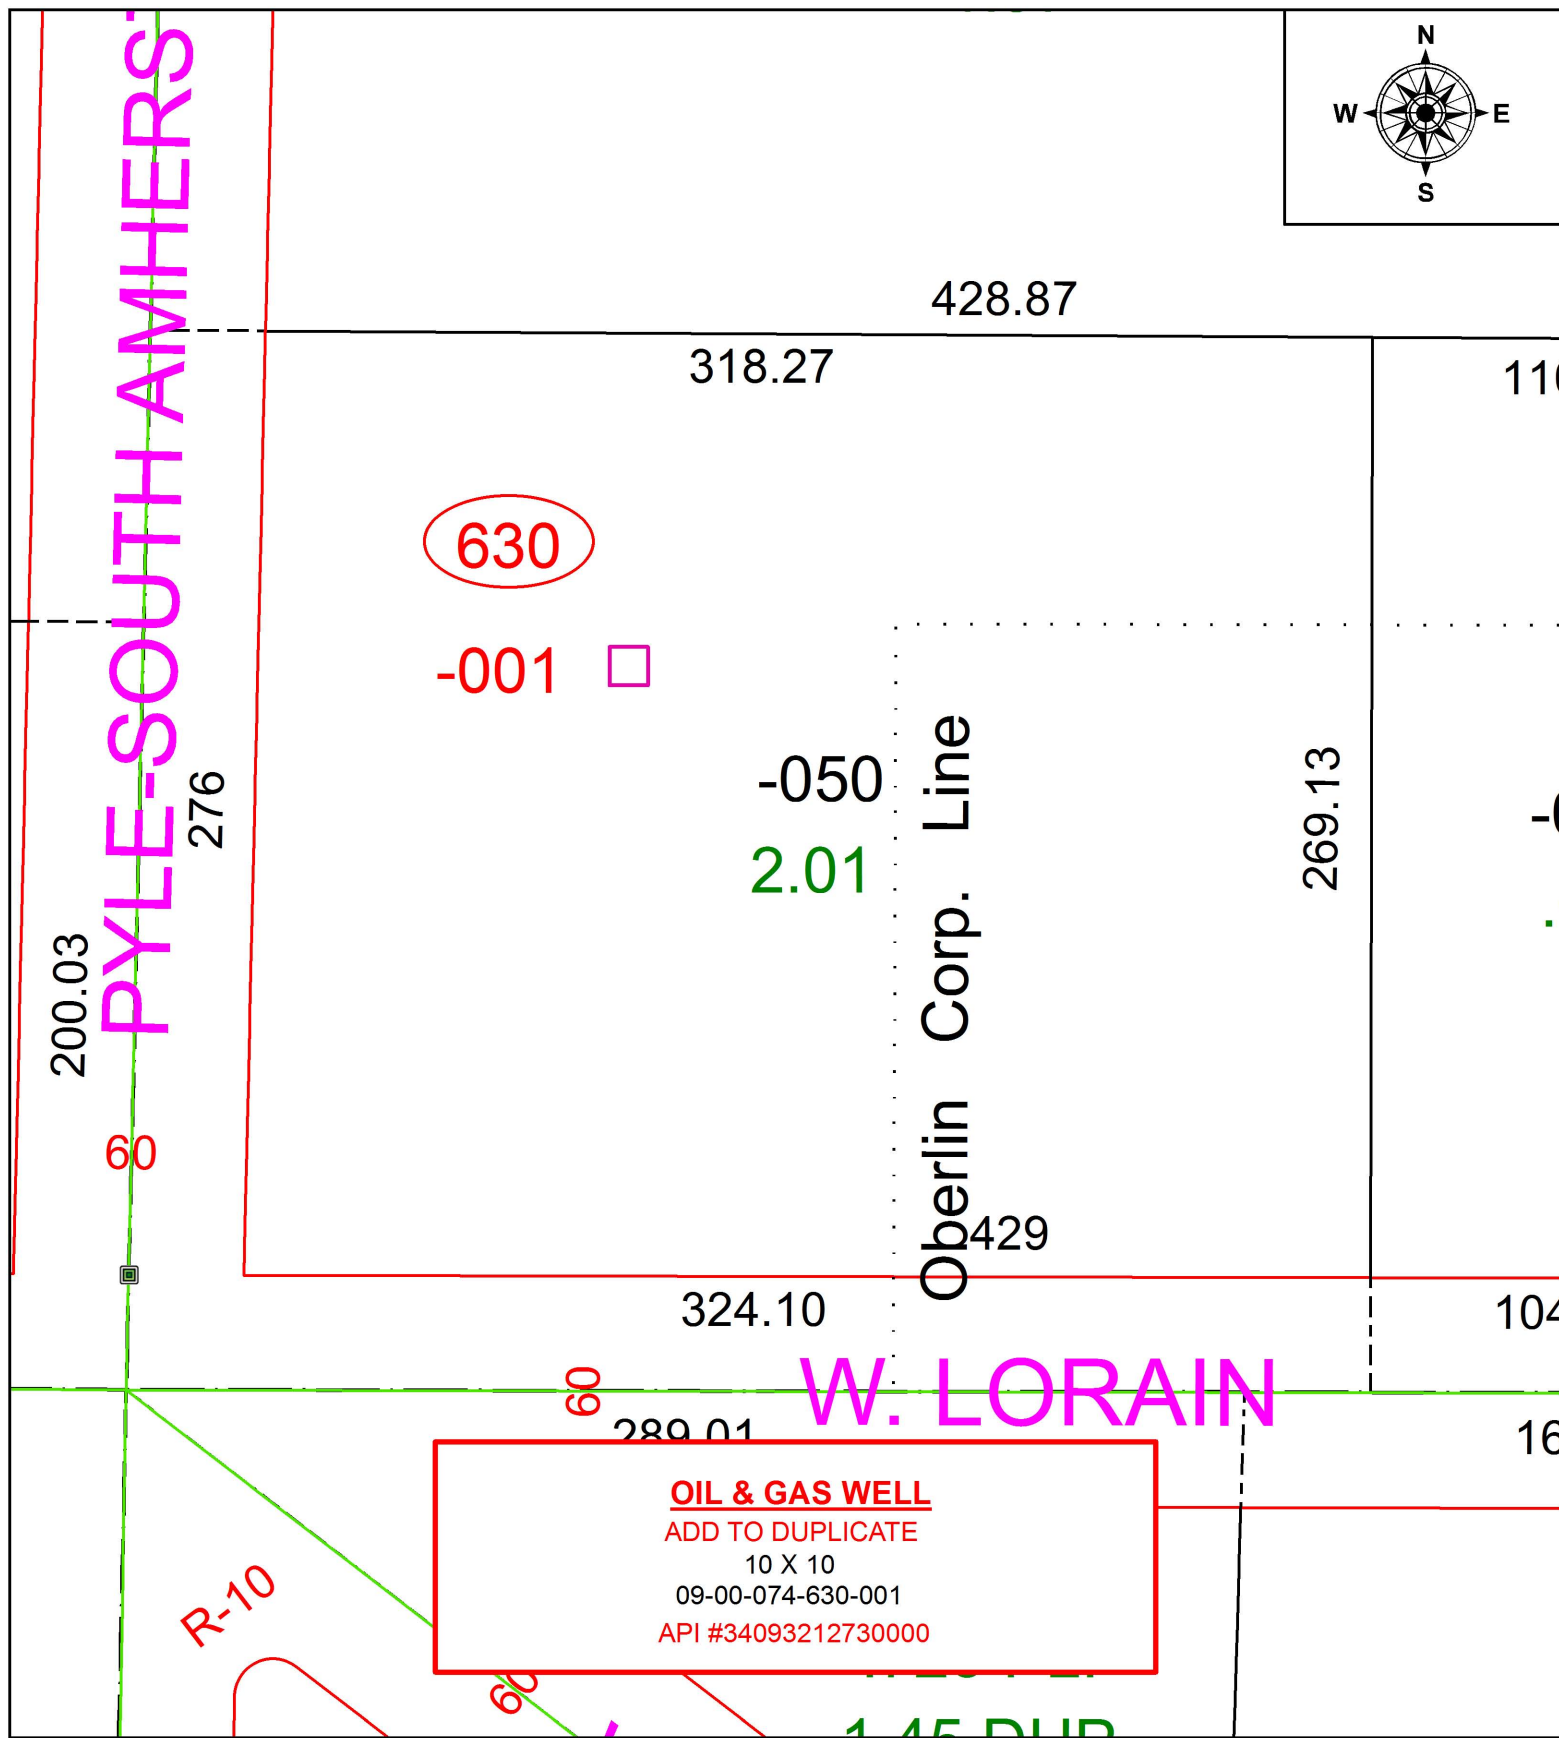

630


-001 □

-050
2.01

Oberlin Corp. Line

W. LORAIN

OIL & GAS WELL
ADD TO DUPLICATE
10 X 10
09-00-074-630-001
API #34093212730000

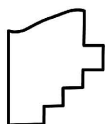

SPLITS/DEEDS PROCESSED
LORAIN COUNTY TAX MAP DEPARTMENT
226 MIDDLE AVE. ELYRIA, OH

SURVEYED BY: _____ N/A
CLOSURE: _____ N/A
MAP PAGE(S): _____ 9-00-074
APPROVED BY: _____ RRM DATE: _____ 9-25-17
SCALE: _____ 1" = 50 PRIOR INSTRUMENT: _____ N/A