

PARENT PARCEL: 12-00-060-000-035

CHILD PARCEL: 12-00-060-630-001

STARTING POINT:


17-03772-G



CUYAHOGA CO

COLUMBIA TWP


SPRAGUE

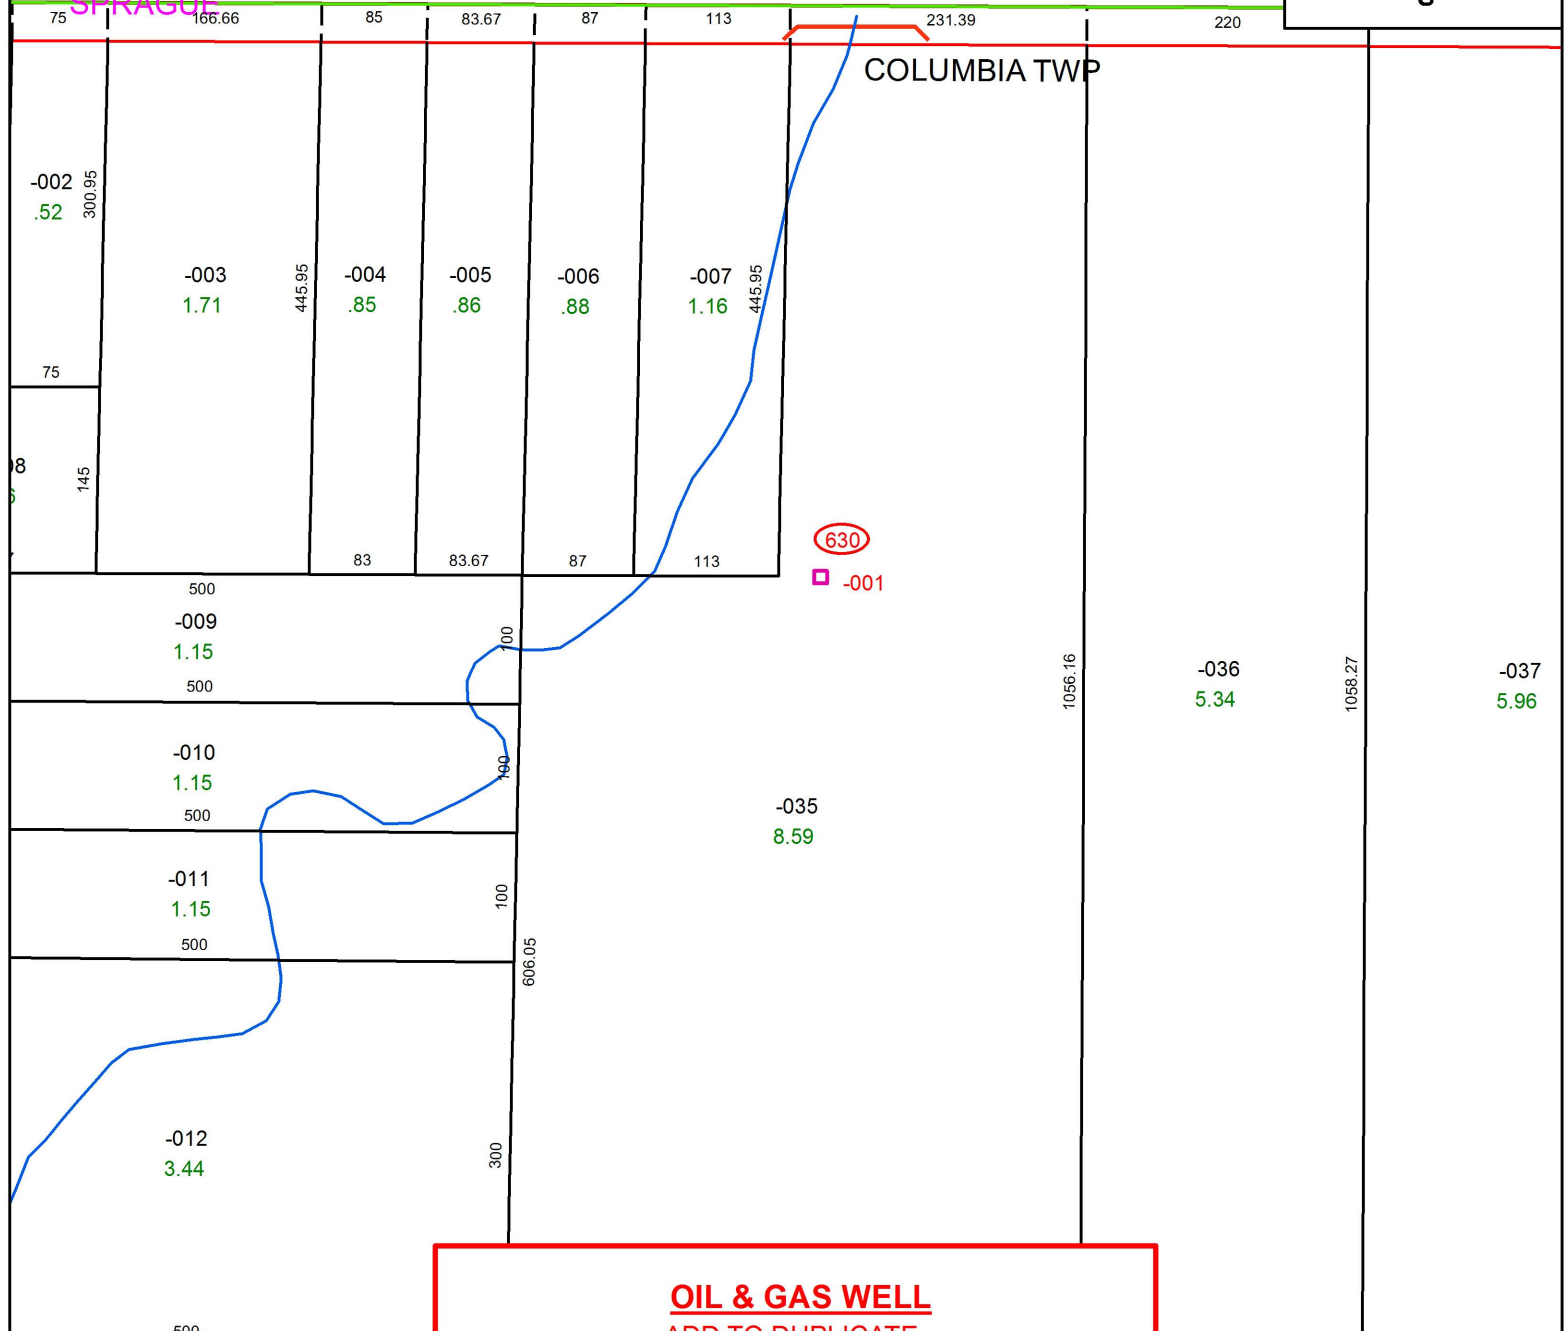

630

-001

OIL & GAS WELL
ADD TO DUPLICATE
10 X 10
12-00-060-630-001
API #34093601270000

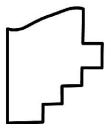

SPLITS/DEEDS PROCESSED
LORAIN COUNTY TAX MAP DEPARTMENT
226 MIDDLE AVE. ELYRIA, OH

SURVEYED BY: N/A
CLOSURE: N/A
MAP PAGE(S): 12-00-060
APPROVED BY: RRM DATE: 9-26-17
SCALE: 1" = 150 PRIOR INSTRUMENT: N/A