


PARENT PARCEL: 12-00-050-000-012

CHILD PARCEL: 12-00-031-630-001

STARTING POINT:


17-03773-G

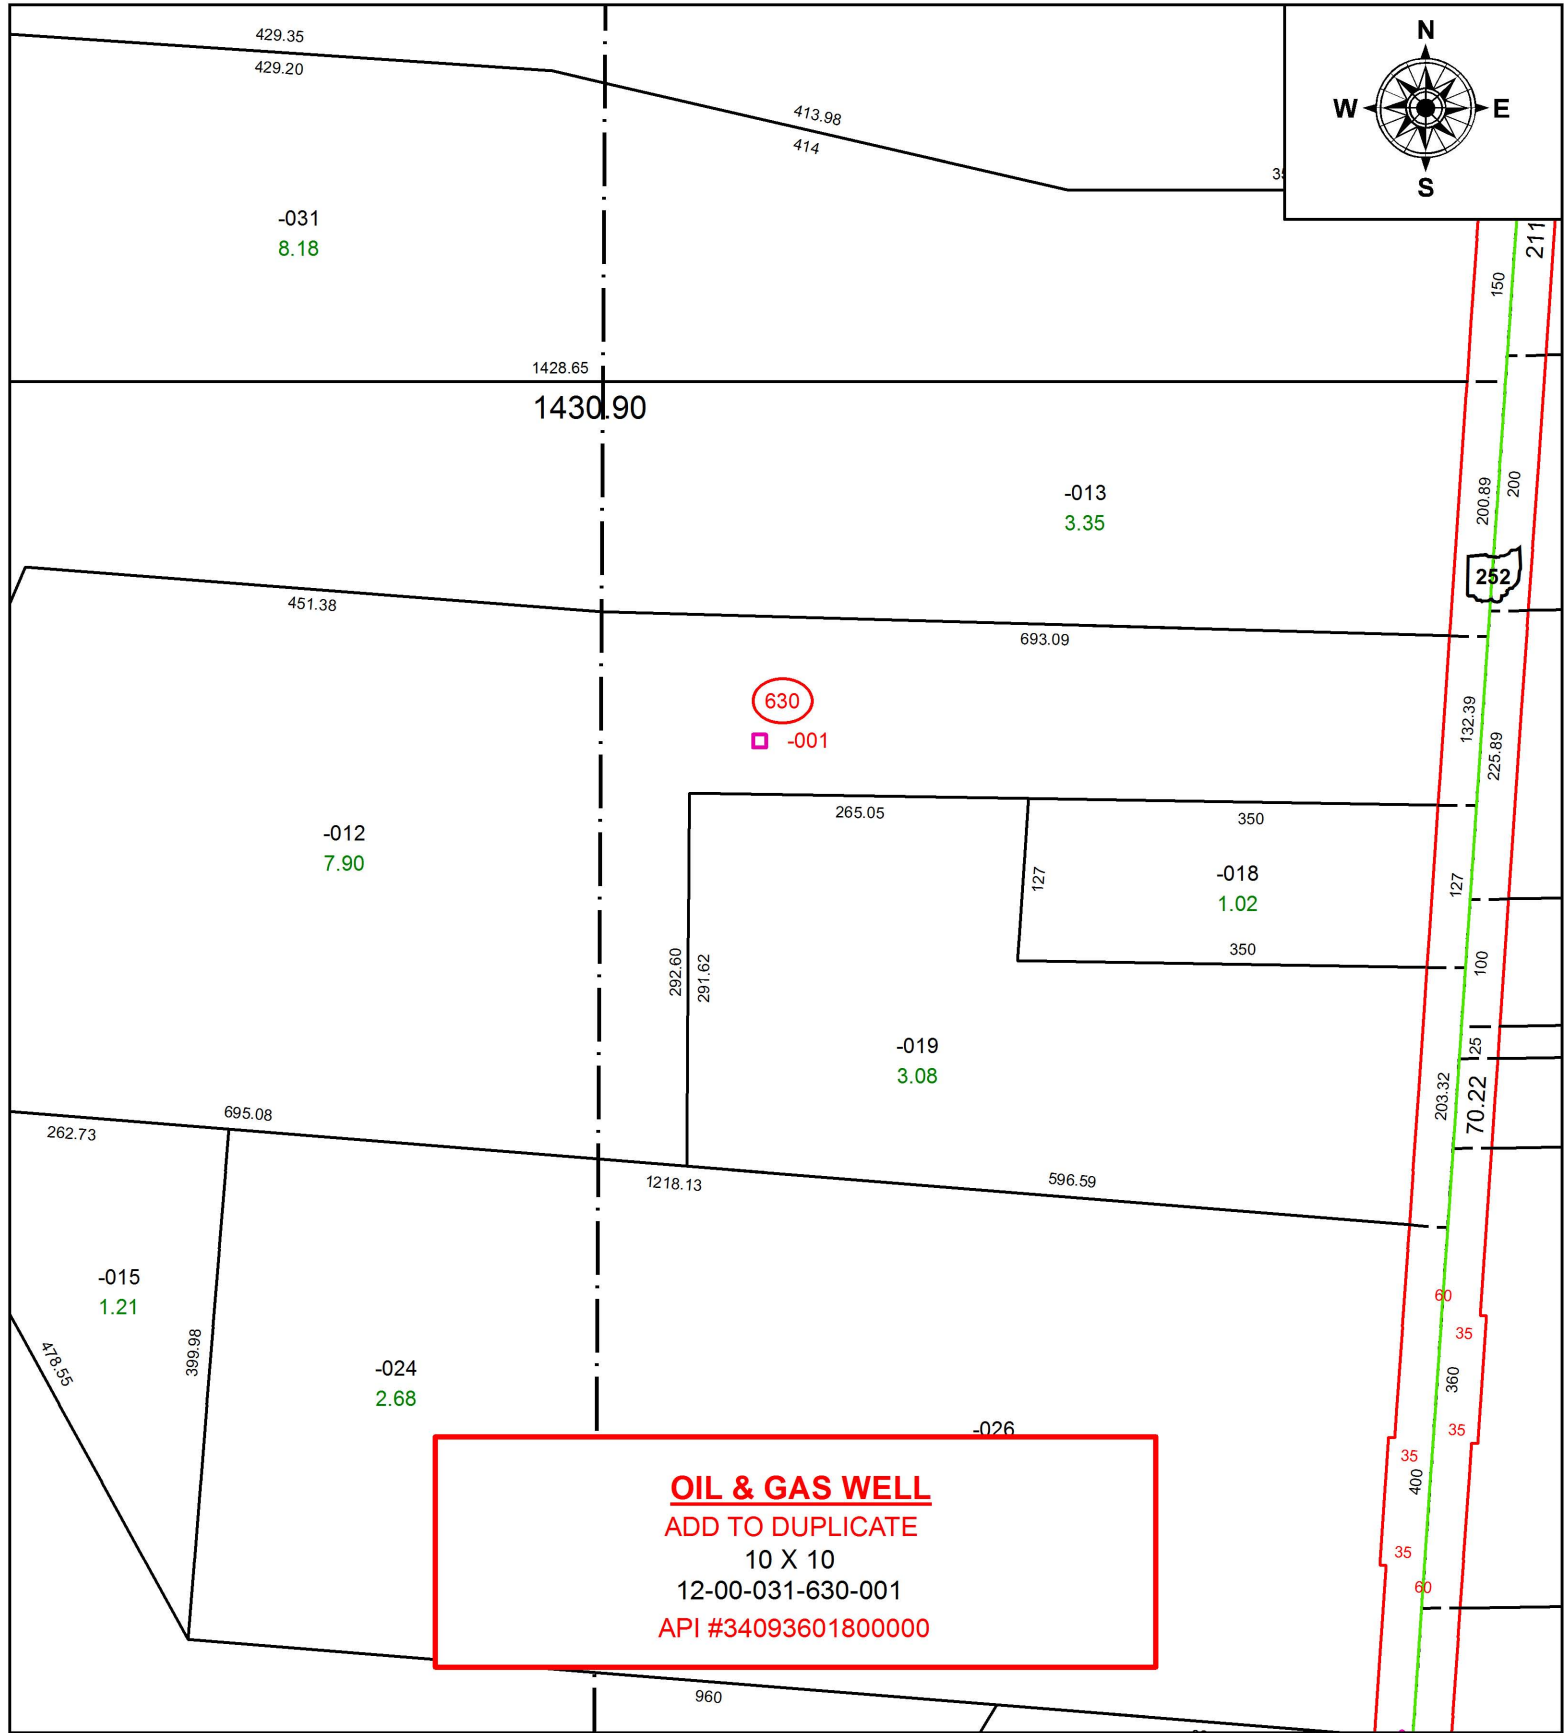

630

□ -001

**OIL & GAS WELL**  
ADD TO DUPLICATE  
10 X 10  
12-00-031-630-001  
API #34093601800000

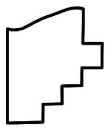

**SPLITS/DEEDS PROCESSED**  
LORAIN COUNTY TAX MAP DEPARTMENT  
226 MIDDLE AVE. ELYRIA, OH

SURVEYED BY: N/A  
CLOSURE: N/A  
MAP PAGE(S): 12-00-050  
APPROVED BY: RRM DATE: 9-26-17  
SCALE: 1" = 150 PRIOR INSTRUMENT: N/A