
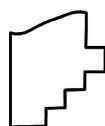


PARENT PARCEL: 07-00-035-101-018, -031, -047, -052, -064

CHILD PARCEL: 07-00-035-101-070 THRU -076

STARTING POINT: INTERSECTION OF C/L OF SUGAR RIDGE RD. AND C/L OF RACE RD.

18-03774

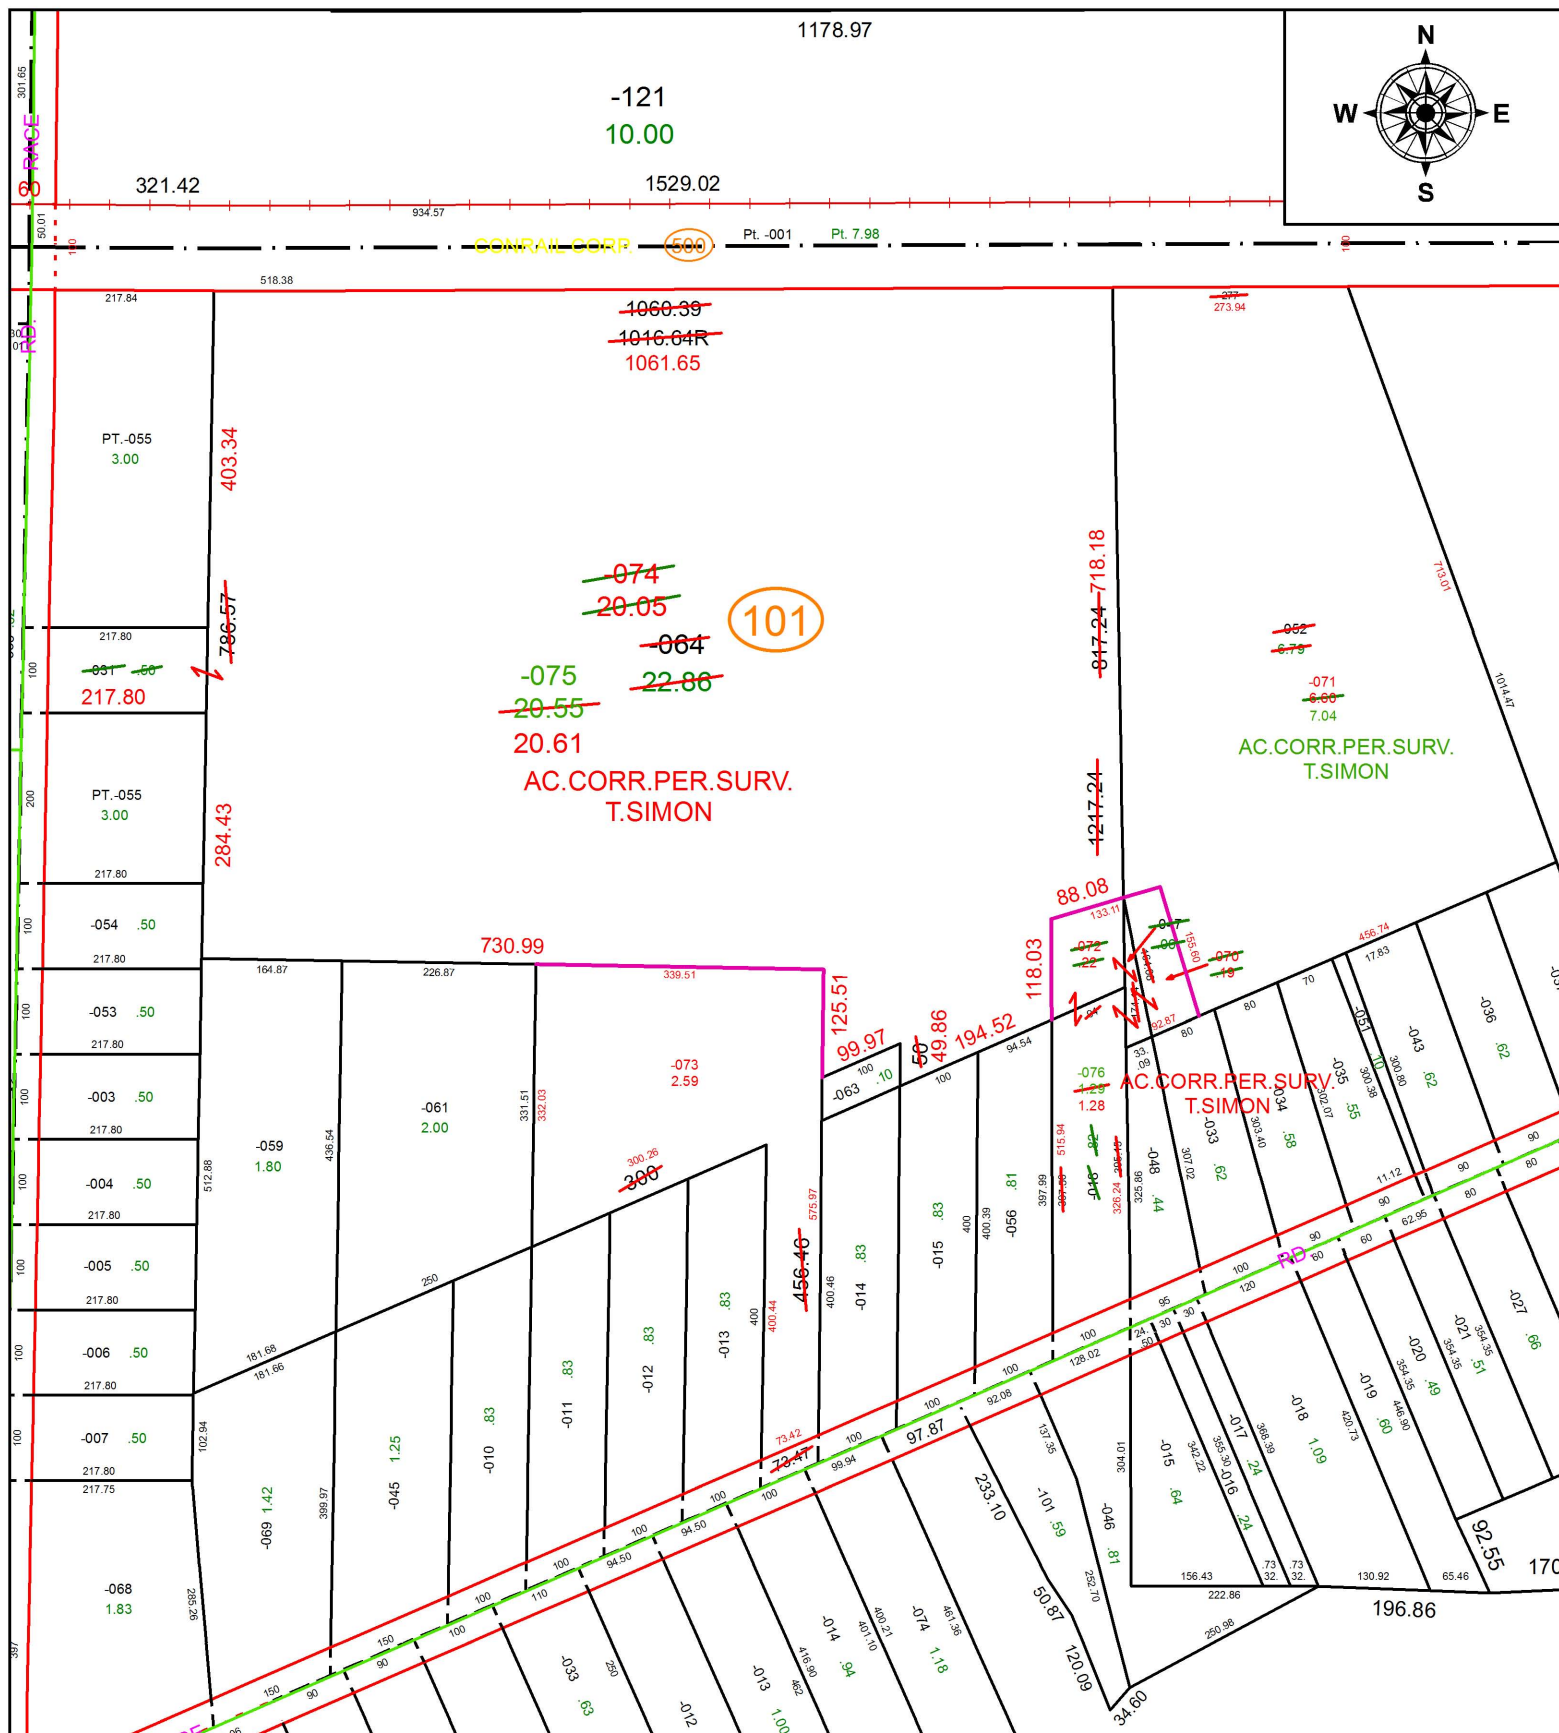

SPLITS/DEEDS PROCESSED
 LORAIN COUNTY TAX MAP DEPARTMENT
 226 MIDDLE AVE. ELYRIA, OH

SURVEYED BY: THOMAS A. SIMON
 CLOSURE: 1: 59,974
 MAP PAGE(S): 7-00-035
 APPROVED BY: RRM DATE: 1-26-18
 SCALE: 1" = 225 PRIOR INSTRUMENT: 20160589793