


PARENT PARCEL: 09-00-074-102-018, -023, 09-00-074-104-038

CHILD PARCEL: 09-00-074-102-031 THRU -034

STARTING POINT: SOUTHWEST CORNER OF O.L. 74

18-03779

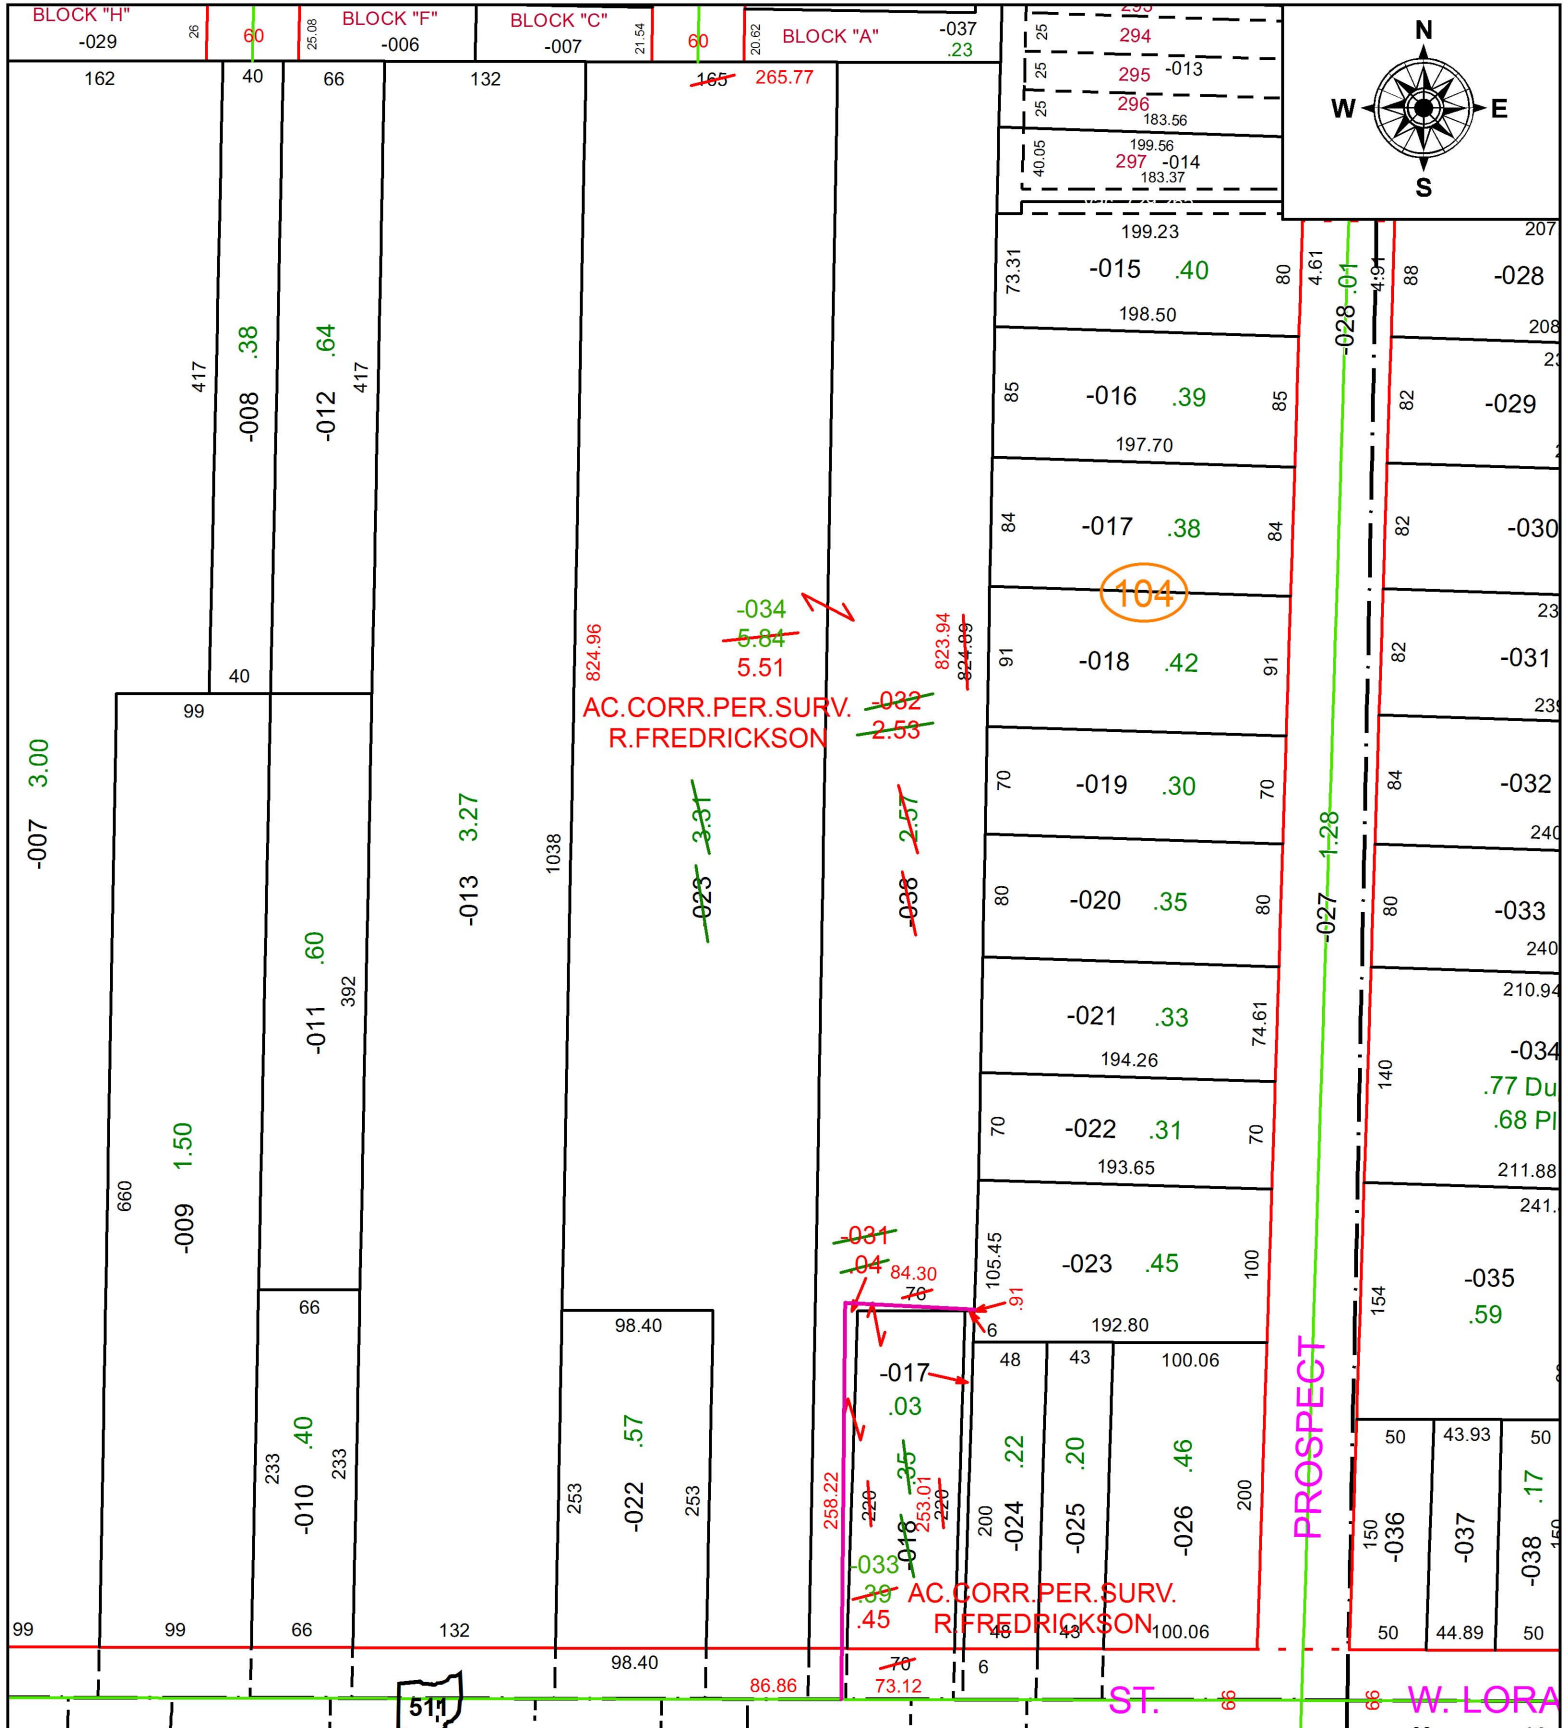

-007 3.00

BLOCK "H" -029

BLOCK "F" -006

BLOCK "C" -007

BLOCK "A" -037

AC. CORR. PER. SURV. R. FREDRICKSON

AC. CORR. PER. SURV. R. FREDRICKSON

PROSPECT

ST.

W. LORA

SPLITS/DEEDS PROCESSED

LORAIN COUNTY TAX MAP DEPARTMENT
226 MIDDLE AVE. ELYRIA, OH

SURVEYED BY: RICHARD A. FREDRICKSON

CLOSURE: 1: 72,445

MAP PAGE(S): 9-00-074

APPROVED BY: RRM DATE: 1-30-18

SCALE: 1" = 125 PRIOR INSTRUMENT: 19970484281