


PARENT PARCEL: 18-00-028-105-021, 18-00-028-106-021

CHILD PARCEL: 18-00-028-105-049

STARTING POINT: SOUTHWEST CORNER OF S/L 60 IN WADSWORTH ADD.

17-03780-D

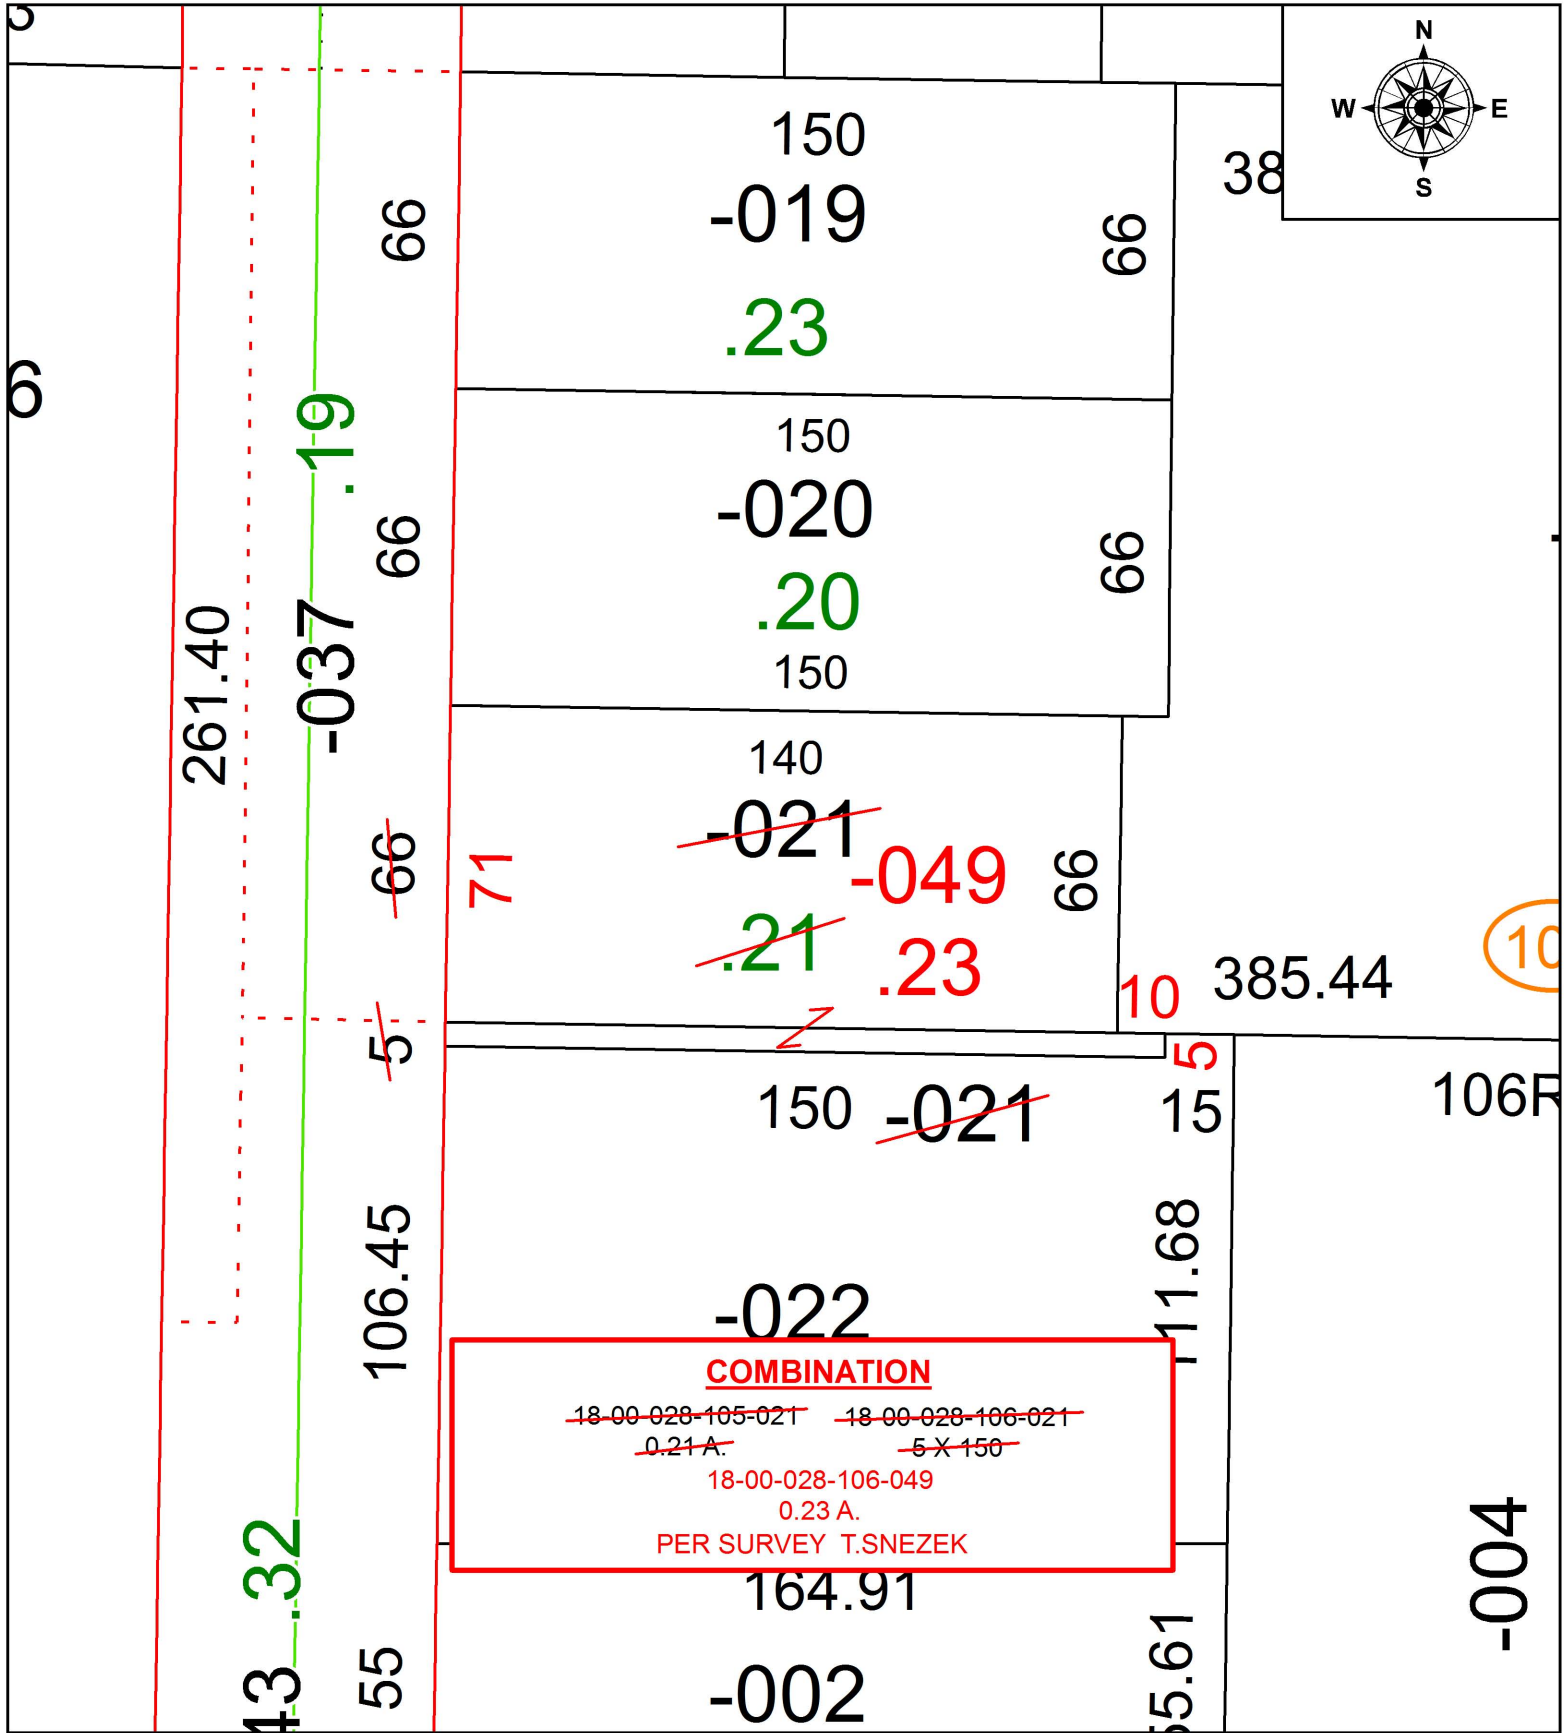

COMBINATION
~~18-00-028-105-021~~ ~~18-00-028-106-021~~
~~0.21 A.~~ ~~5 X 150~~
18-00-028-106-049
0.23 A.
PER SURVEY T.SNEZEK



SPLITS/DEEDS PROCESSED
LORAIN COUNTY TAX MAP DEPARTMENT
226 MIDDLE AVE. ELYRIA, OH

SURVEYED BY: THOMAS M. SNEZEK
CLOSURE: 1: 2147483648
MAP PAGE(S): 18-00-028
APPROVED BY: RRM DATE: 10-5-17
SCALE: 1" = 40 PRIOR INSTRUMENT: 20160585850