
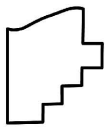


PARENT PARCEL: 04-00-023-102-005, -039

CHILD PARCEL: 04-00-023-102-152 THRU -154

STARTING POINT: INTERSECTION OF C/L OF JAYCOX RD. AND C/L OF SADDLE CREEK DR.

18-03780

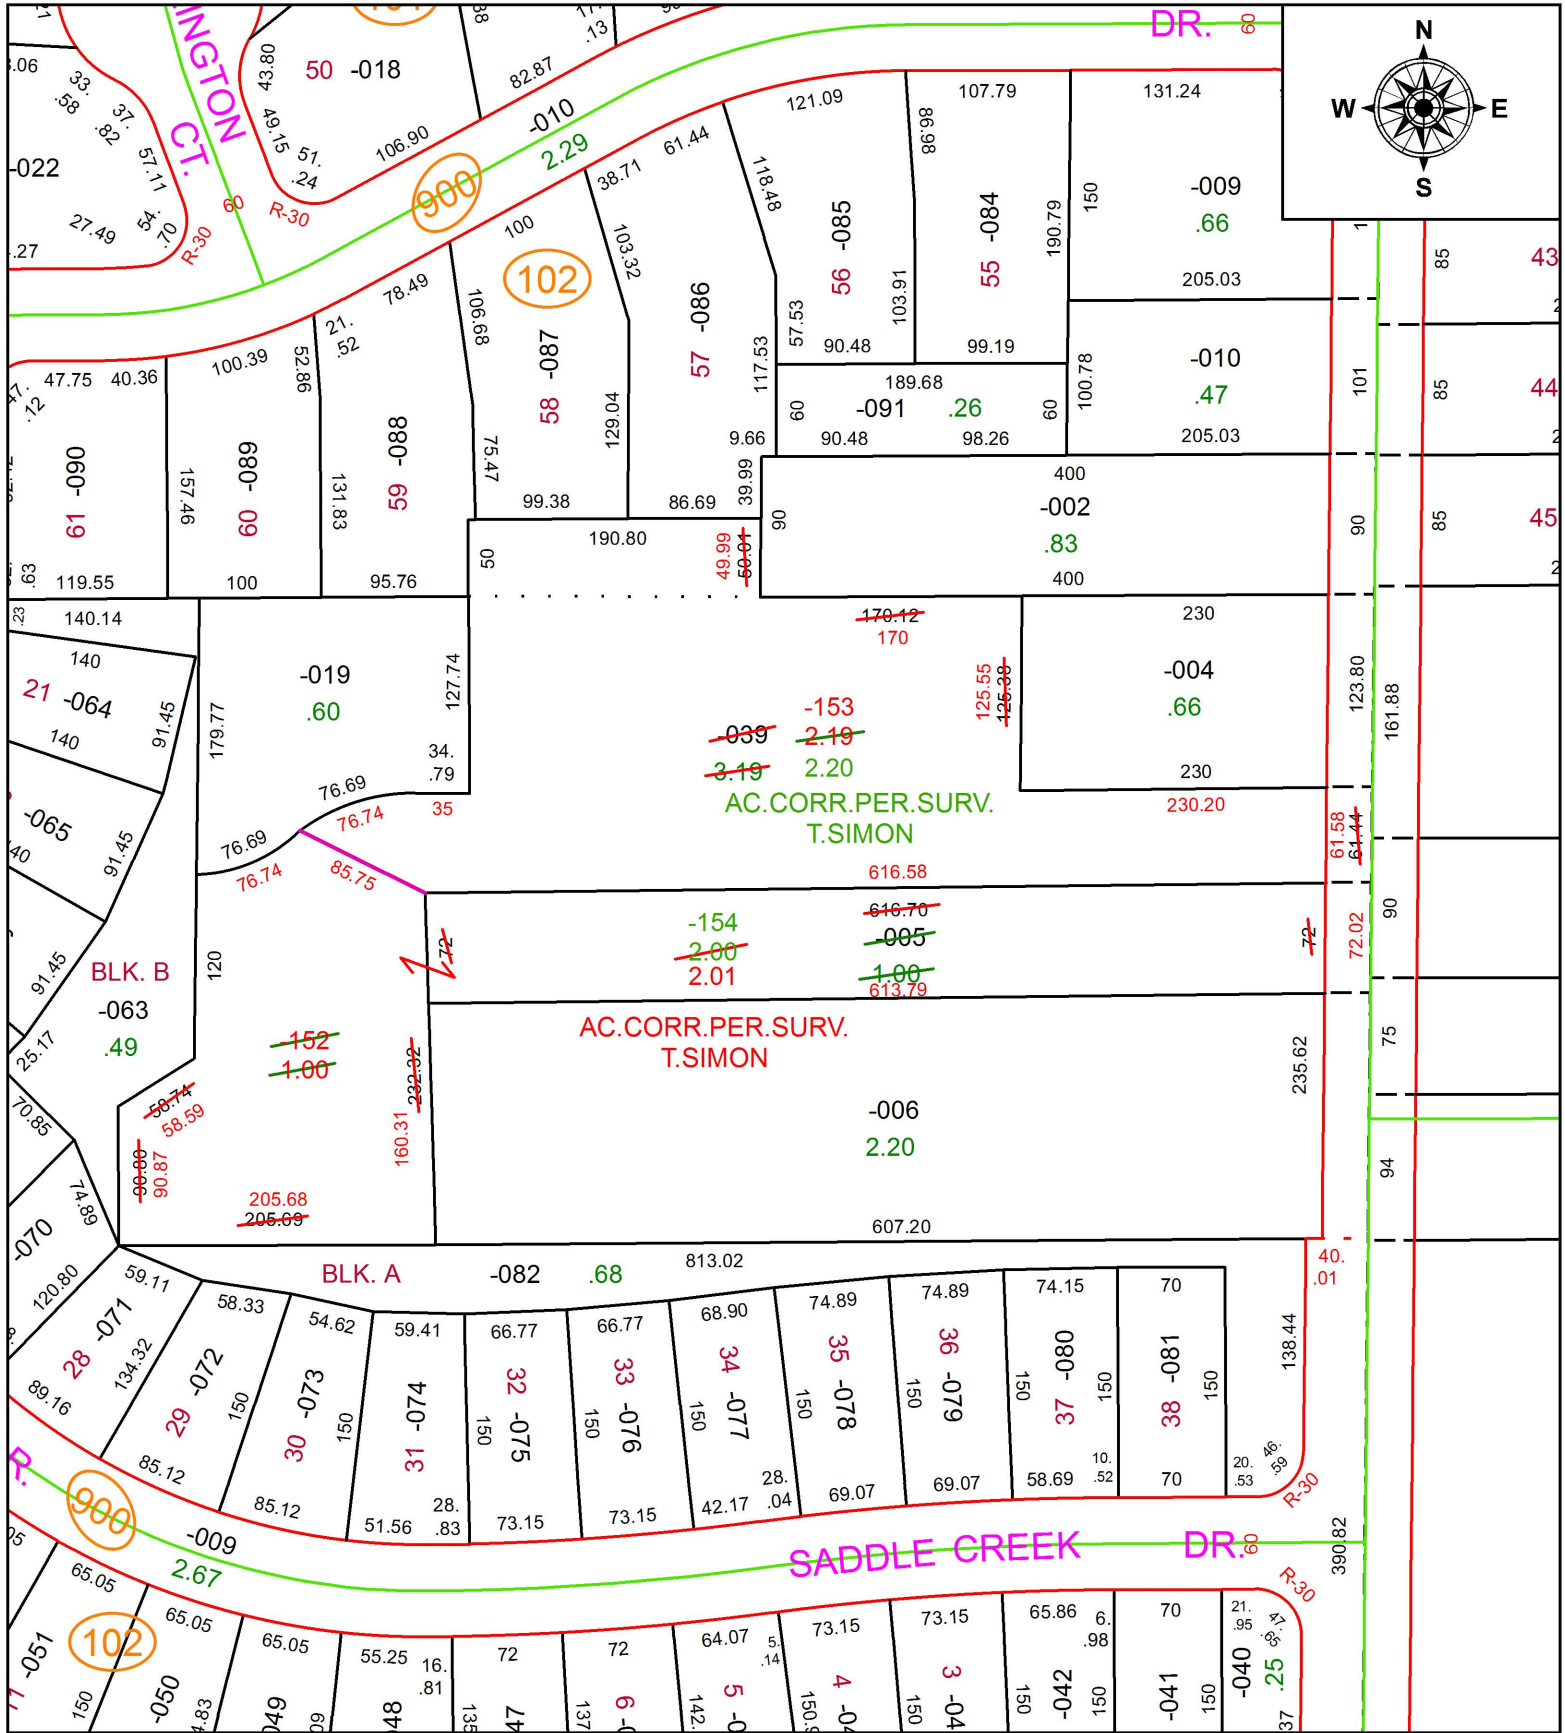

SPLITS/DEEDS PROCESSED

LORAIN COUNTY TAX MAP DEPARTMENT
226 MIDDLE AVE. ELYRIA, OH

SURVEYED BY: THOMAS A. SIMON

CLOSURE: 1: 228,434

MAP PAGE(S): 4-00-023

APPROVED BY: RRM DATE: 1-31-18

SCALE: 1" = 125 PRIOR INSTRUMENT: 20020849083