


PARENT PARCEL: PLAT VOL. 103 PG. 98

CHILD PARCEL: CERTIFICATE OF CORRECTION - LINE TABLE

STARTING POINT: XXXXXX

17-03781-C

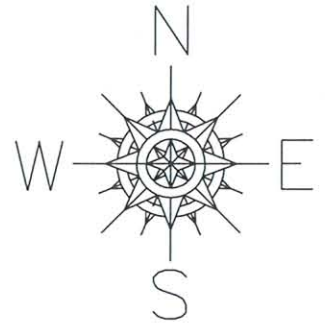

VERMILION SHORES CONDOMINIUMS II - PHASE 2

SITUATED IN THE CITY OF VERMILION, COUNTY OF LORAIN,
STATE OF OHIO, AND KNOWN AS BEING PART OF ORIGINAL
BROWNHelm TOWNSHIP LOT NUMBERS 04.

CERTIFICATION OF CORRECTION:

THE CERTIFICATE OF CORRECTION WAS MADE TO REVISE AN
INCORRECT LINE REFERENCE TABLE CALL ON PAGE 1 OF 6 FOR
THE ABOVE REFERENCED PLAT RECORDED IN PLAT VOLUME 103,
PAGES 98-103.

Brent D. Anderson
BRENT D. ANDERSON, P.S.



10/04/2017
DATE

L-25	35.00'	S 79°48'10" E
L-26	136.00'	S 10°11'50" W
L-27	110.87'	N 15°15'36" E
L-28	64.99'	N 41°34'52" E
L-29	42.30'	S 37°43'22" E
L-29	29.77'	S 37°43'22" E

L-30

VERMILION SHORES
CONDOMINIUMS II - PHASE 2
CERTIFICATE OF CORRECTION
SITUATED IN THE CITY OF VERMILION, COUNTY OF LORAIN, STATE
OF OHIO AND KNOWN AS BEING PART OF ORIGINAL BROWNHelm
TOWNSHIP LOT NUMBER 04.

VERMILION SHORES PHASE 2, LLC
4835 MUNSON STREET NW
CANTON, OHIO 44718




RAFTER A, LTD
LAND SURVEYING & ENGINEERING

Office: 440-458-6294
Fax: 440-458-4483
www.RafterA.com

10980 LaGrange Road
Elyria, Ohio 44035

DRAWN BY: BDA
JOB No: 1236F-17

CHECKED BY: RAF
SHEET 1 of 1

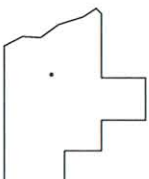

SPLITS/DEEDS PROCESSED

LORAIN COUNTY TAX MAP DEPARTMENT
226 MIDDLE AVE. ELYRIA, OHIO

SURVEYED BY: BRENT D. ANDERSON

CLOSURE: NA

MAP PAGE(S): 01-00-004

APPROVED BY: TJS DATE: 10/6/17

SCALE: 1"= 100 PRIOR INST.: PV. 103/98