
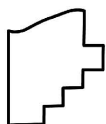


PARENT PARCEL: 06-25-001-000-077, -240, 06-25-007-000-241

CHILD PARCEL: 06-25-001-000-242 THRU -246, 06-25-007-000-267

STARTING POINT: INTERSECTION OF C/L OF MICHAEL PKWY AND C/L OF SUGAR LN.

18-03781

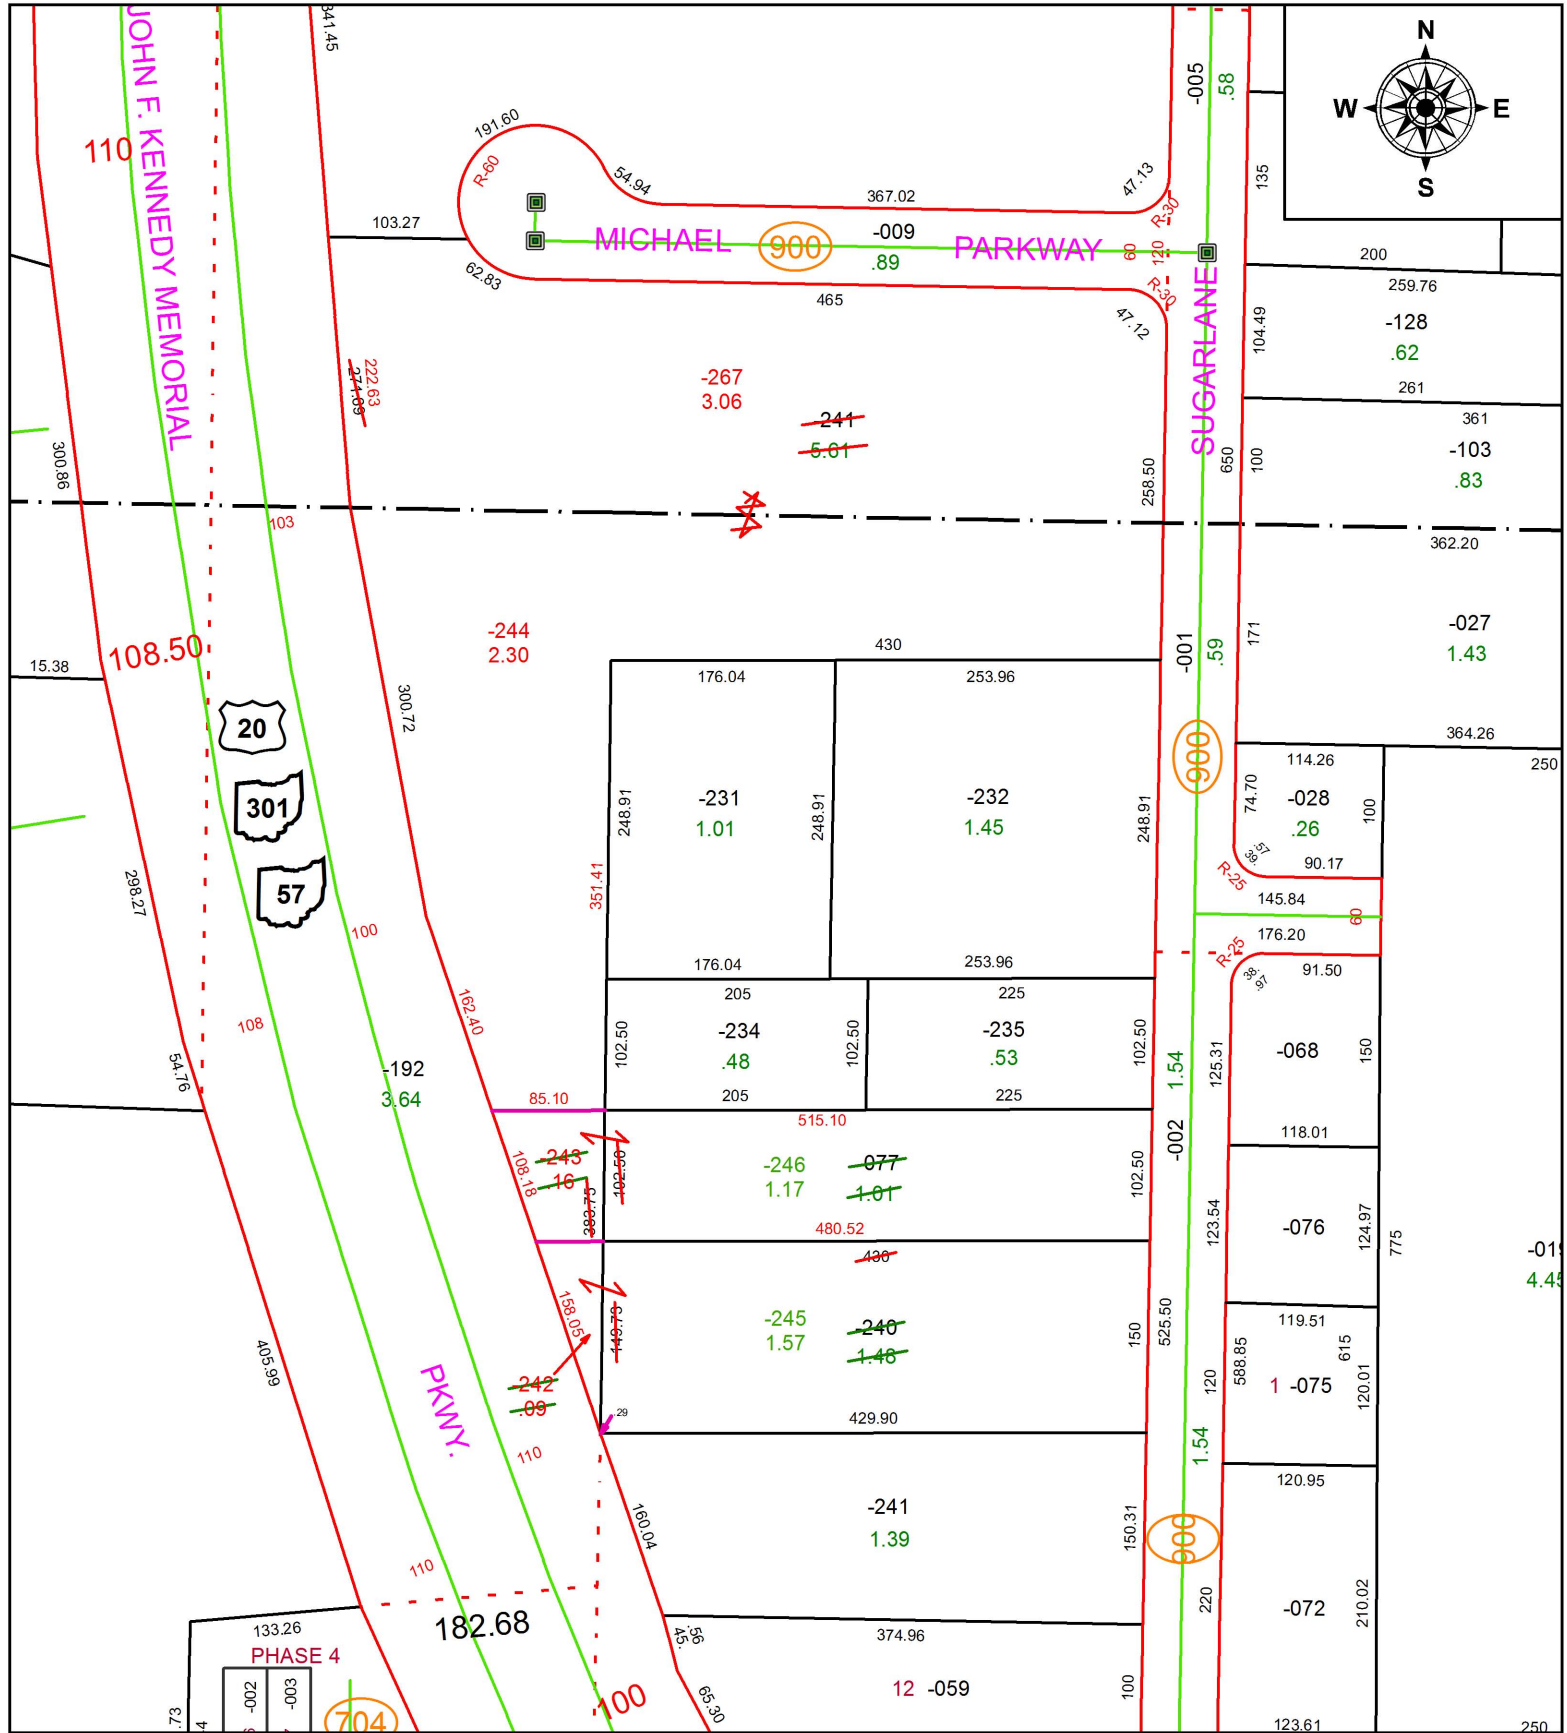

**SPLITS/DEEDS PROCESSED**  
 LORAIN COUNTY TAX MAP DEPARTMENT  
 226 MIDDLE AVE. ELYRIA, OH

SURVEYED BY: THOMAS A. SIMON

CLOSURE: 1: 88,442

MAP PAGE(S): 6-143

APPROVED BY: RRM DATE: 2-7-18

SCALE: 1" = 150 PRIOR INSTRUMENT: 19990641102