

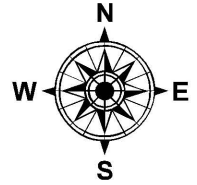


PARENT PARCEL: 03-00-098-128-020  
CHILD PARCEL: XX-XX-XXX-XXX-XXX  
STARTING POINT:

17-03785-C

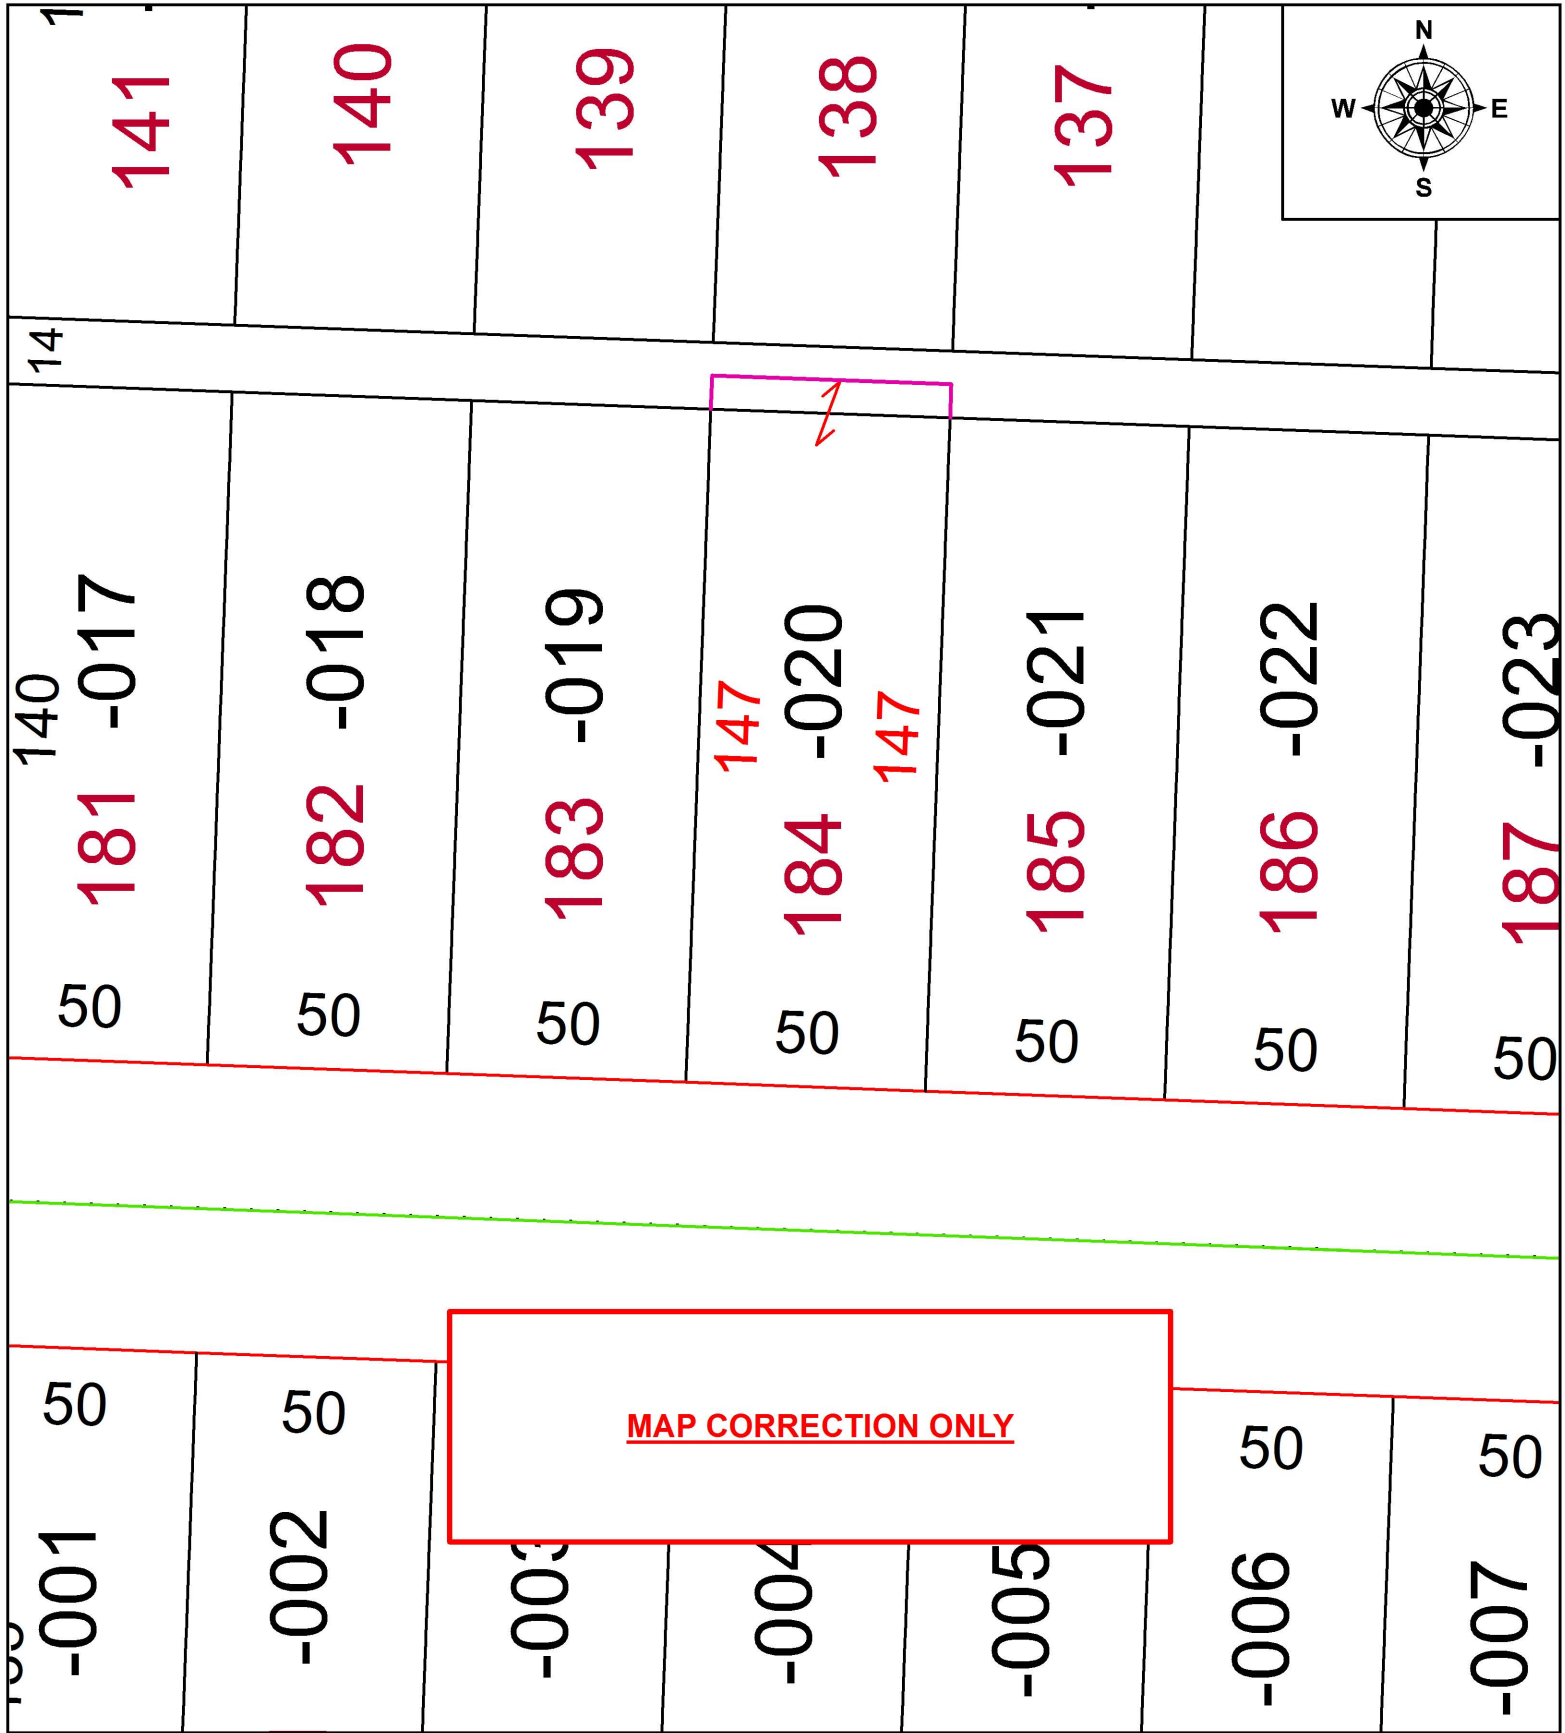

MAP CORRECTION ONLY

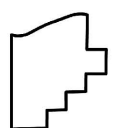

**SPLITS/DEEDS PROCESSED**  
LORAIN COUNTY TAX MAP DEPARTMENT  
226 MIDDLE AVE. ELYRIA, OH

SURVEYED BY: \_\_\_\_\_ N/A  
CLOSURE: \_\_\_\_\_ N/A  
MAP PAGE(S): \_\_\_\_\_ 3-00-098  
APPROVED BY: \_\_\_\_\_ RRM DATE: \_\_\_\_\_ 10-13-17  
SCALE: \_\_\_\_\_ 1" = 50 \_\_\_\_\_ PRIOR INSTRUMENT: \_\_\_\_\_ 20170636575