


PARENT PARCEL: 07-00-013-000-129, -206

CHILD PARCEL: 07-00-013-000-468, 07-00-014-103-329

STARTING POINT: INTERSECTION OF C/L OF BUTTERNUT RIDGE RD. AND C/L OF DEER RUN DR.

18-03785

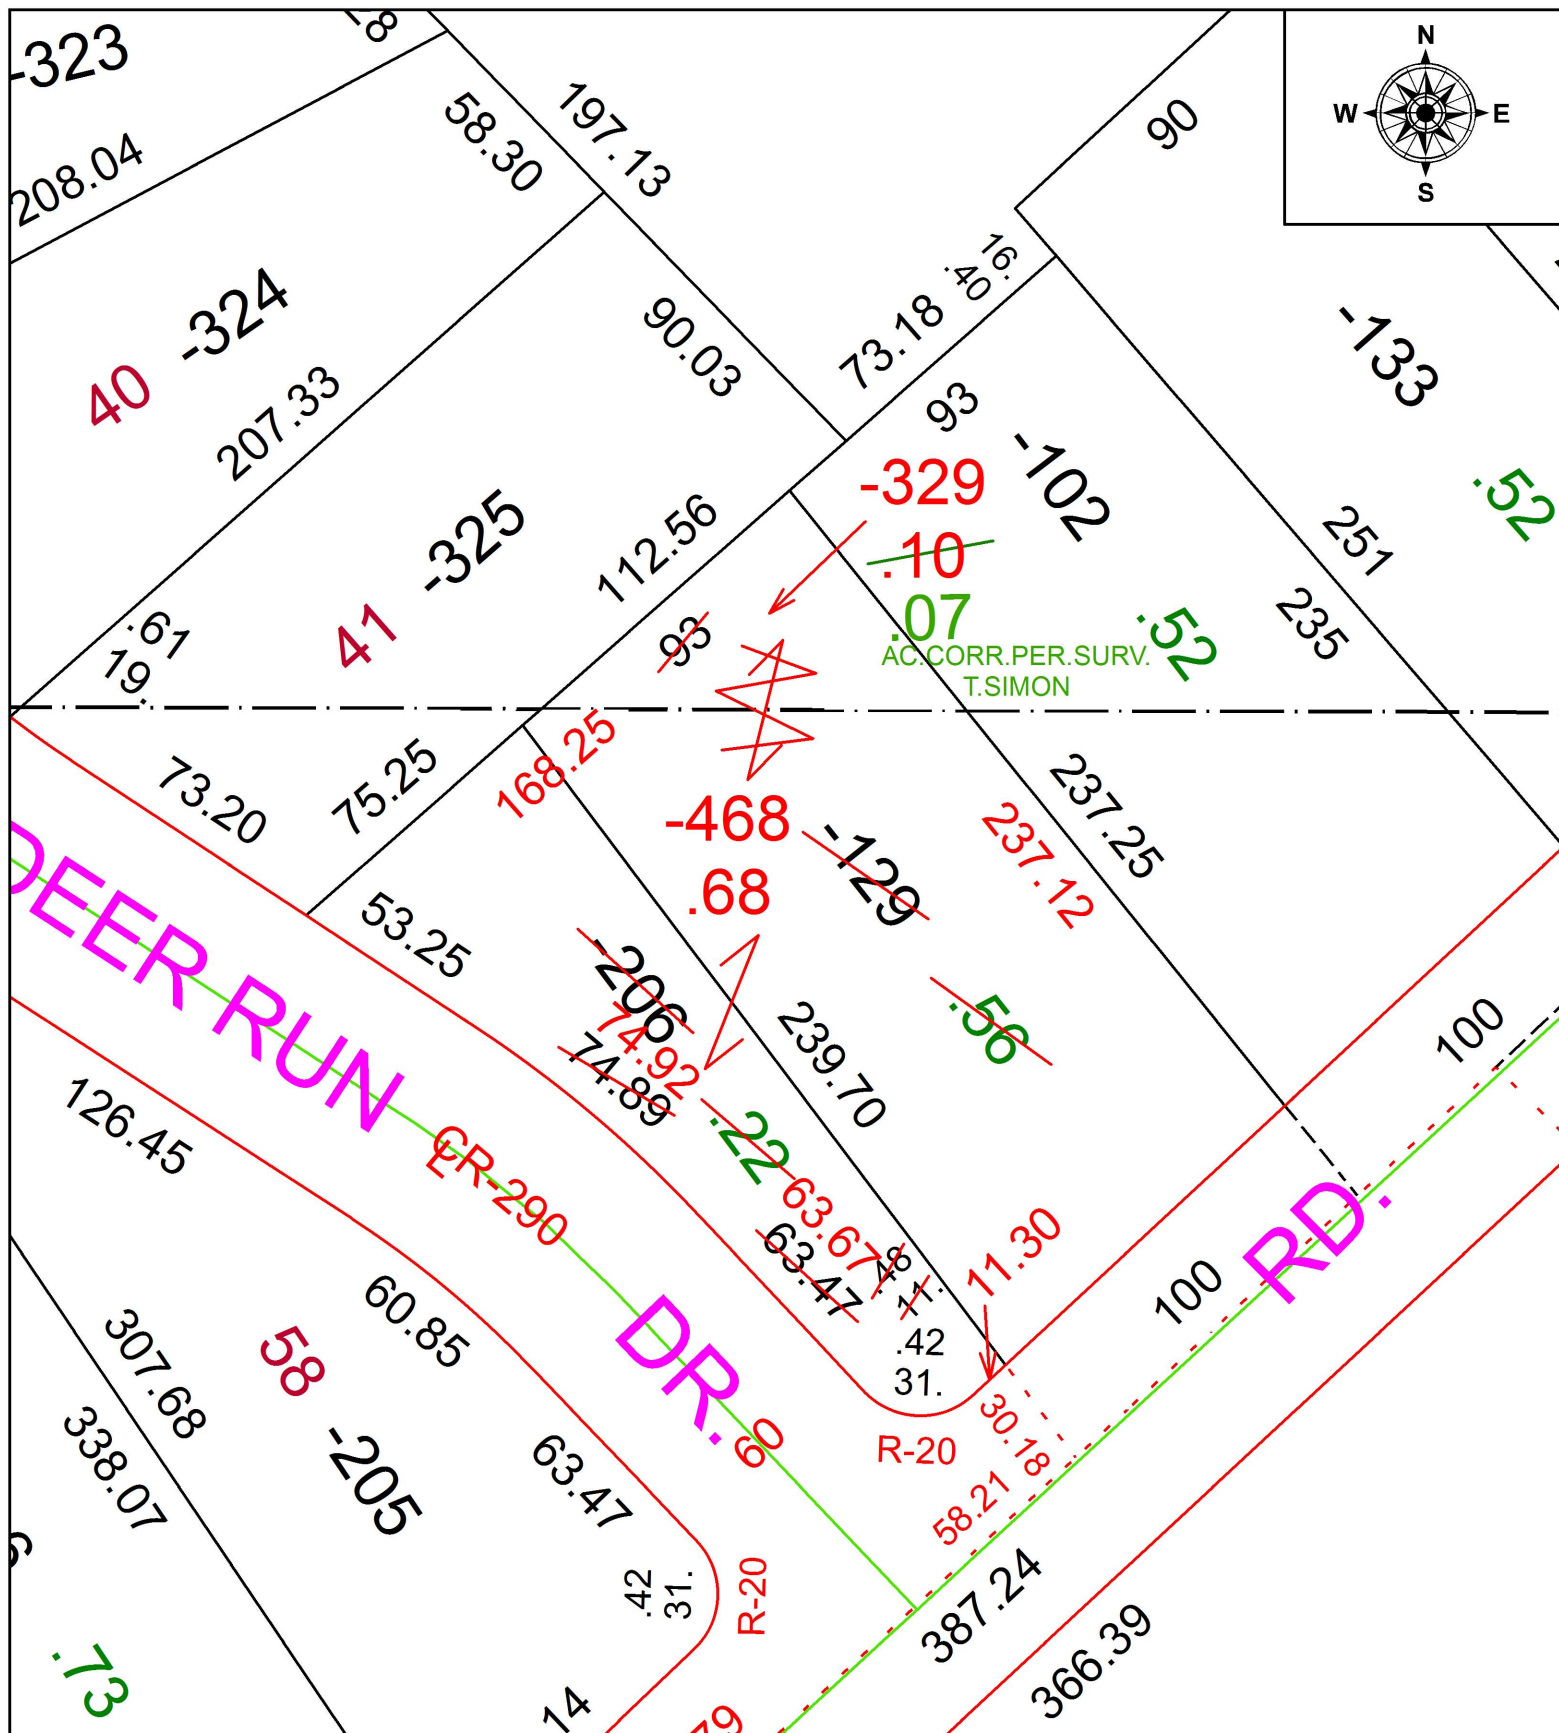

SPLITS/DEEDS PROCESSED
 LORAIN COUNTY TAX MAP DEPARTMENT
 226 MIDDLE AVE. ELYRIA, OH

SURVEYED BY: THOMAS A. SIMON
 CLOSURE: 1: 158,358
 MAP PAGE(S): 7-00-013
 APPROVED BY: RRM DATE: 2-15-18
 SCALE: 1" = 50' PRIOR INSTRUMENT: 20070193413