


PARENT PARCEL: 09-00-088-105-006, 09-00-088-106-009, -053, 09-00-098-000-053

CHILD PARCEL: 09-00-088-105-054 THRU -056, 09-00-098-000-062, -063

STARTING POINT: SOUTHWEST CORNER OF O.L.88

18-03788

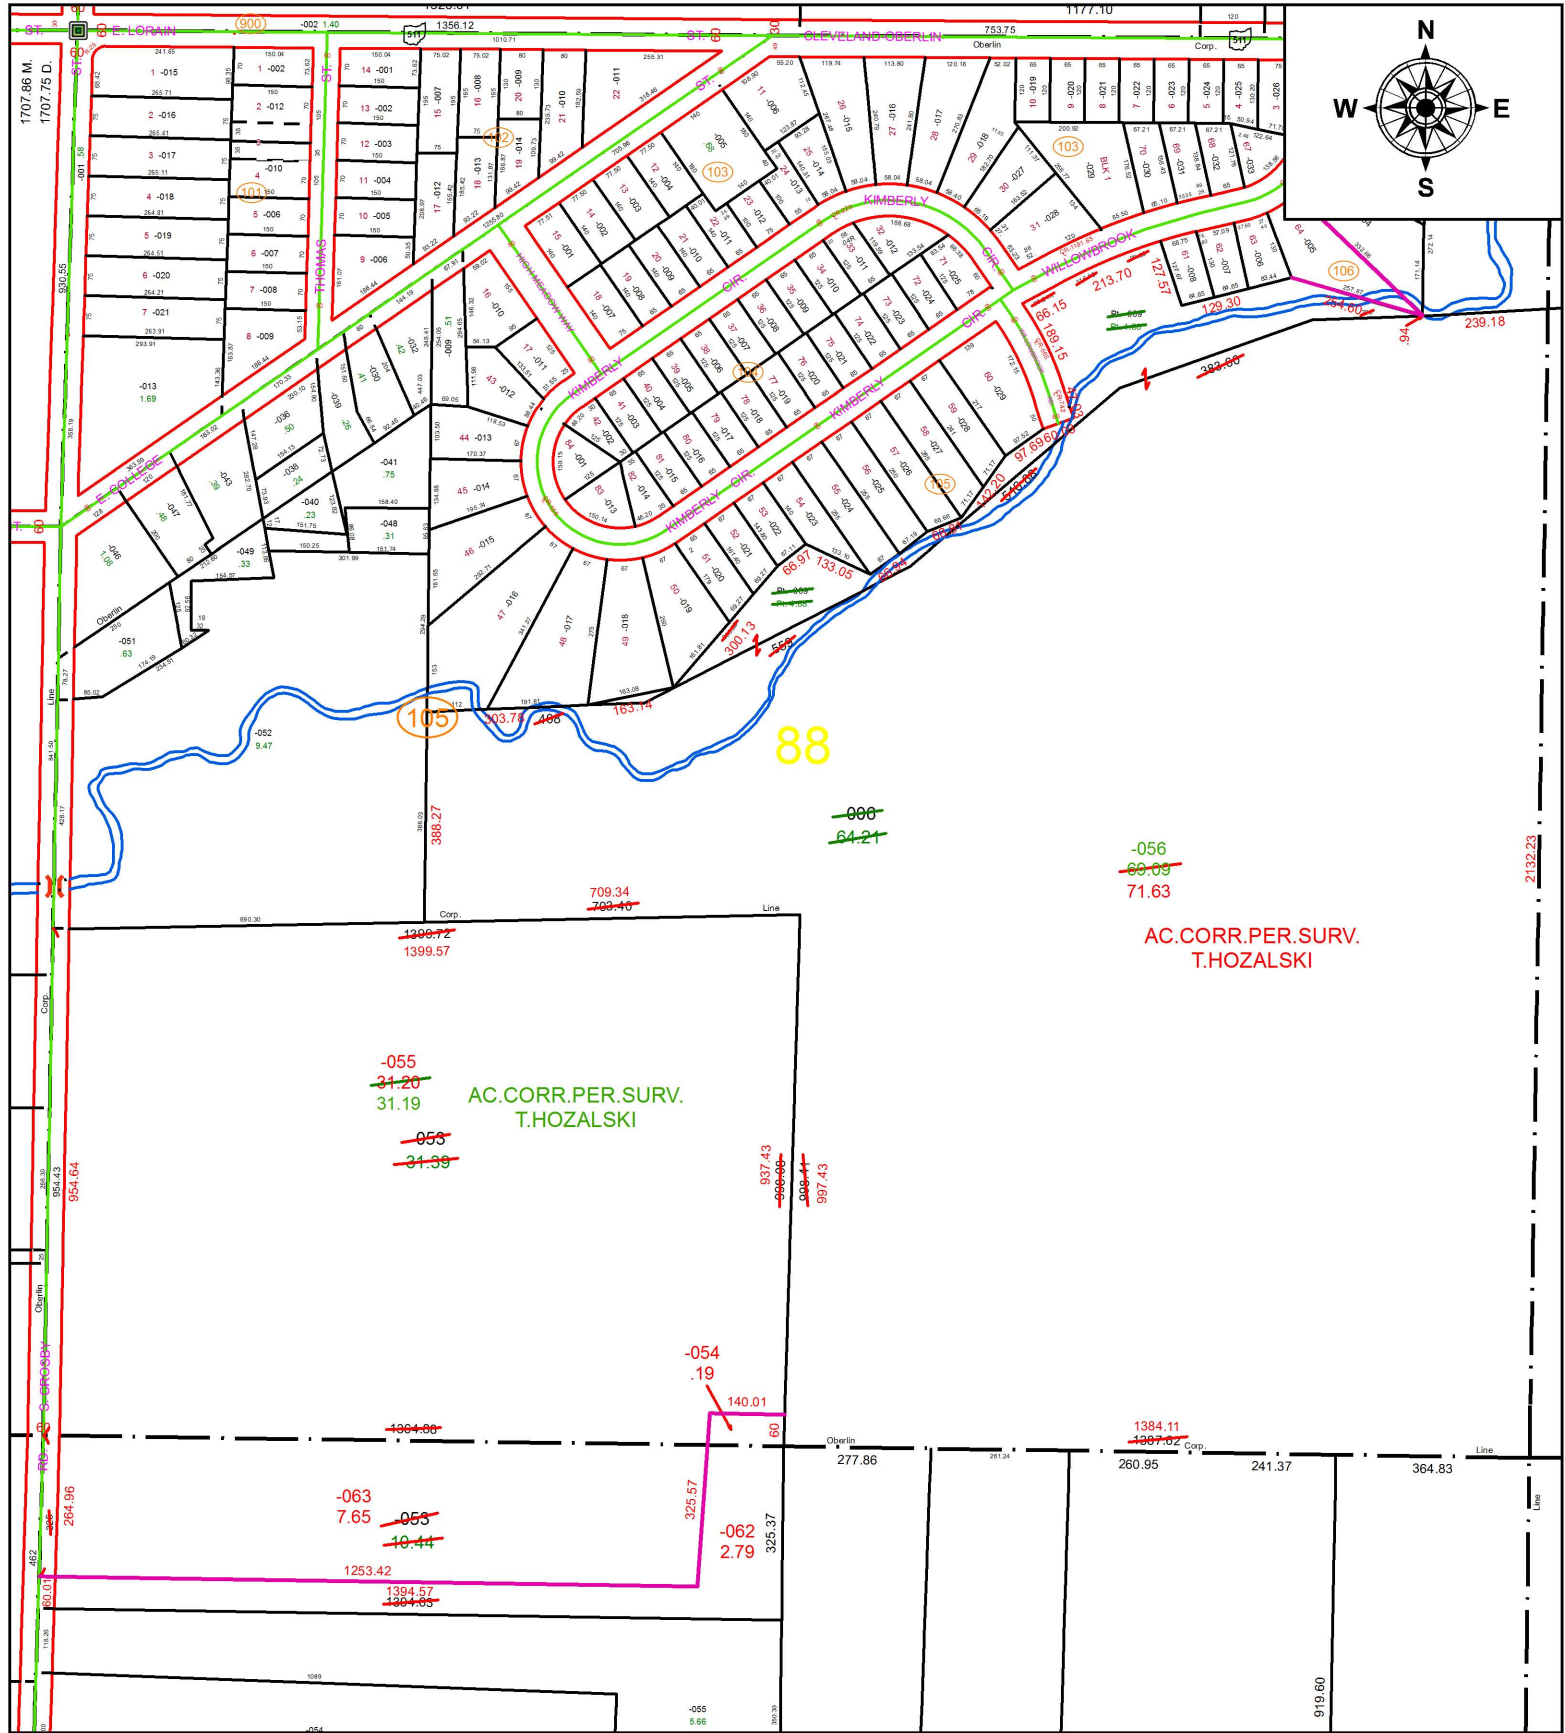

88

AC.CORR.PER.SURV.
T.HOZALSKI

AC.CORR.PER.SURV.
T.HOZALSKI

SPLITS/DEEDS PROCESSED
 LORAIN COUNTY TAX MAP DEPARTMENT
 226 MIDDLE AVE. ELYRIA, OH

SURVEYED BY: TIMOTHY D. HOZALSKI
CLOSURE: 1: 439,537
MAP PAGE(S): 9-00-088
APPROVED BY: RRM **DATE:** 2-27-18
SCALE: 1" = 360 **PRIOR INSTRUMENT:** 20040006381