
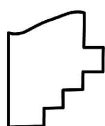


PARENT PARCEL: 12-00-015-000-035, -092, -093

CHILD PARCEL: 12-00-015-000-096

STARTING POINT: SOUTHWEST CORNER OF O.L.15

18-03795

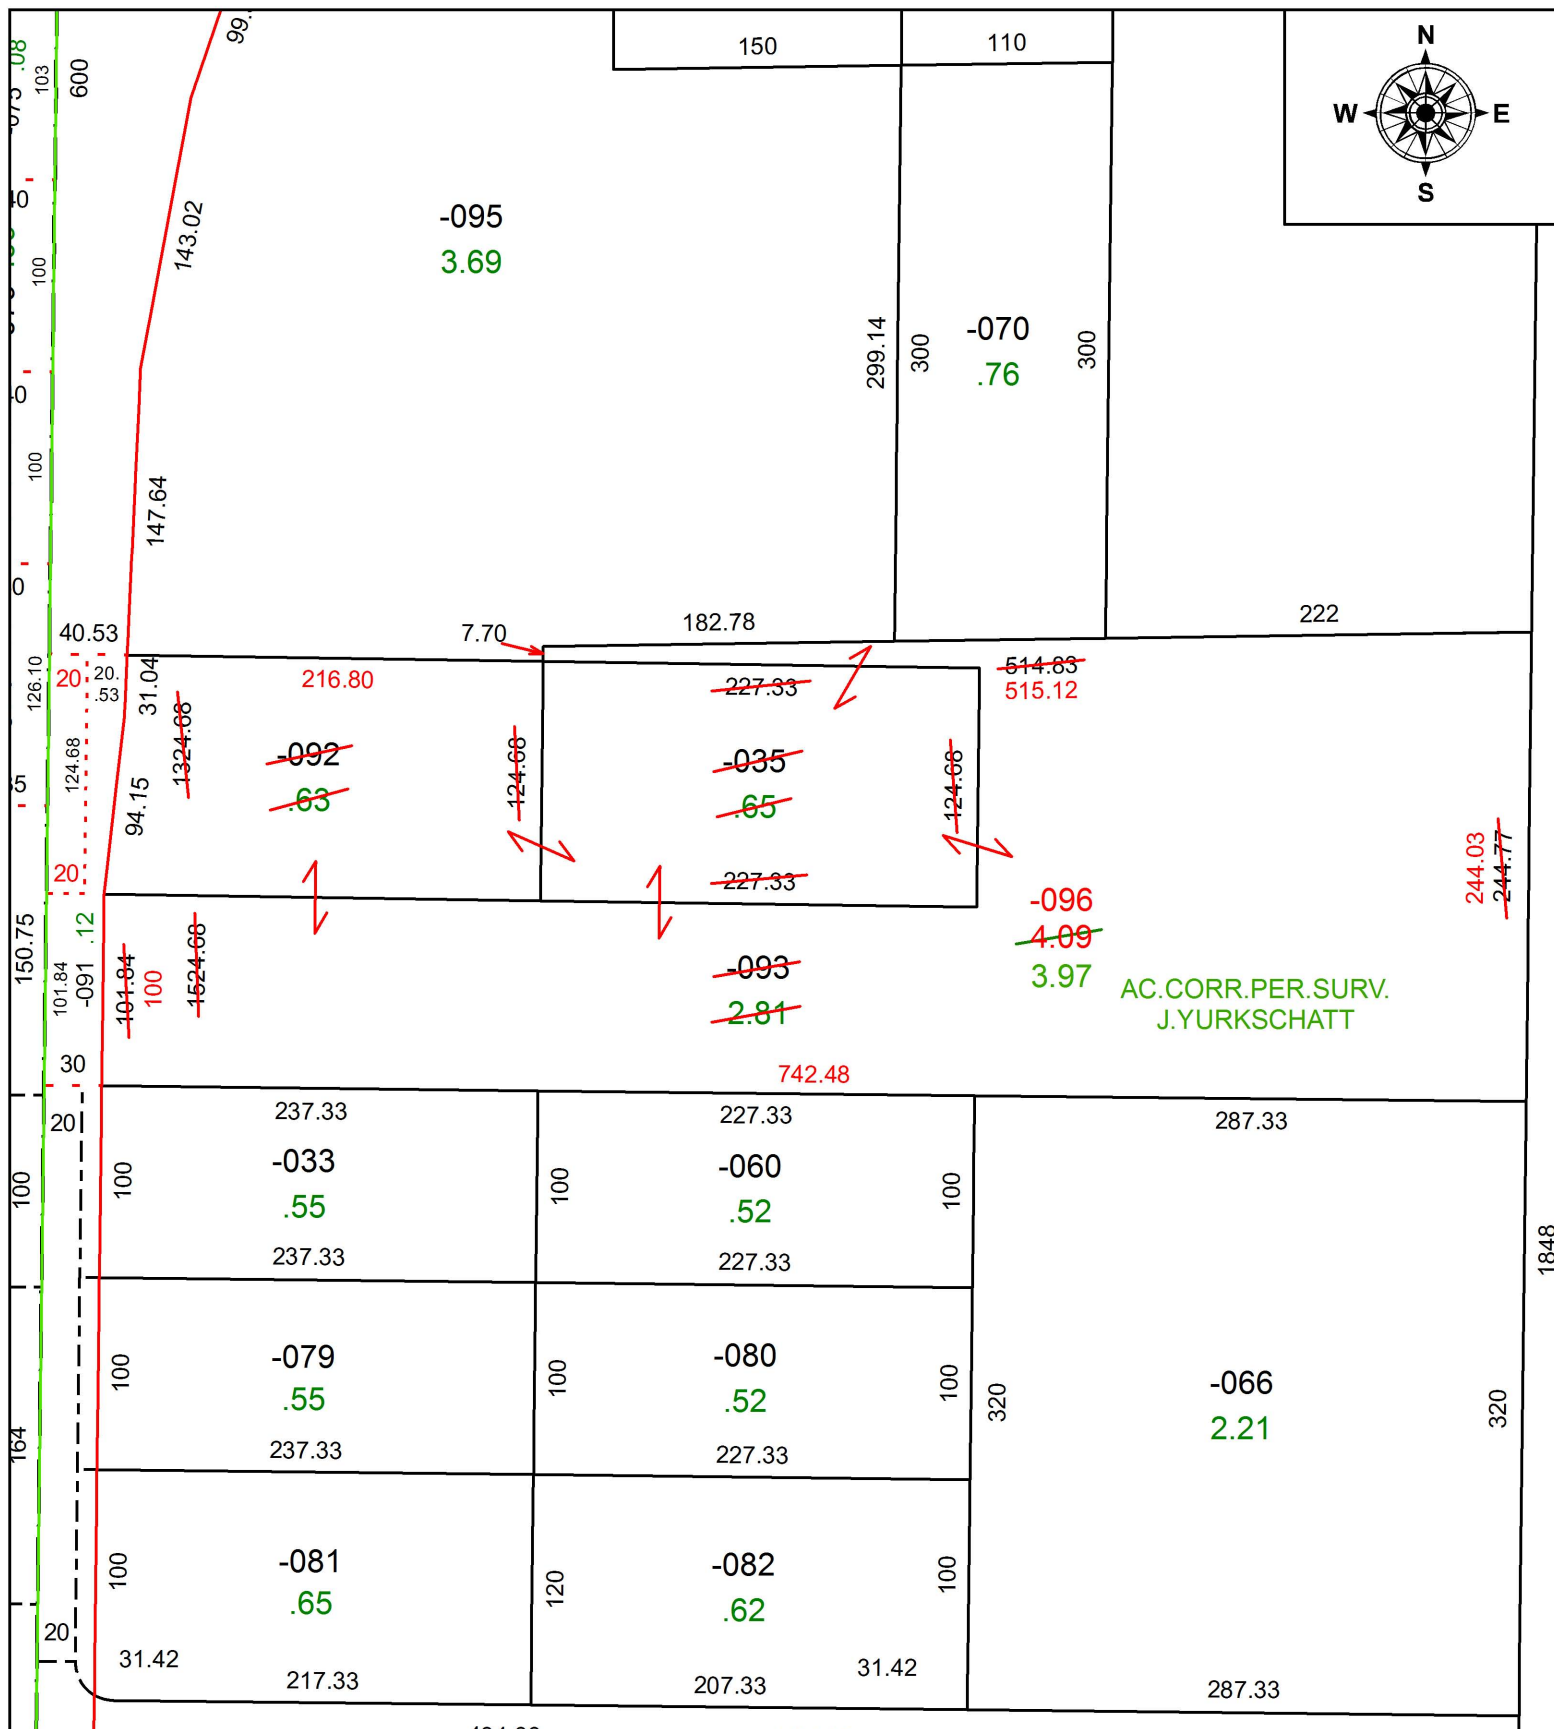

SPLITS/DEEDS PROCESSED
 LORAIN COUNTY TAX MAP DEPARTMENT
 226 MIDDLE AVE. ELYRIA, OH

SURVEYED BY: JAMES P. YURKSCHATT
 CLOSURE: 1: 478.468
 MAP PAGE(S): 12-00-015
 APPROVED BY: RRM DATE: 3-19-18
 SCALE: 1" = 100 PRIOR INSTRUMENT: 20170645081