


PARENT PARCEL: 07-00-008-115-085, -086, -087, -088, -095

CHILD PARCEL: 07-00-008-115-109

STARTING POINT: INTERSECTION OF C/L OF CENTER RIDGE RD. AND EAST LINE OF O.L.8

18-03796

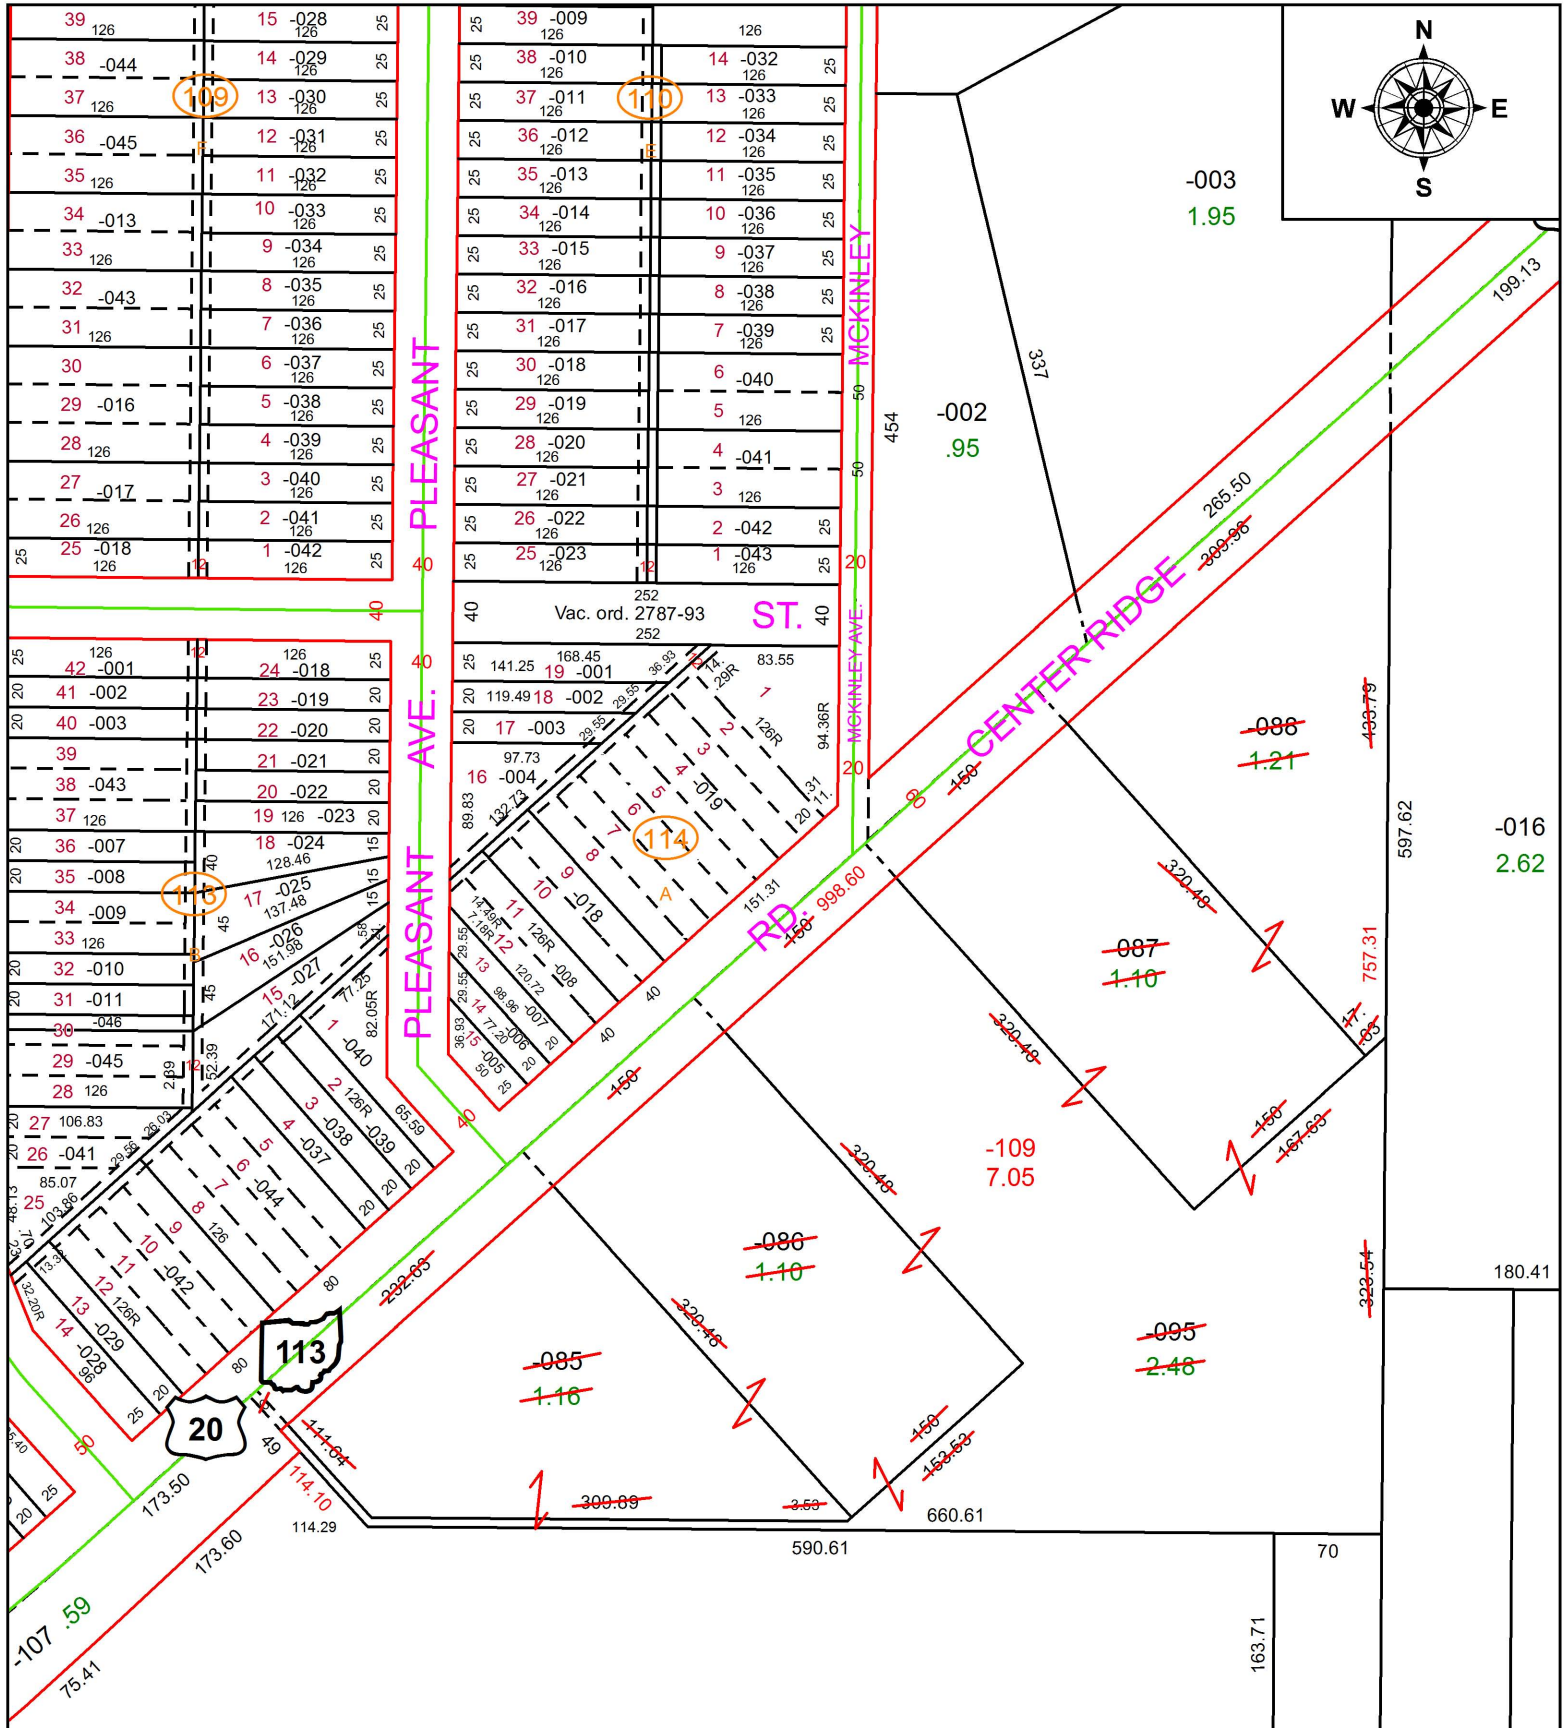

SPLITS/DEEDS PROCESSED
 LORAIN COUNTY TAX MAP DEPARTMENT
 226 MIDDLE AVE. ELYRIA, OH

SURVEYED BY: JOSEPH A. BURGOON
CLOSURE: 1: 367,247
MAP PAGE(S): 7-00-008
APPROVED BY: RRM **DATE:** 3-19-18
SCALE: 1" = 125 **PRIOR INSTRUMENT:** 20160000963