

PARENT PARCEL: 06-25-034-104-007


CHILD PARCEL: XX-XX-XXX-XXX-XXX

STARTING POINT: NORTHEAST CORNER OF S/L 22 IN PASADENA PARK ALLOT.

17-03805-D



DEPTH CORRECTION
 62 X 105.84
~~62 X 74~~
 CORR. PER SURVEY T.SIMON

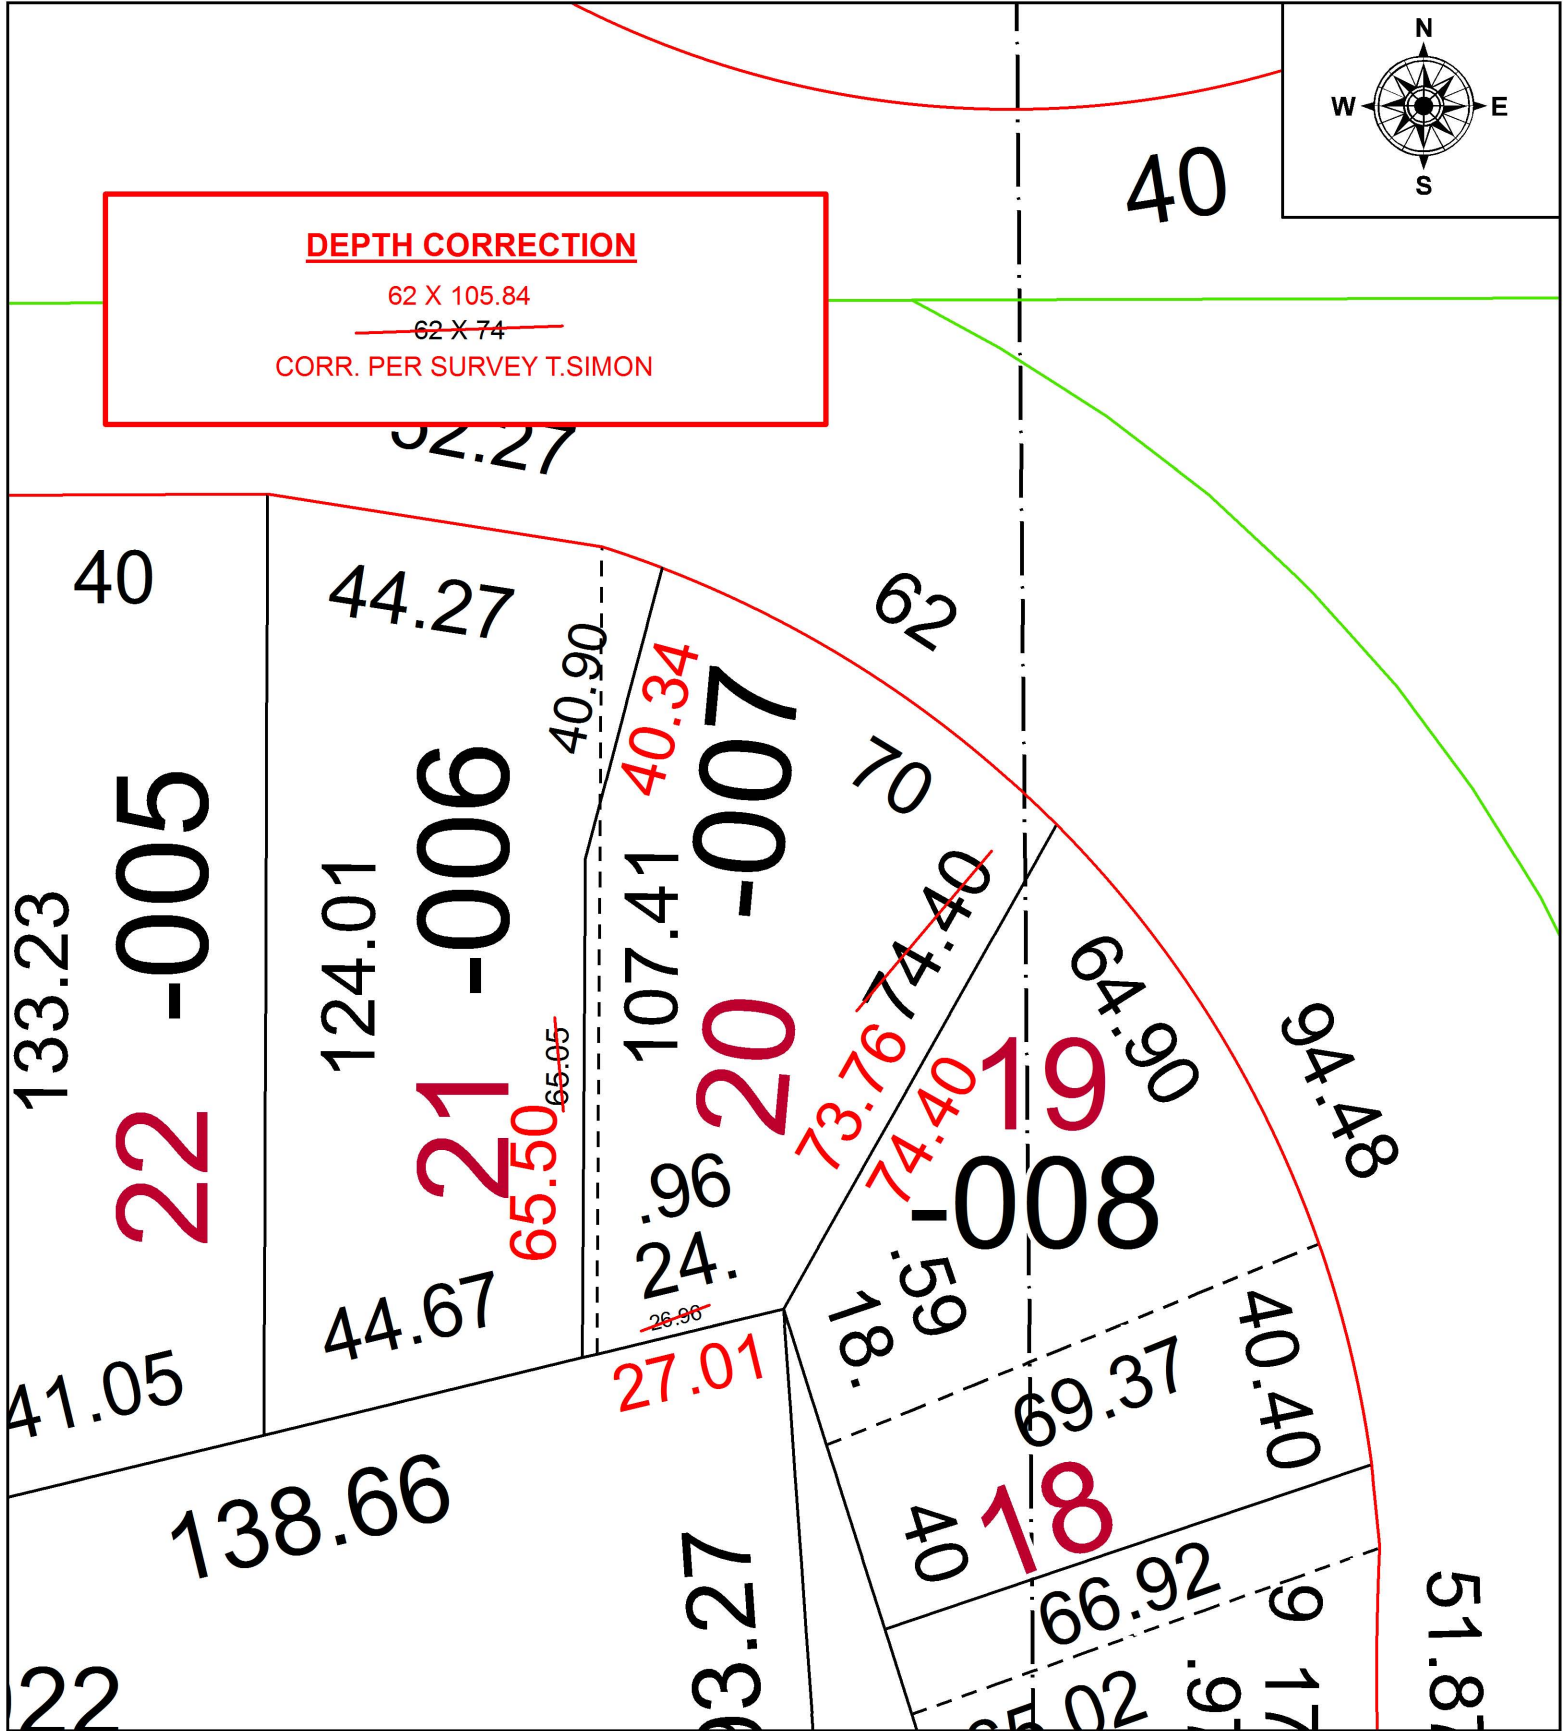

SPLITS/DEEDS PROCESSED
 LORAIN COUNTY TAX MAP DEPARTMENT
 226 MIDDLE AVE. ELYRIA, OH

SURVEYED BY: THOMAS A. SIMON
 CLOSURE: 1: 42,301
 MAP PAGE(S): 6-104
 APPROVED BY: RRM DATE: 11-29-17
 SCALE: 1" = 25' PRIOR INSTRUMENT: 20170635020