


PARENT PARCEL: 10-00-009-113-040

CHILD PARCEL: 10-00-009-113-044, -045

STARTING POINT: S/L 25 AND PART OF S/L 24 IN MEADOW VIEW ALLOTMENT

17-03807-U

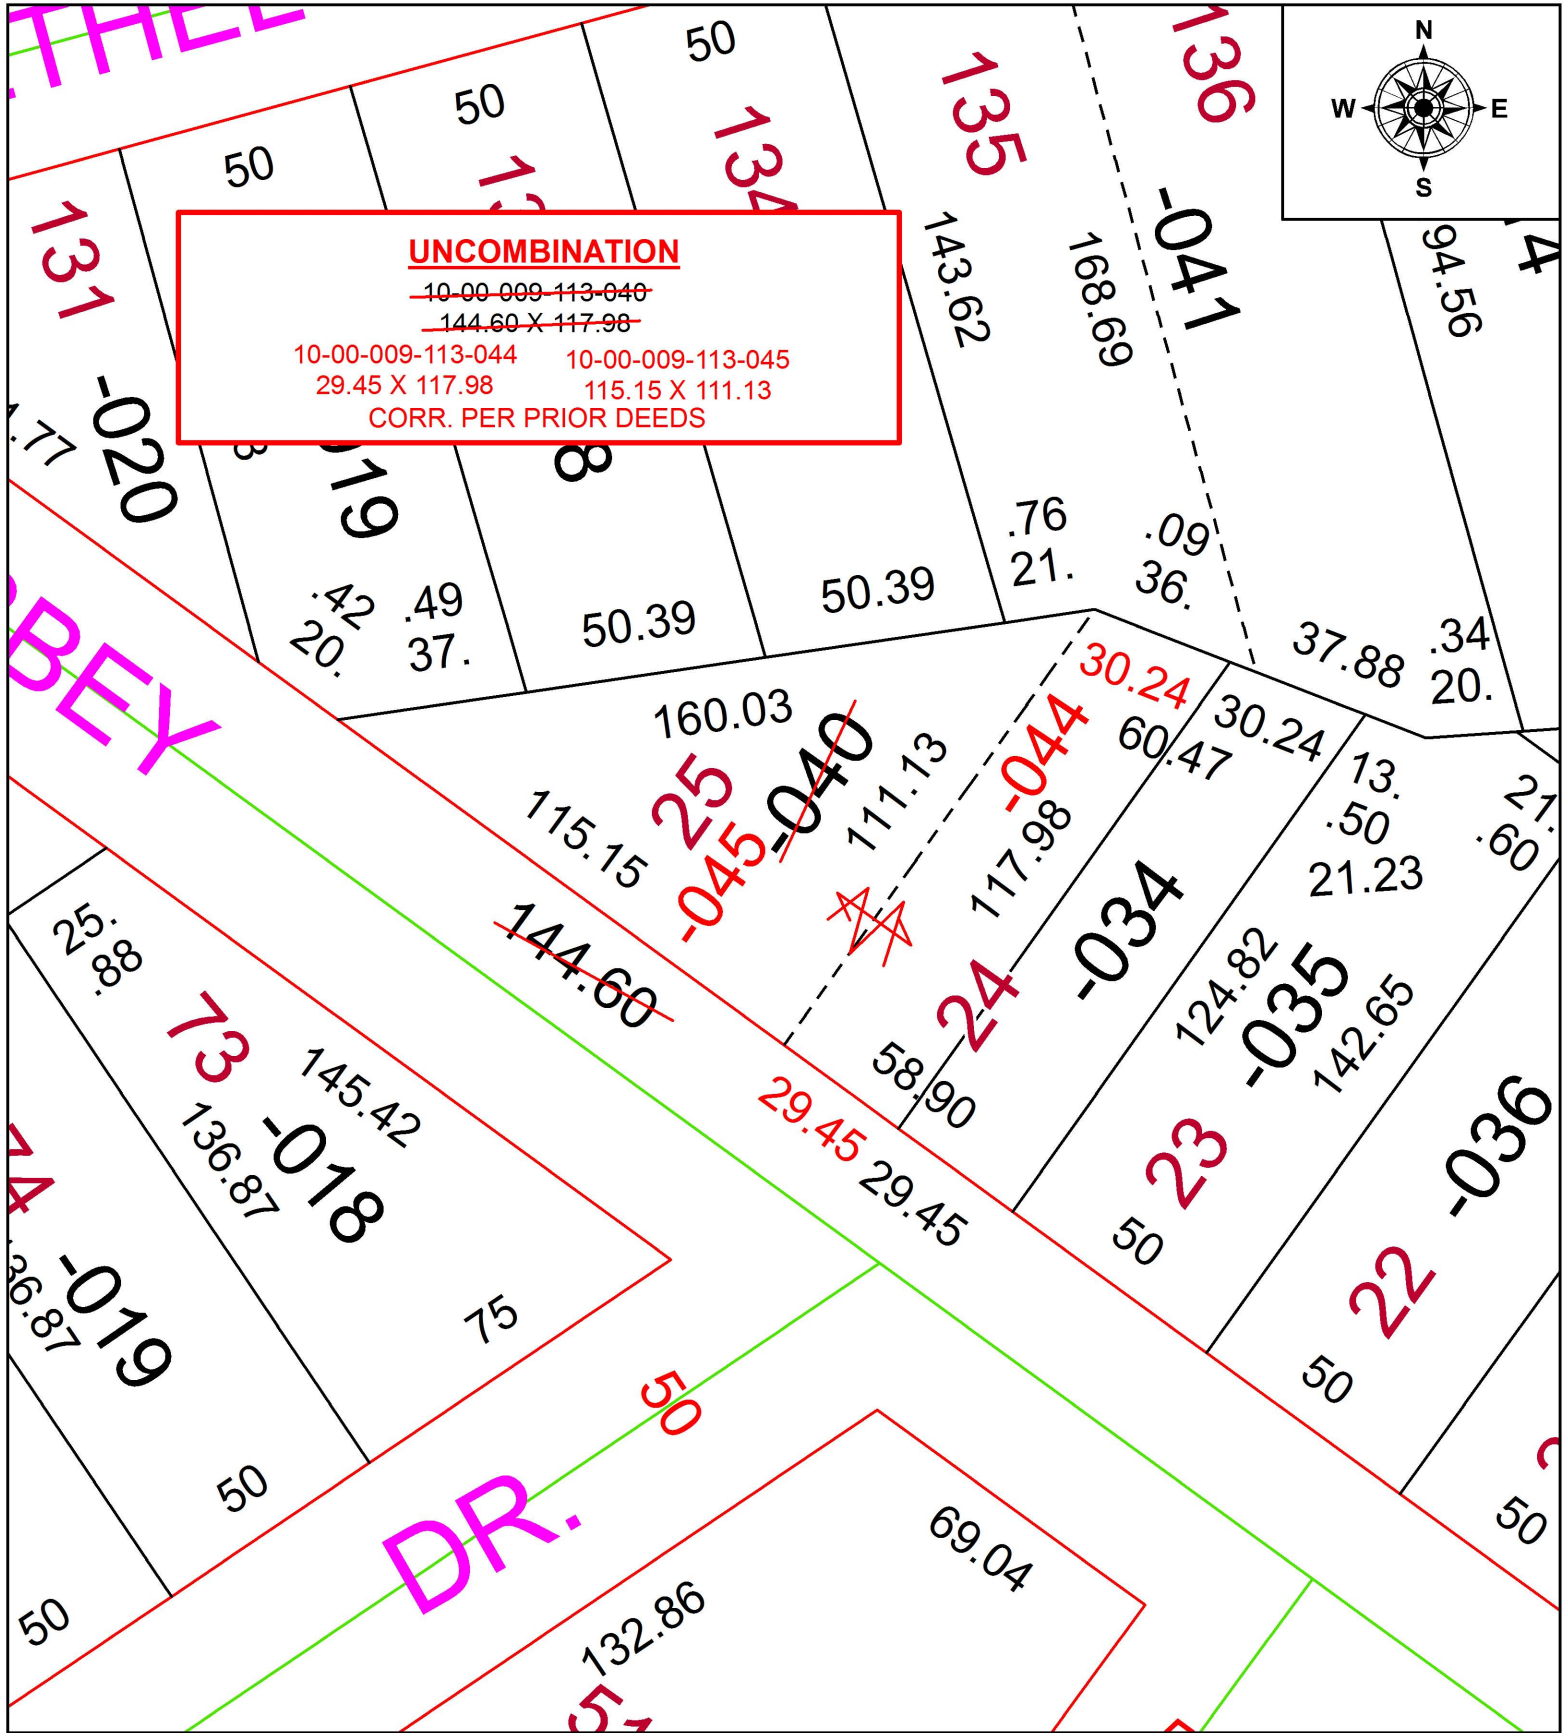

UNCOMBINATION
~~10-00-009-113-040~~
~~144.60 X 117.98~~
10-00-009-113-044 10-00-009-113-045
29.45 X 117.98 115.15 X 111.13
CORR. PER PRIOR DEEDS



SPLITS/DEEDS PROCESSED
LORAIN COUNTY TAX MAP DEPARTMENT
226 MIDDLE AVE. ELYRIA, OH

SURVEYED BY: _____ N/A
CLOSURE: _____ N/A
MAP PAGE(S): _____ 10-00-009
APPROVED BY: _____ RRM DATE: _____ 11-30-17
SCALE: _____ 1" = 40 PRIOR INSTRUMENT: _____ 20080259207