
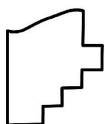


PARENT PARCEL: 01-00-043-000-002

CHILD PARCEL: XX-XX-XXX-XXX-XXX

STARTING POINT: INTERSECTION OF C/L OF CLAUS RD. AND C/L OF NORTH RIDGE RD.

17-03808-A

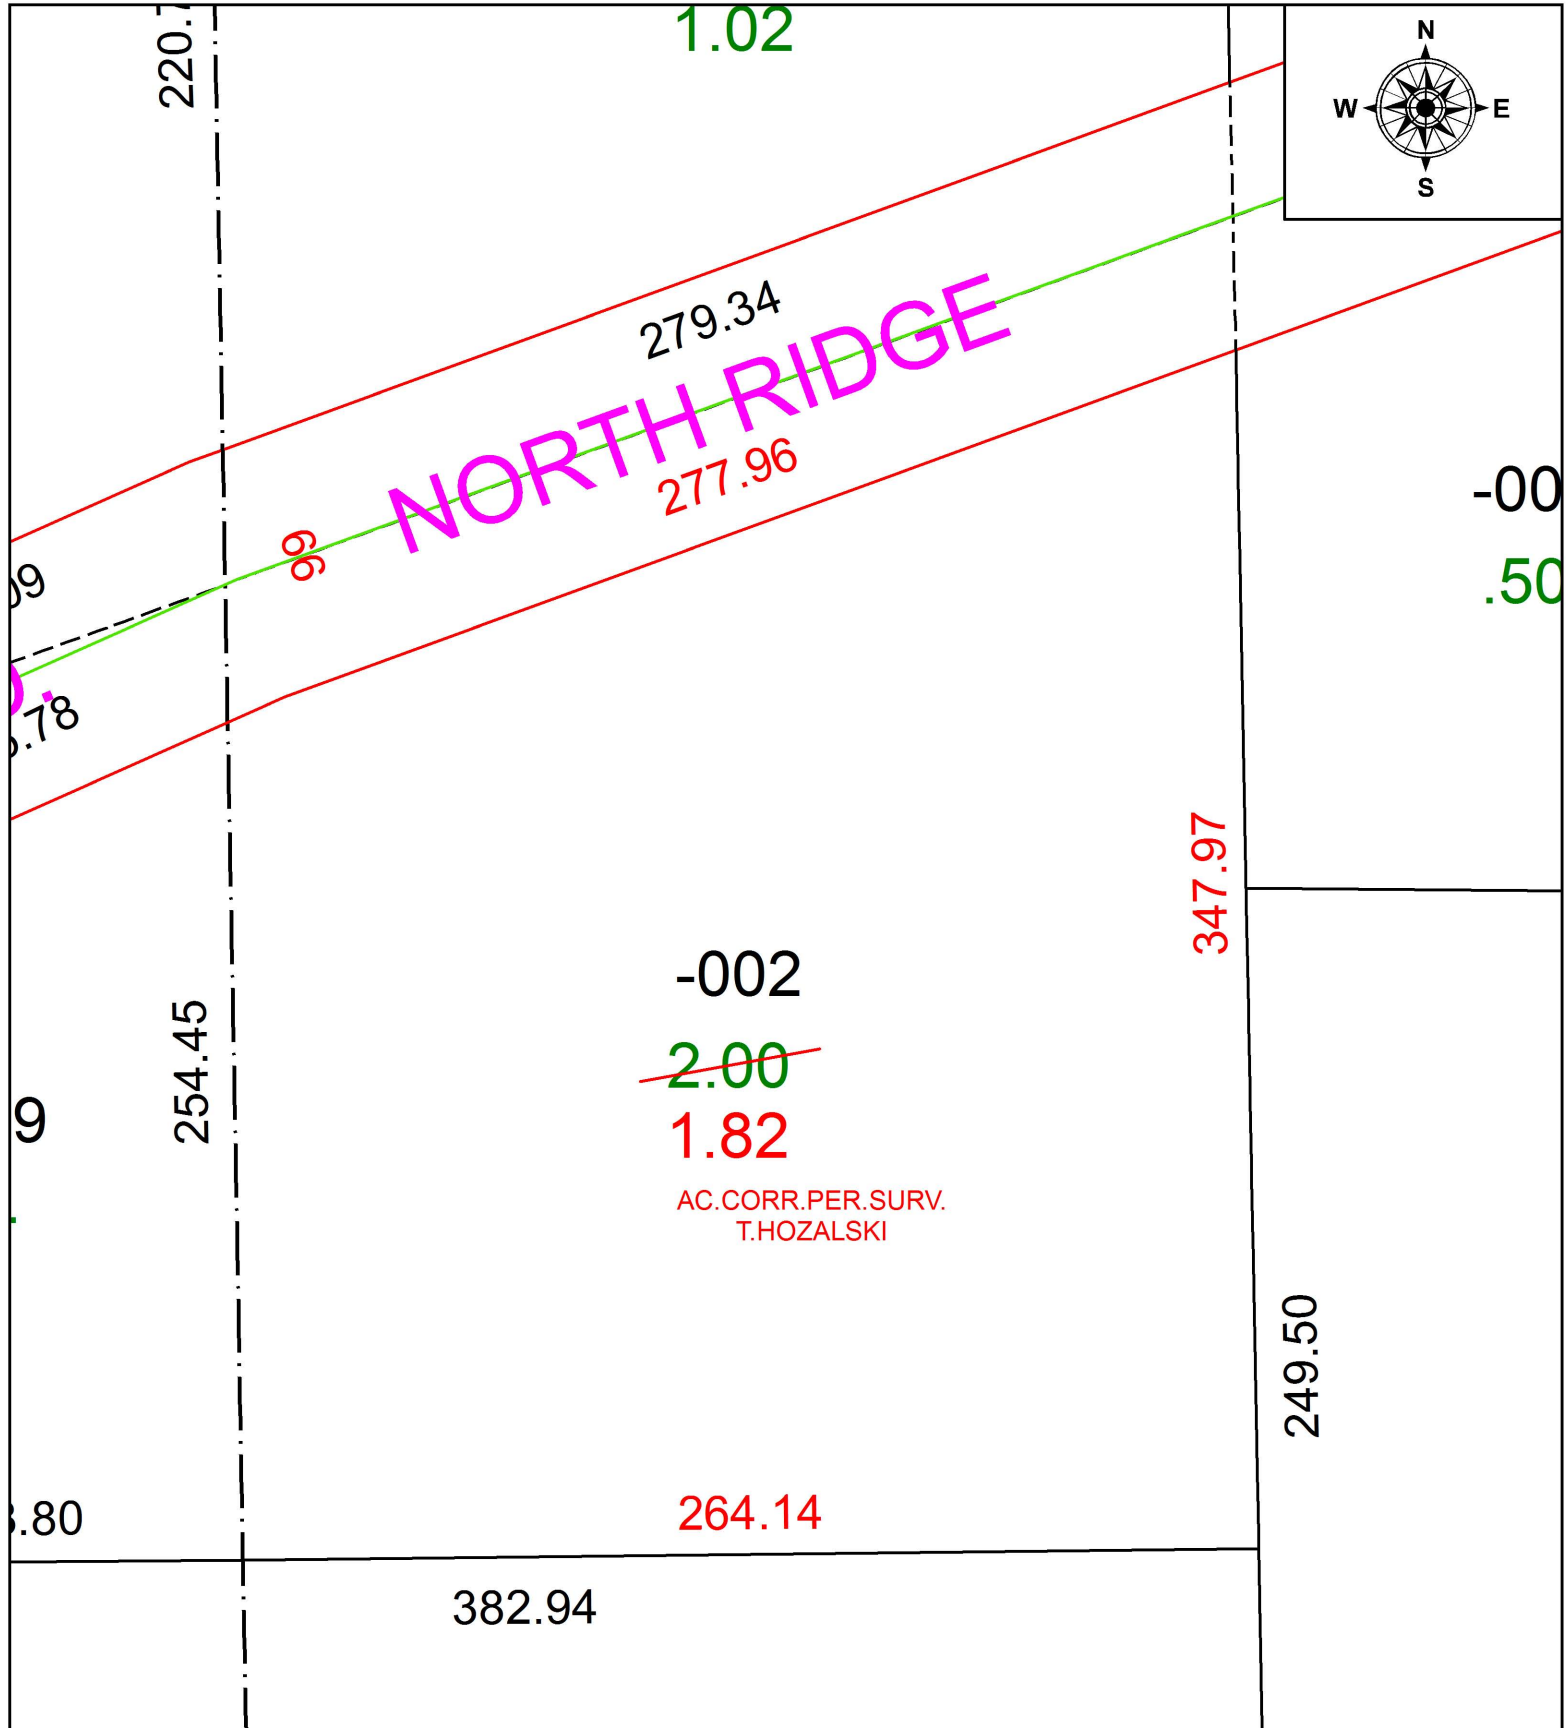

**SPLITS/DEEDS PROCESSED**  
 LORAIN COUNTY TAX MAP DEPARTMENT  
 226 MIDDLE AVE. ELYRIA, OH

SURVEYED BY: TIMOTHY D. HOZALSKI

CLOSURE: 1: 163,257

MAP PAGE(S): 1-00-043

APPROVED BY: RRM DATE: 12-7-17

SCALE: 1" = 50 PRIOR INSTRUMENT: 20170623635