


PARENT PARCEL: 05-00-060-105-011

CHILD PARCEL: XX-XX-XXX-XXX-XXX

STARTING POINT: INTERSECTION OF C/L OF NORTH RIDGE RD. AND C/L OBERLIN RD.

17-03813-D

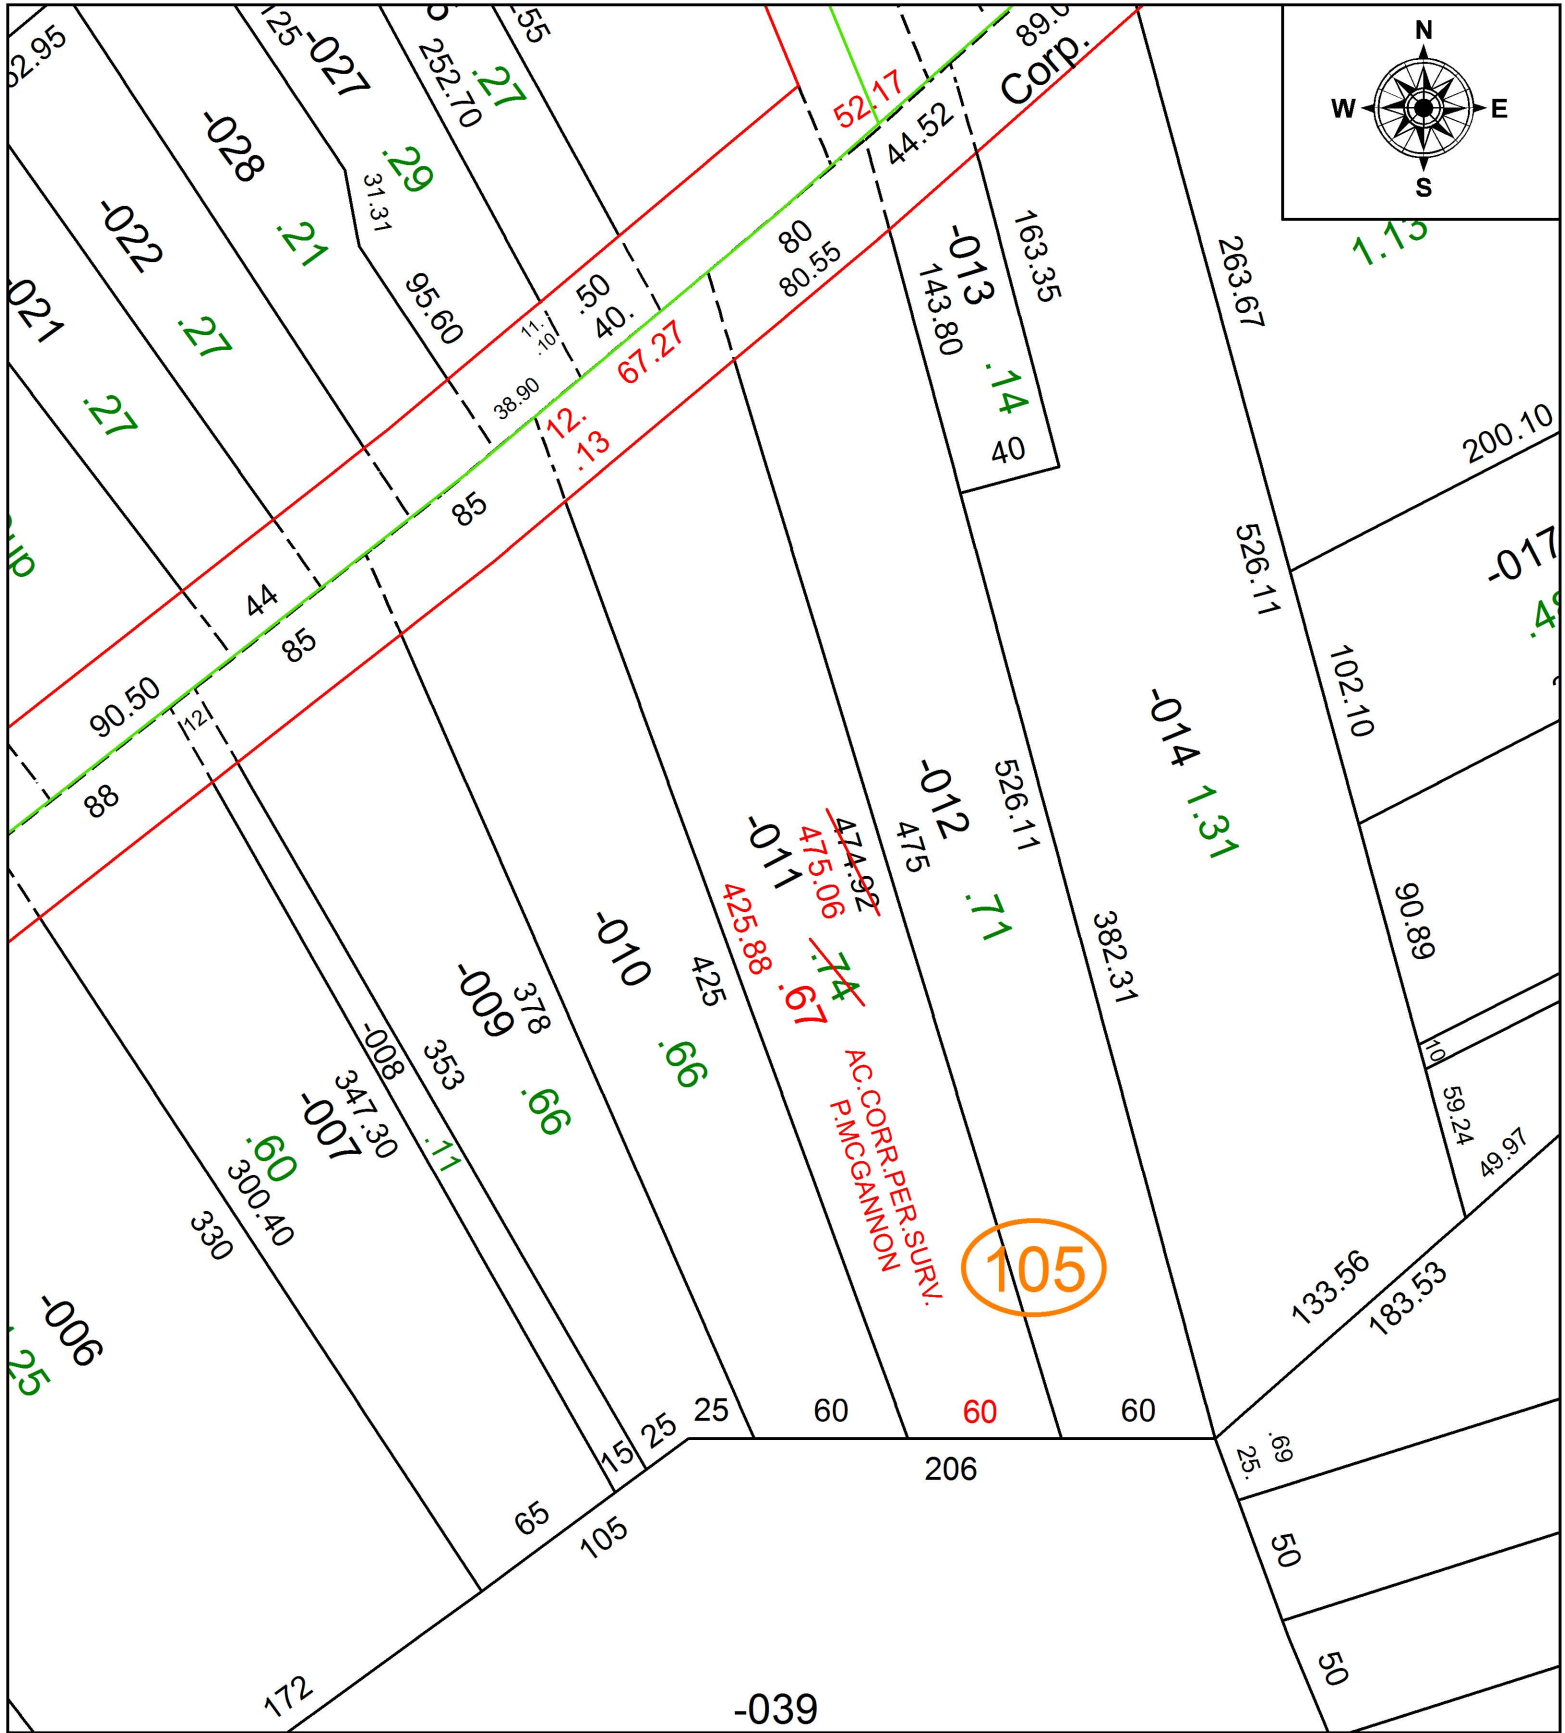

**SPLITS/DEEDS PROCESSED**  
 LORAIN COUNTY TAX MAP DEPARTMENT  
 226 MIDDLE AVE. ELYRIA, OH

**SURVEYED BY:** PATRICK A. MCGANNON  
**CLOSURE:** 1: 151,944  
**MAP PAGE(S):** 5-00-060  
**APPROVED BY:** RRM **DATE:** 12-15-17  
**SCALE:** 1" = 75 **PRIOR INSTRUMENT:** 20170649334