

PARENT PARCEL: 07-00-011-103-006, -070, 07-00-014-106-001, -004, -005


CHILD PARCEL: 07-00-011-103-186 THRU -188, 07-00-014-106-005, -007, -008

STARTING POINT: INTERSECTION OF SOUTH LINE OF O.L.11 AND C/L OF ROOT RD.

18-03819



MAP 1 OF 2

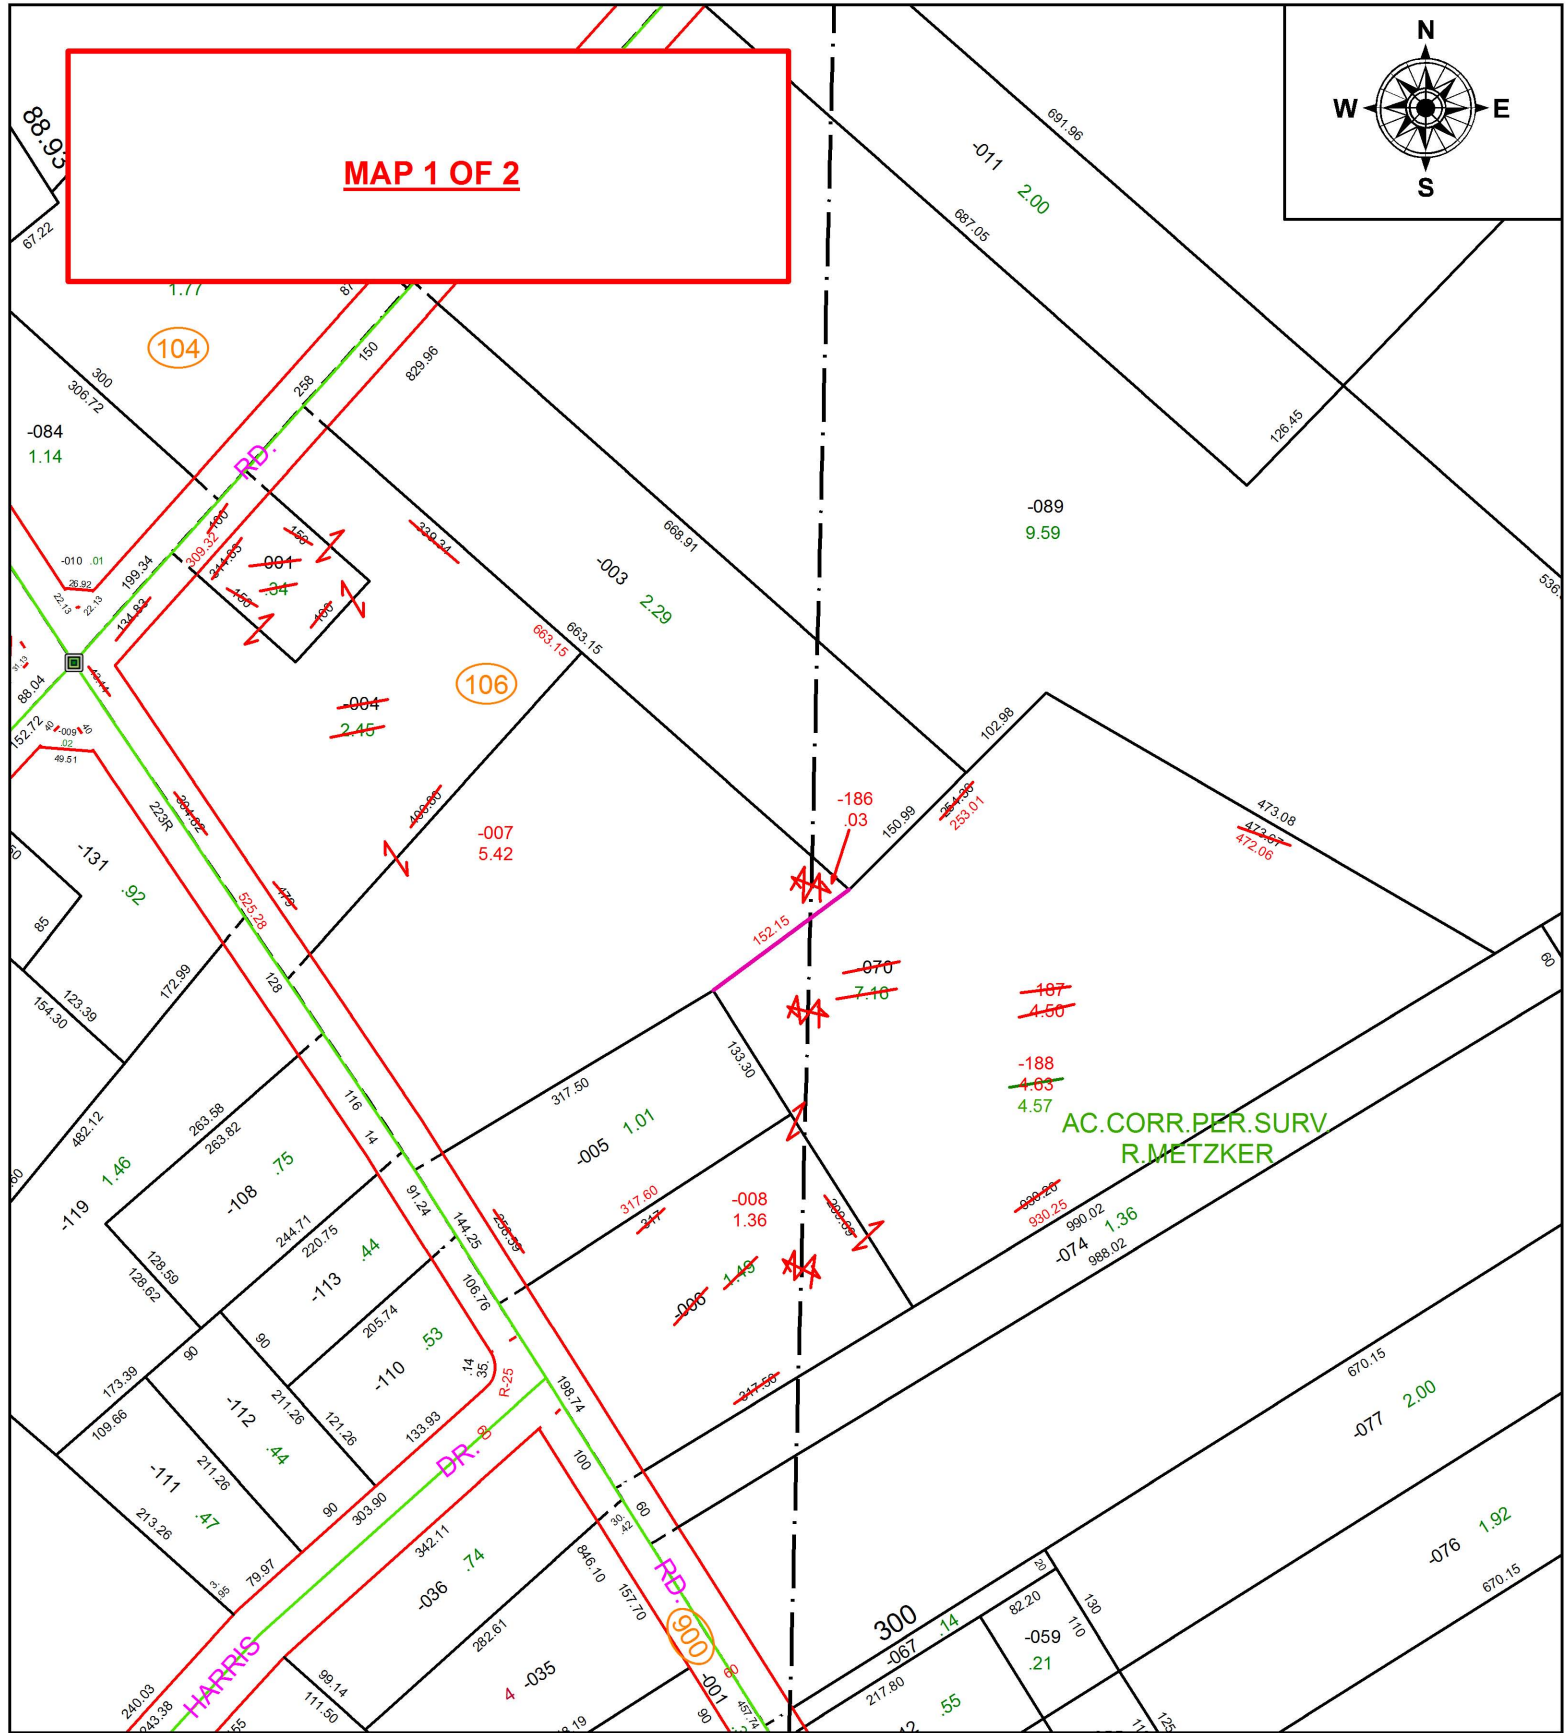

**SPLITS/DEEDS PROCESSED**  
LORAIN COUNTY TAX MAP DEPARTMENT  
226 MIDDLE AVE. ELYRIA, OH

SURVEYED BY: RICHARD METZKER

CLOSURE: 1: 162,661

MAP PAGE(S): 7-00-014

APPROVED BY: RRM DATE: 5-29-18

SCALE: 1" = 175 PRIOR INSTRUMENT: 20060182662