


PARENT PARCEL: 07-00-011-103-078



CHILD PARCEL: 07-00-011-103-189, 07-00-014-106-009

STARTING POINT: INTERSECTION OF C/L OF ROOT RD. AND SOUTH LINE OF O.L.11

18-03819

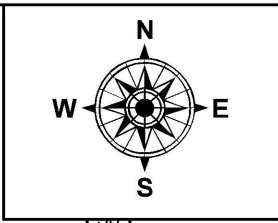

**MAP 2 OF 2**  
**UNCOMBINATION PER O.L. BREAKDOWN**

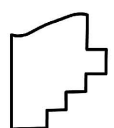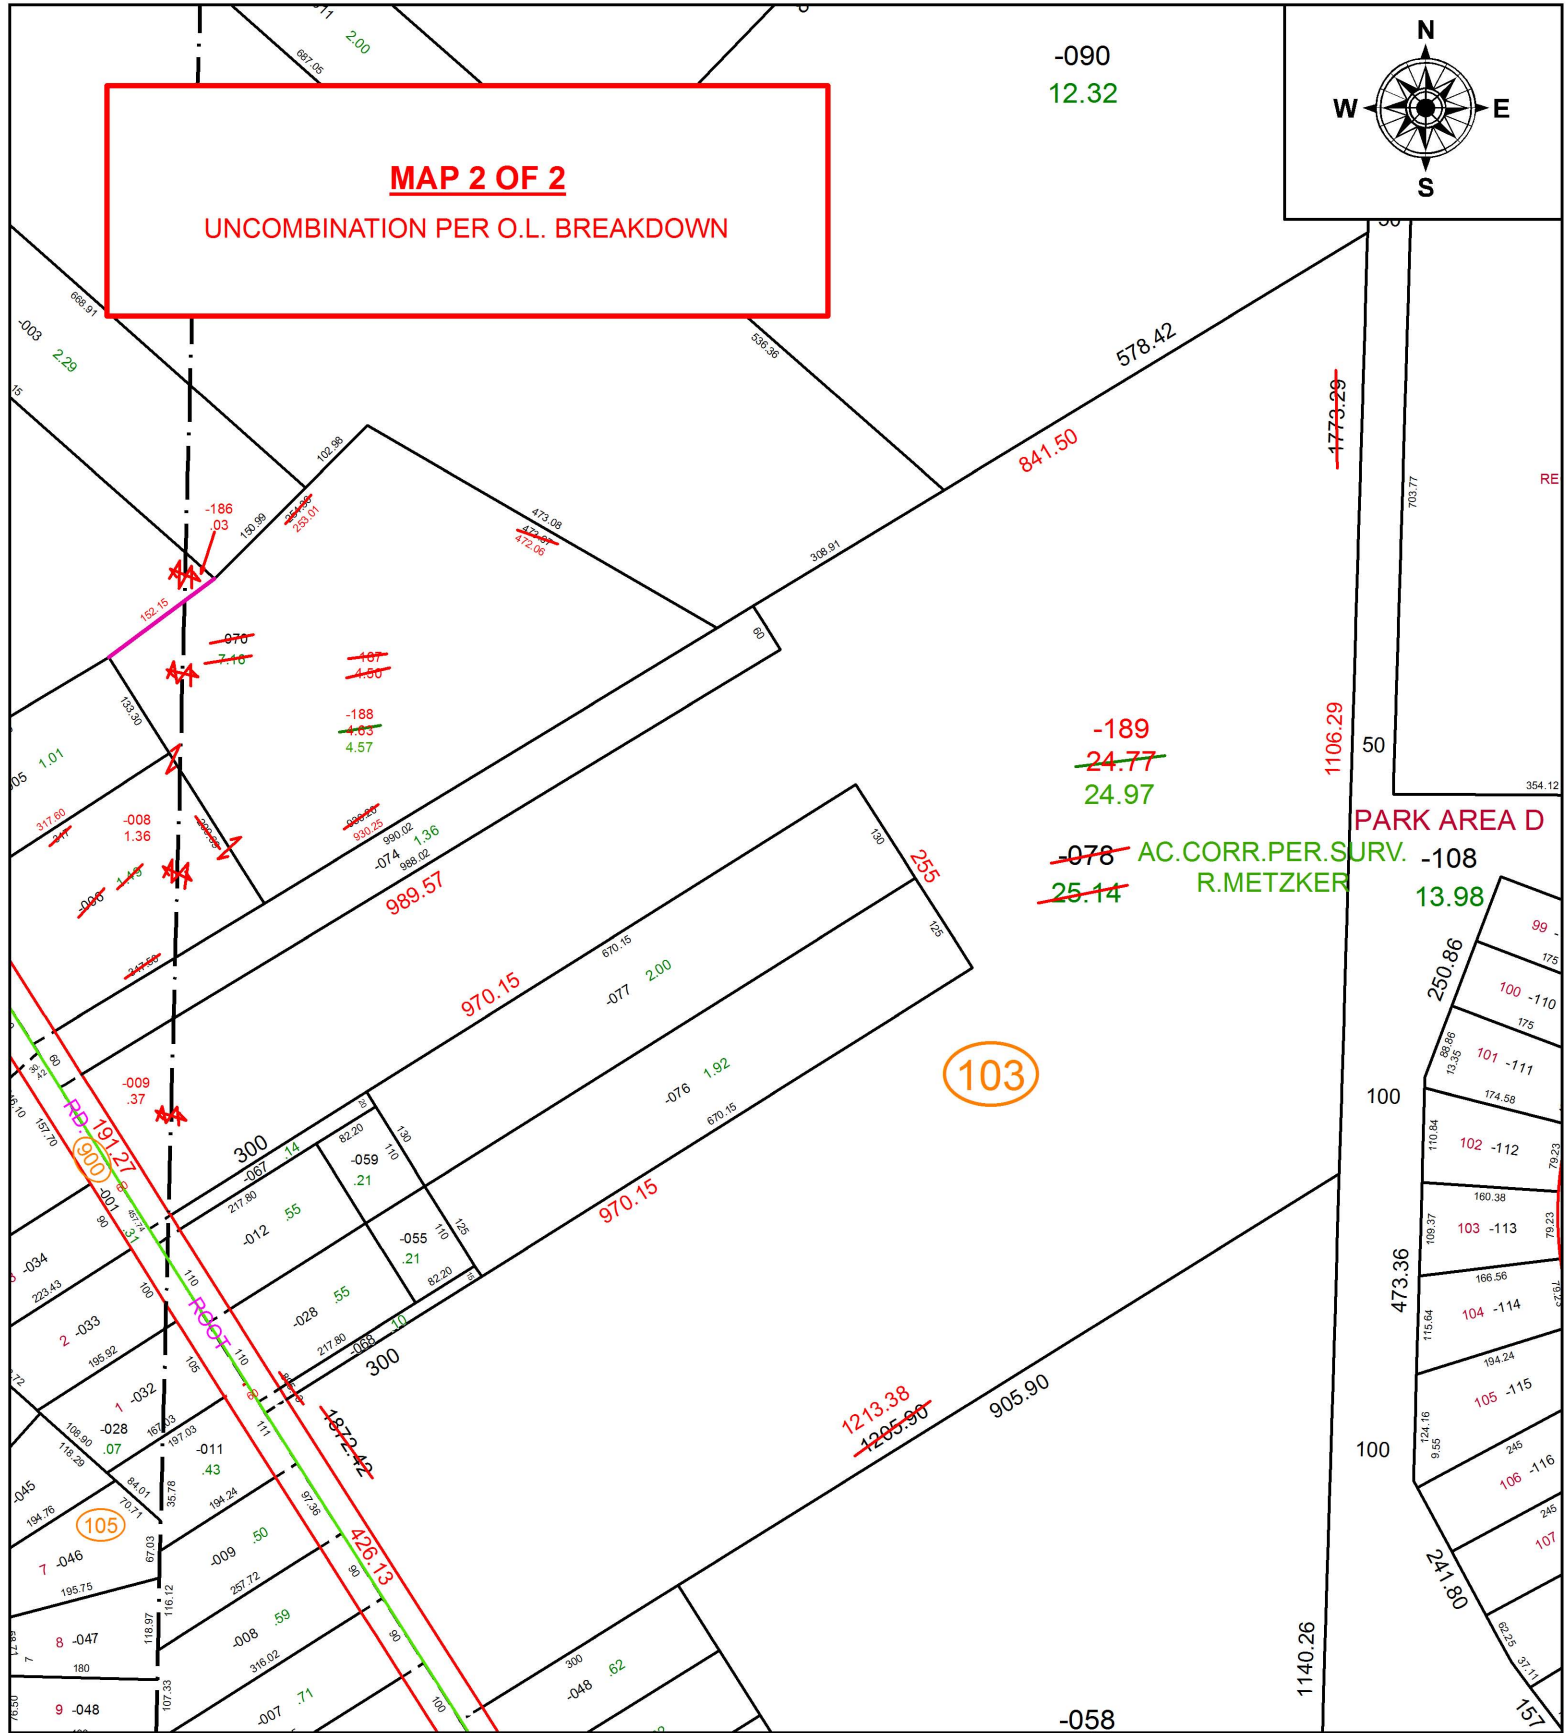

**SPLITS/DEEDS PROCESSED**  
LORAIN COUNTY TAX MAP DEPARTMENT  
226 MIDDLE AVE. ELYRIA, OH

SURVEYED BY: RICHARD METZKER  
CLOSURE: 1: 1,677,145  
MAP PAGE(S): 7-00-011  
APPROVED BY: RRM DATE: 5-29-18  
SCALE: 1" = 225 PRIOR INSTRUMENT: 20060182662