

PARENT PARCEL: 06-25-031-101-011


CHILD PARCEL: XX-XX-XXX-XXX-XXX


STARTING POINT: SOUTHWEST CORNER OF S/L 327 IN SPRING VALLEY SUB. NO.4

17-03819-D



MAP CORRECTION ONLY
CORR. PER SURVEY T.SIMON

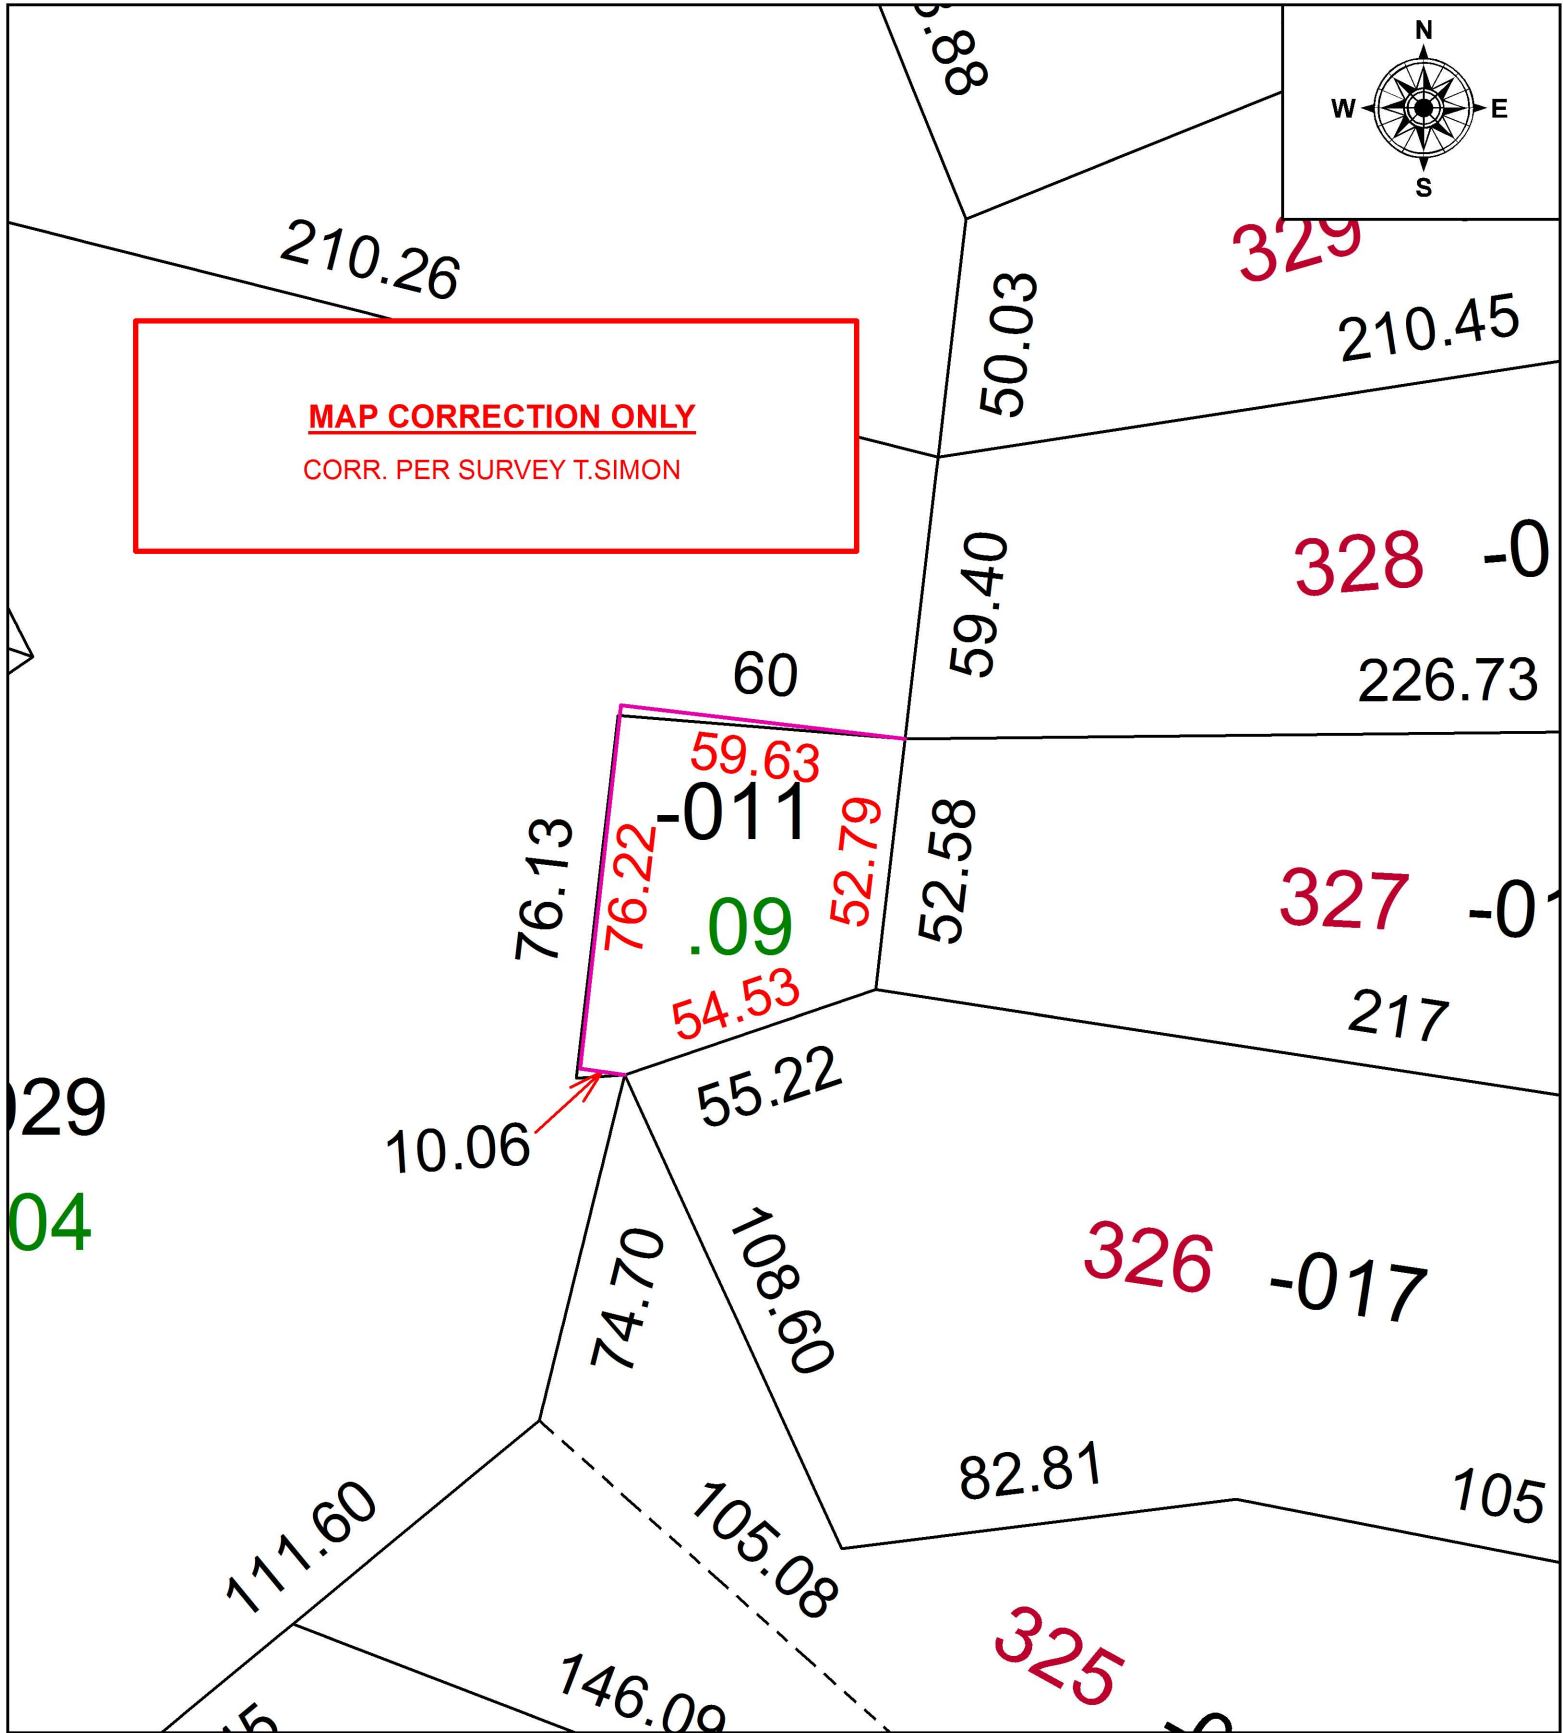

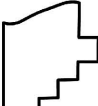 **SPLITS/DEEDS PROCESSED**
LORAIN COUNTY TAX MAP DEPARTMENT
226 MIDDLE AVE. ELYRIA, OH

SURVEYED BY: THOMAS A. SIMON
CLOSURE: 1: 36,329
MAP PAGE(S): 6-88
APPROVED BY: RRM DATE: 12-22-17
SCALE: 1" = 40' PRIOR INSTRUMENT: 20170627884