


PARENT PARCEL: 03-00-007-101-004, -007, -025, -029, -031, -035

CHILD PARCEL: 03-00-007-101-065

18-03821

STARTING POINT: NORTHWEST CORNER OF O.L.7

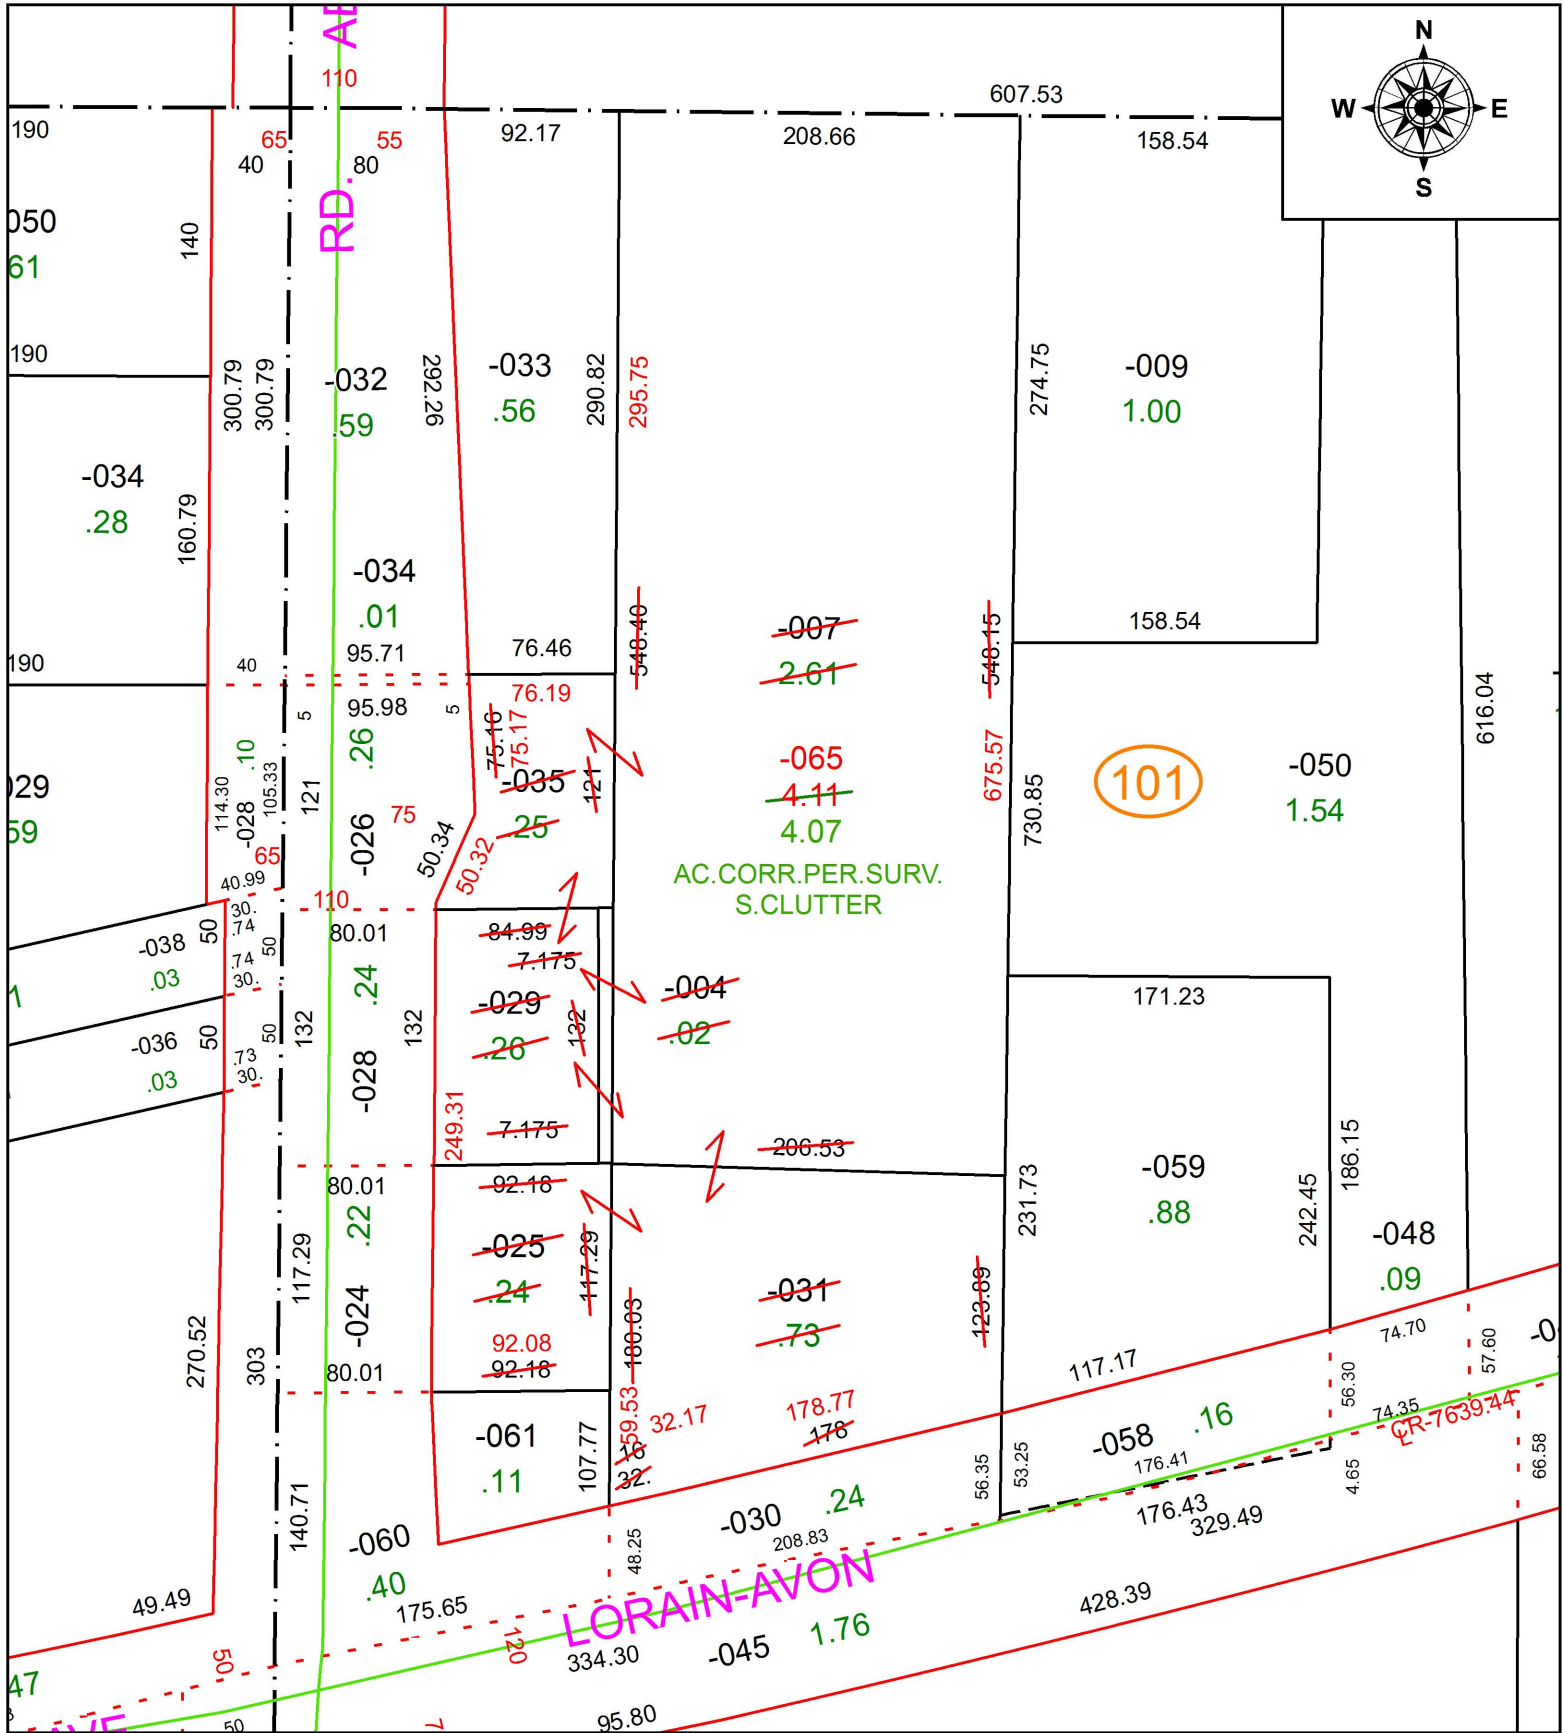

SPLITS/DEEDS PROCESSED

LORAIN COUNTY TAX MAP DEPARTMENT
226 MIDDLE AVE. ELYRIA, OH

SURVEYED BY: STEVEN W. CLUTTER

CLOSURE: 1: 196,009

MAP PAGE(S): 3-00-007

APPROVED BY: RRM DATE: 6-6-18

SCALE: 1" = 100 PRIOR INSTRUMENT: 20180670714