


PARENT PARCEL: 05-00-052-000-055, 05-00-053-000-103


CHILD PARCEL: 05-00-052-000-057 THRU -060, 05-00-053-000-105, -106

STARTING POINT: INTERSECTION OF C/L OF OBERLIN RD. AND SOUTH LINE OF S.R. 113

18-03822

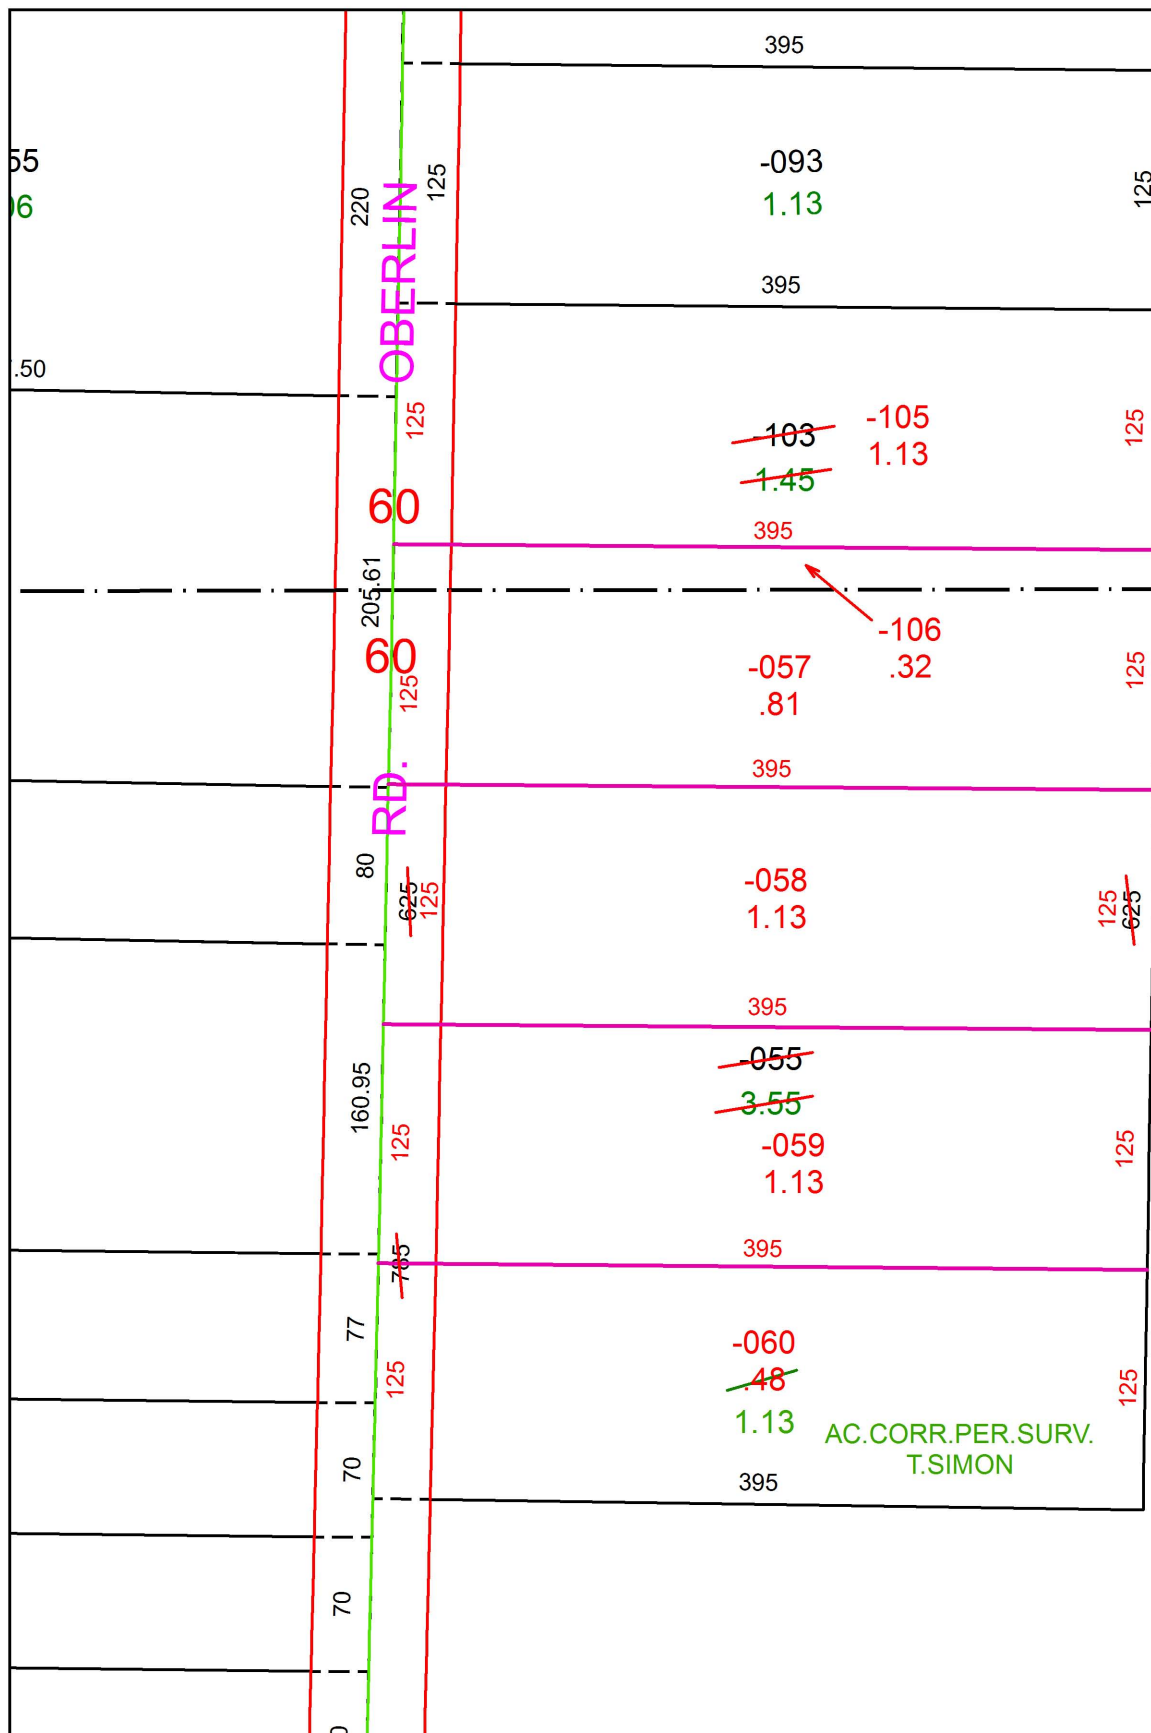

1

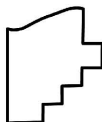

SPLITS/DEEDS PROCESSED
 LORAIN COUNTY TAX MAP DEPARTMENT
 226 MIDDLE AVE. ELYRIA, OH

SURVEYED BY: THOMAS A. SIMON
 CLOSURE: 1: 2147483648
 MAP PAGE(S): 5-00-052
 APPROVED BY: RRM DATE: 6-7-18
 SCALE: 1" = 100 PRIOR INSTRUMENT: 20180673695