
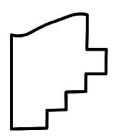
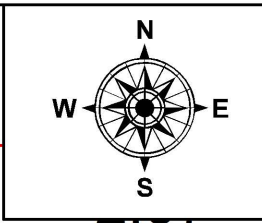


PARENT PARCEL: 02-02-007-108-008

CHILD PARCEL: XX-XX-XXX-XXX-XXX

STARTING POINT: NORTHWEST CORNER OF S/L 55 IN FOREST HILL SUB. NO.3

18-03825-D

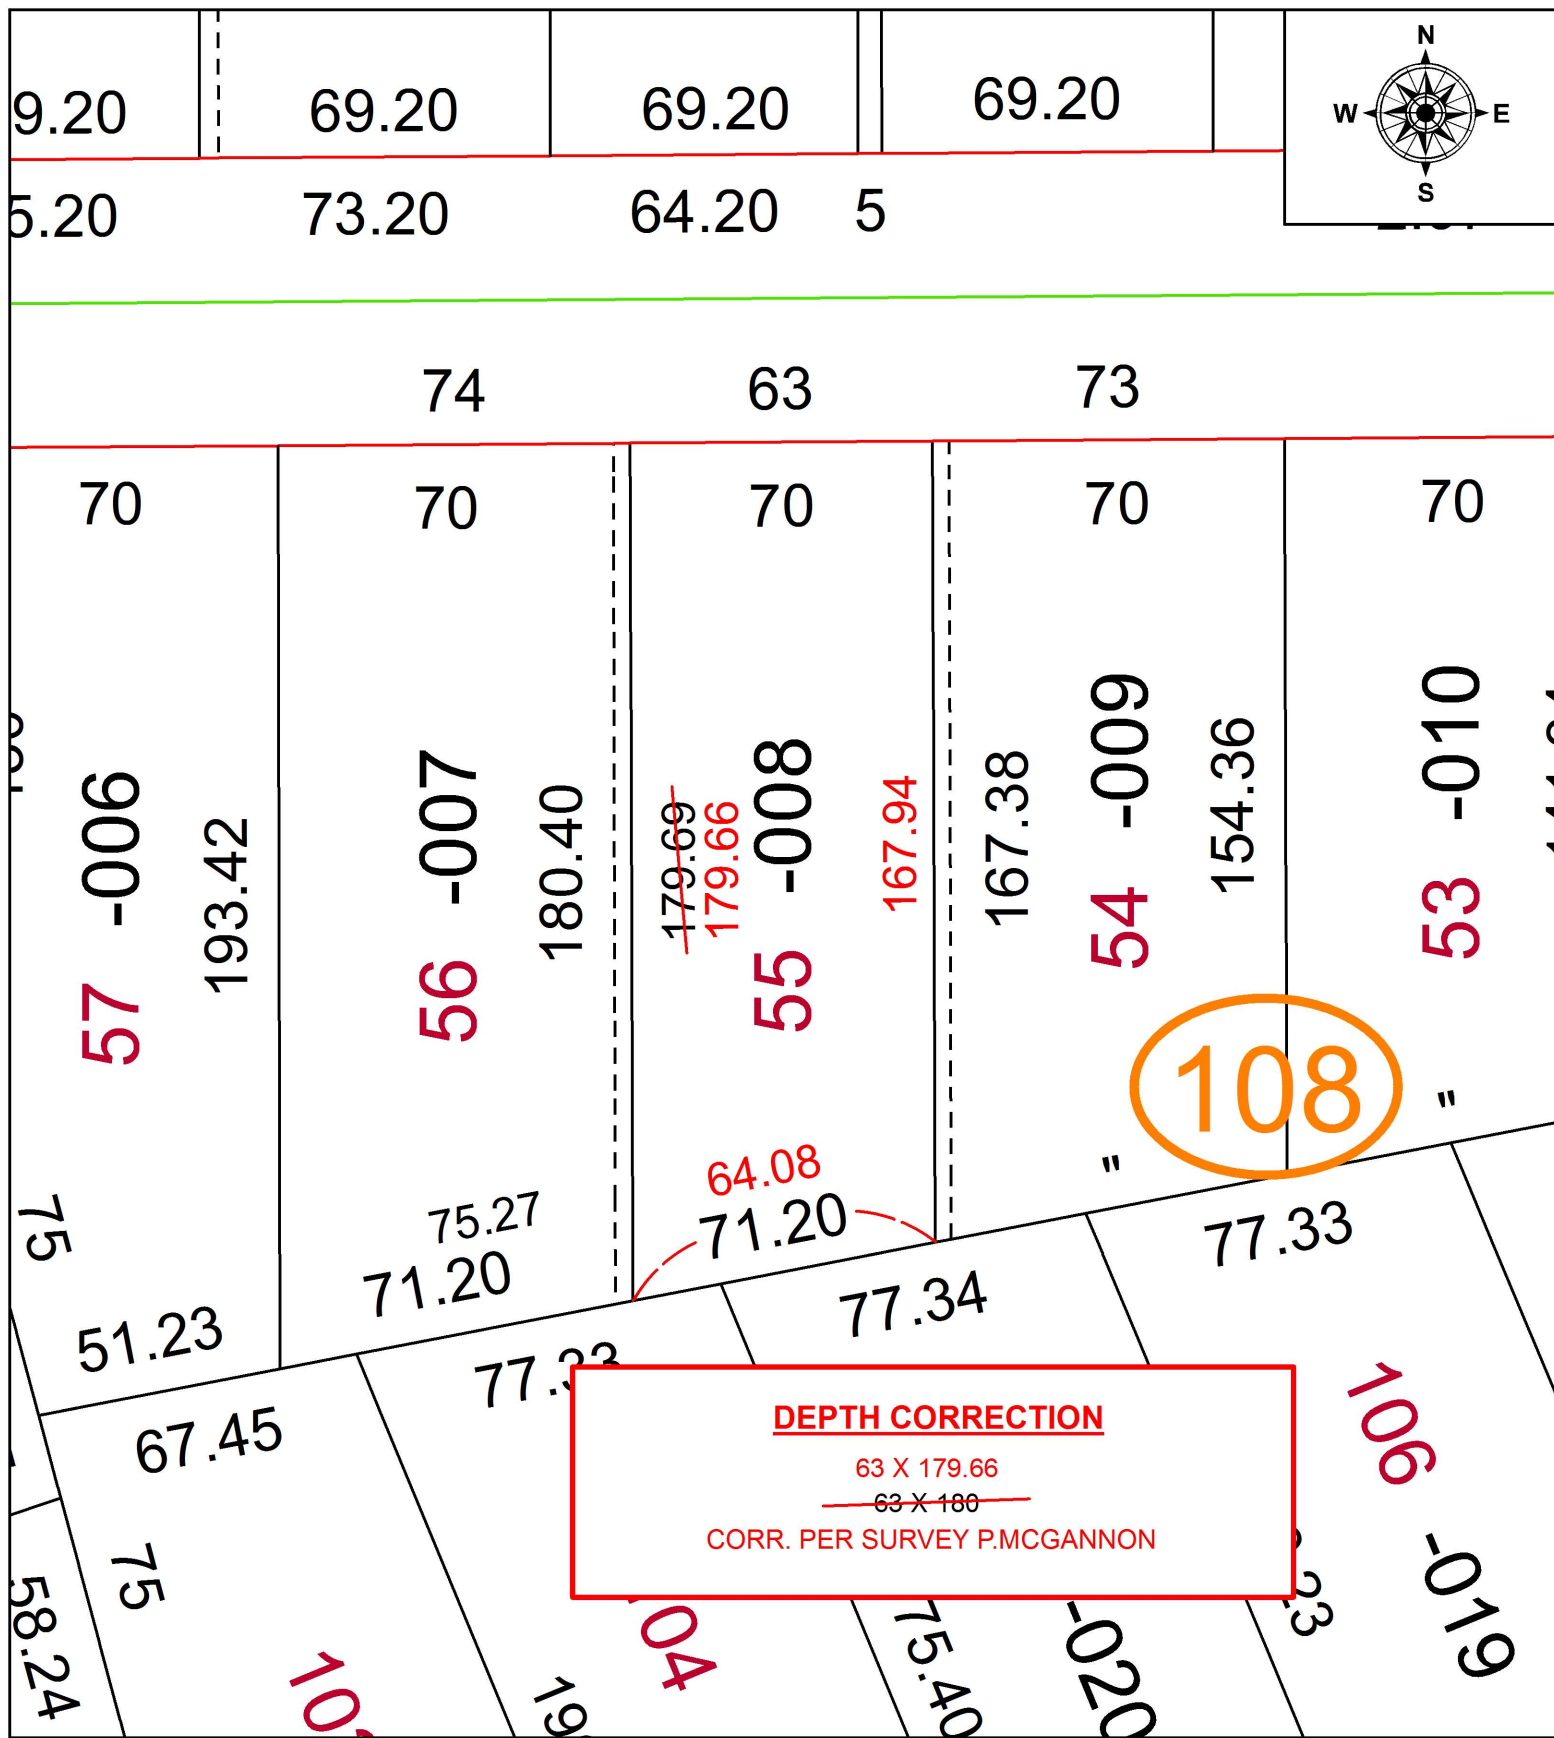

SPLITS/DEEDS PROCESSED
 LORAIN COUNTY TAX MAP DEPARTMENT
 226 MIDDLE AVE. ELYRIA, OH

SURVEYED BY: PATRICK A. MCGANNON
 CLOSURE: 1: 205,504
 MAP PAGE(S): 2-02-007
 APPROVED BY: RRM DATE: 1-25-18
 SCALE: 1" = 40 PRIOR INSTRUMENT: 20160576804