


PARENT PARCEL: 01-00-002-109-006

CHILD PARCEL: 01-00-002-109-086, -087

STARTING POINT: S/L 1196 IN VERMILION ON THE LAKE SUB. NO.1

18-03829

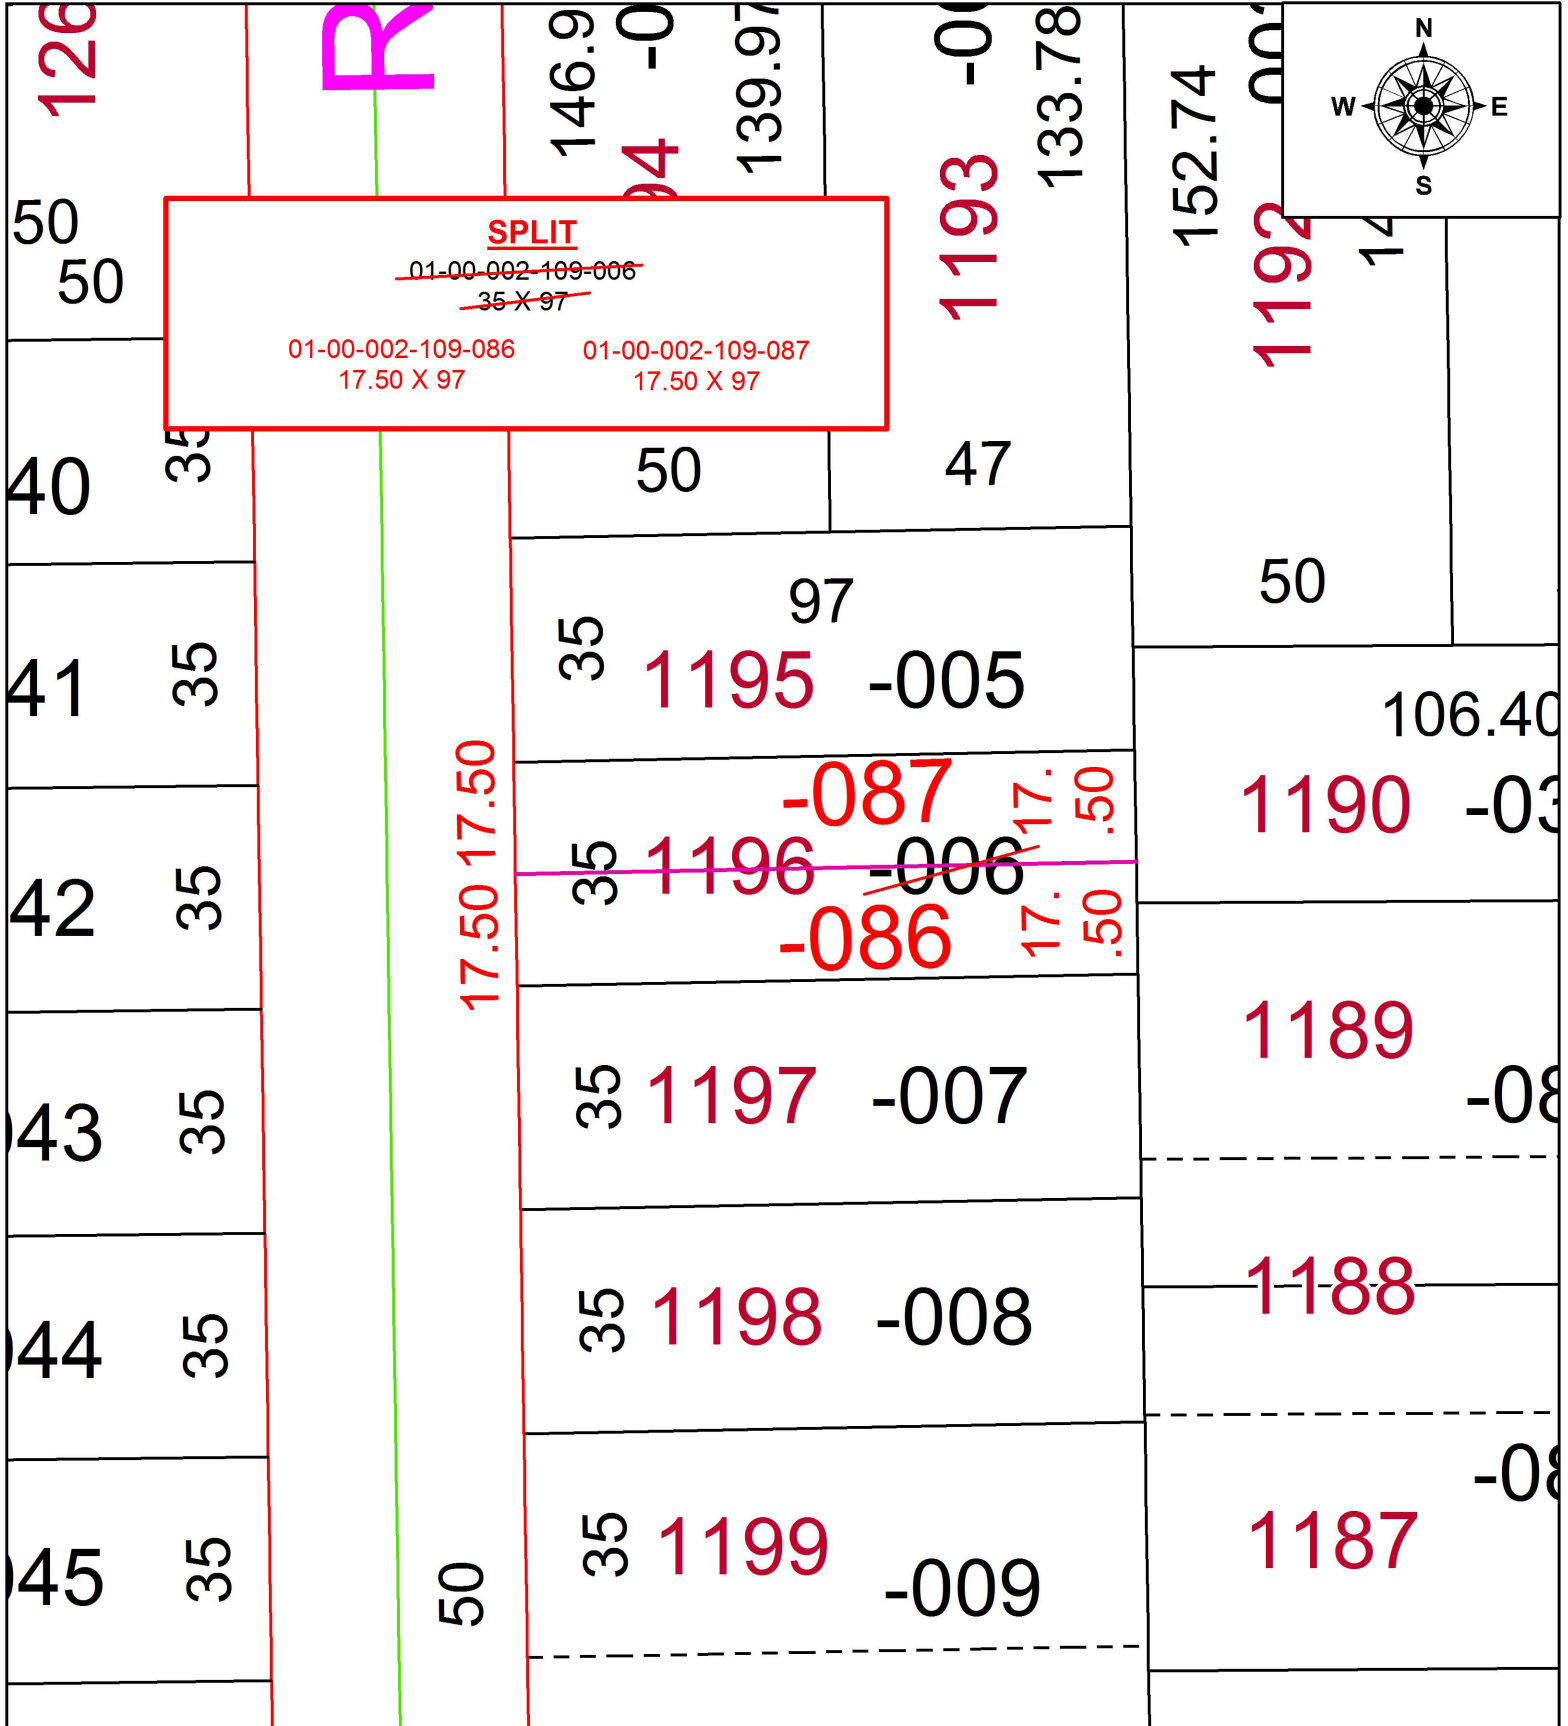

**SPLITS/DEEDS PROCESSED**  
 LORAIN COUNTY TAX MAP DEPARTMENT  
 226 MIDDLE AVE. ELYRIA, OH

SURVEYED BY: JAMES A. RESAR  
 CLOSURE: N/A  
 MAP PAGE(S): 1-00-002  
 APPROVED BY: RRM DATE: 6-25-18  
 SCALE: 1" = 30' PRIOR INSTRUMENT: 20090285586