
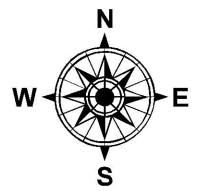


PARENT PARCEL: 04-00-007-126-026, 04-00-007-123-029, 04-00-007-124-033

CHILD PARCEL: 04-00-007-900-058 THRU -060

18-03830-C


STARTING POINT: N/A

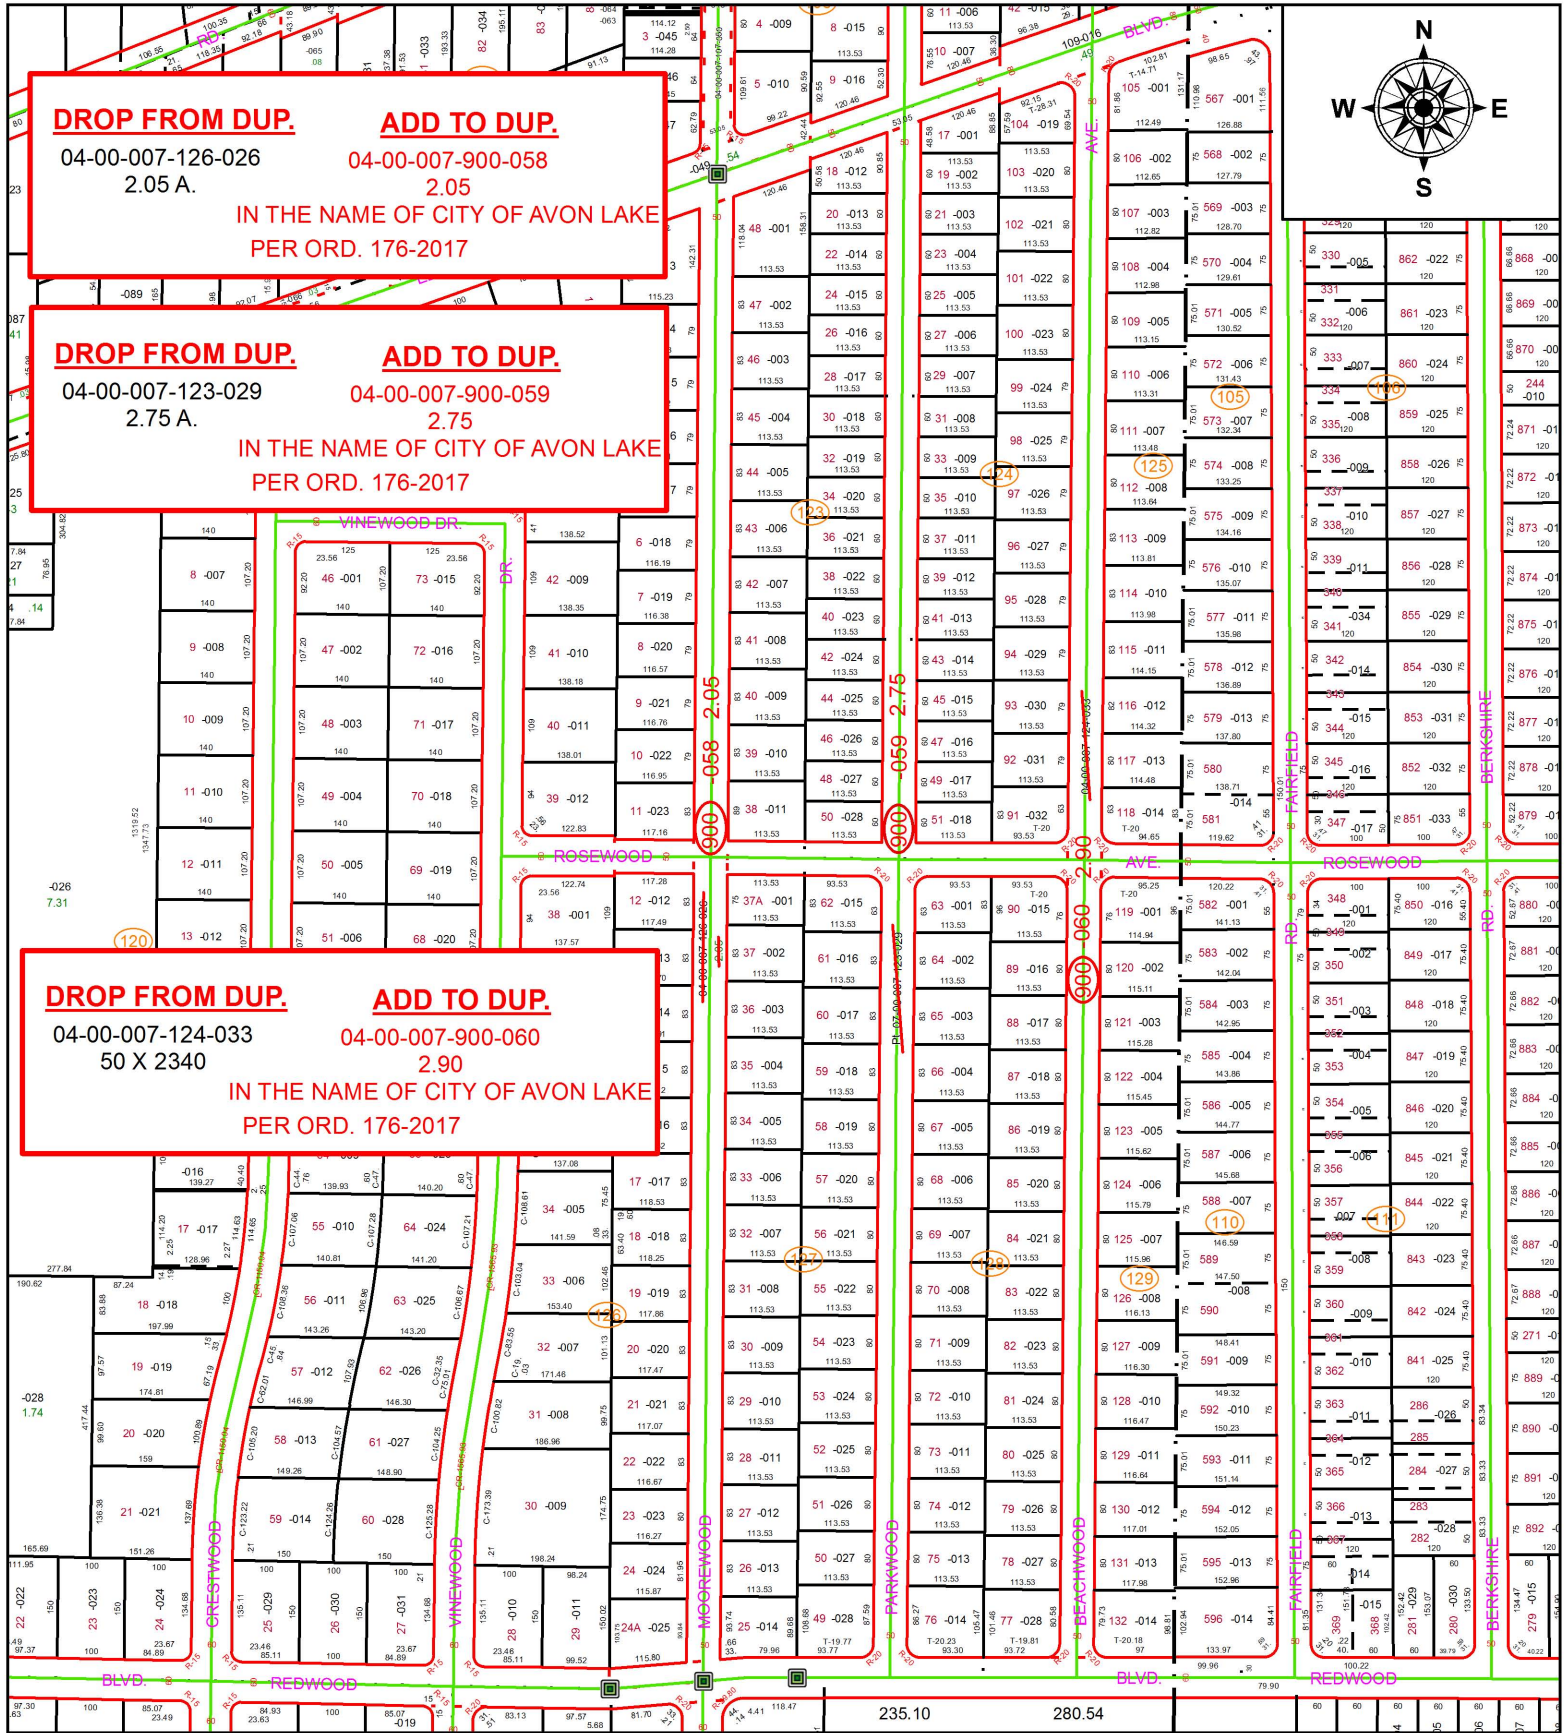

DROP FROM DUP. ADD TO DUP.
 04-00-007-126-026 04-00-007-900-058
 2.05 A. 2.05
 IN THE NAME OF CITY OF AVON LAKE
 PER ORD. 176-2017

DROP FROM DUP. ADD TO DUP.
 04-00-007-123-029 04-00-007-900-059
 2.75 A. 2.75
 IN THE NAME OF CITY OF AVON LAKE
 PER ORD. 176-2017

DROP FROM DUP. ADD TO DUP.
 04-00-007-124-033 04-00-007-900-060
 50 X 2340 2.90
 IN THE NAME OF CITY OF AVON LAKE
 PER ORD. 176-2017

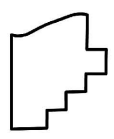

SPLITS/DEEDS PROCESSED
 LORAIN COUNTY TAX MAP DEPARTMENT
 226 MIDDLE AVE. ELYRIA, OH

SURVEYED BY: N/A
 CLOSURE: N/A
 MAP PAGE(S): 4-00-007
 APPROVED BY: RRM DATE: 2-6-18
 SCALE: 1" = 285 PRIOR INSTRUMENT: N/A