


PARENT PARCEL: 03-00-077-107-014


CHILD PARCEL: XX-XX-XXX-XXX-XXX

STARTING POINT: SOUTHWEST CORNER OF S/L 93 IN MEADOW VALLEY SUB. NO.3

18-03832-C

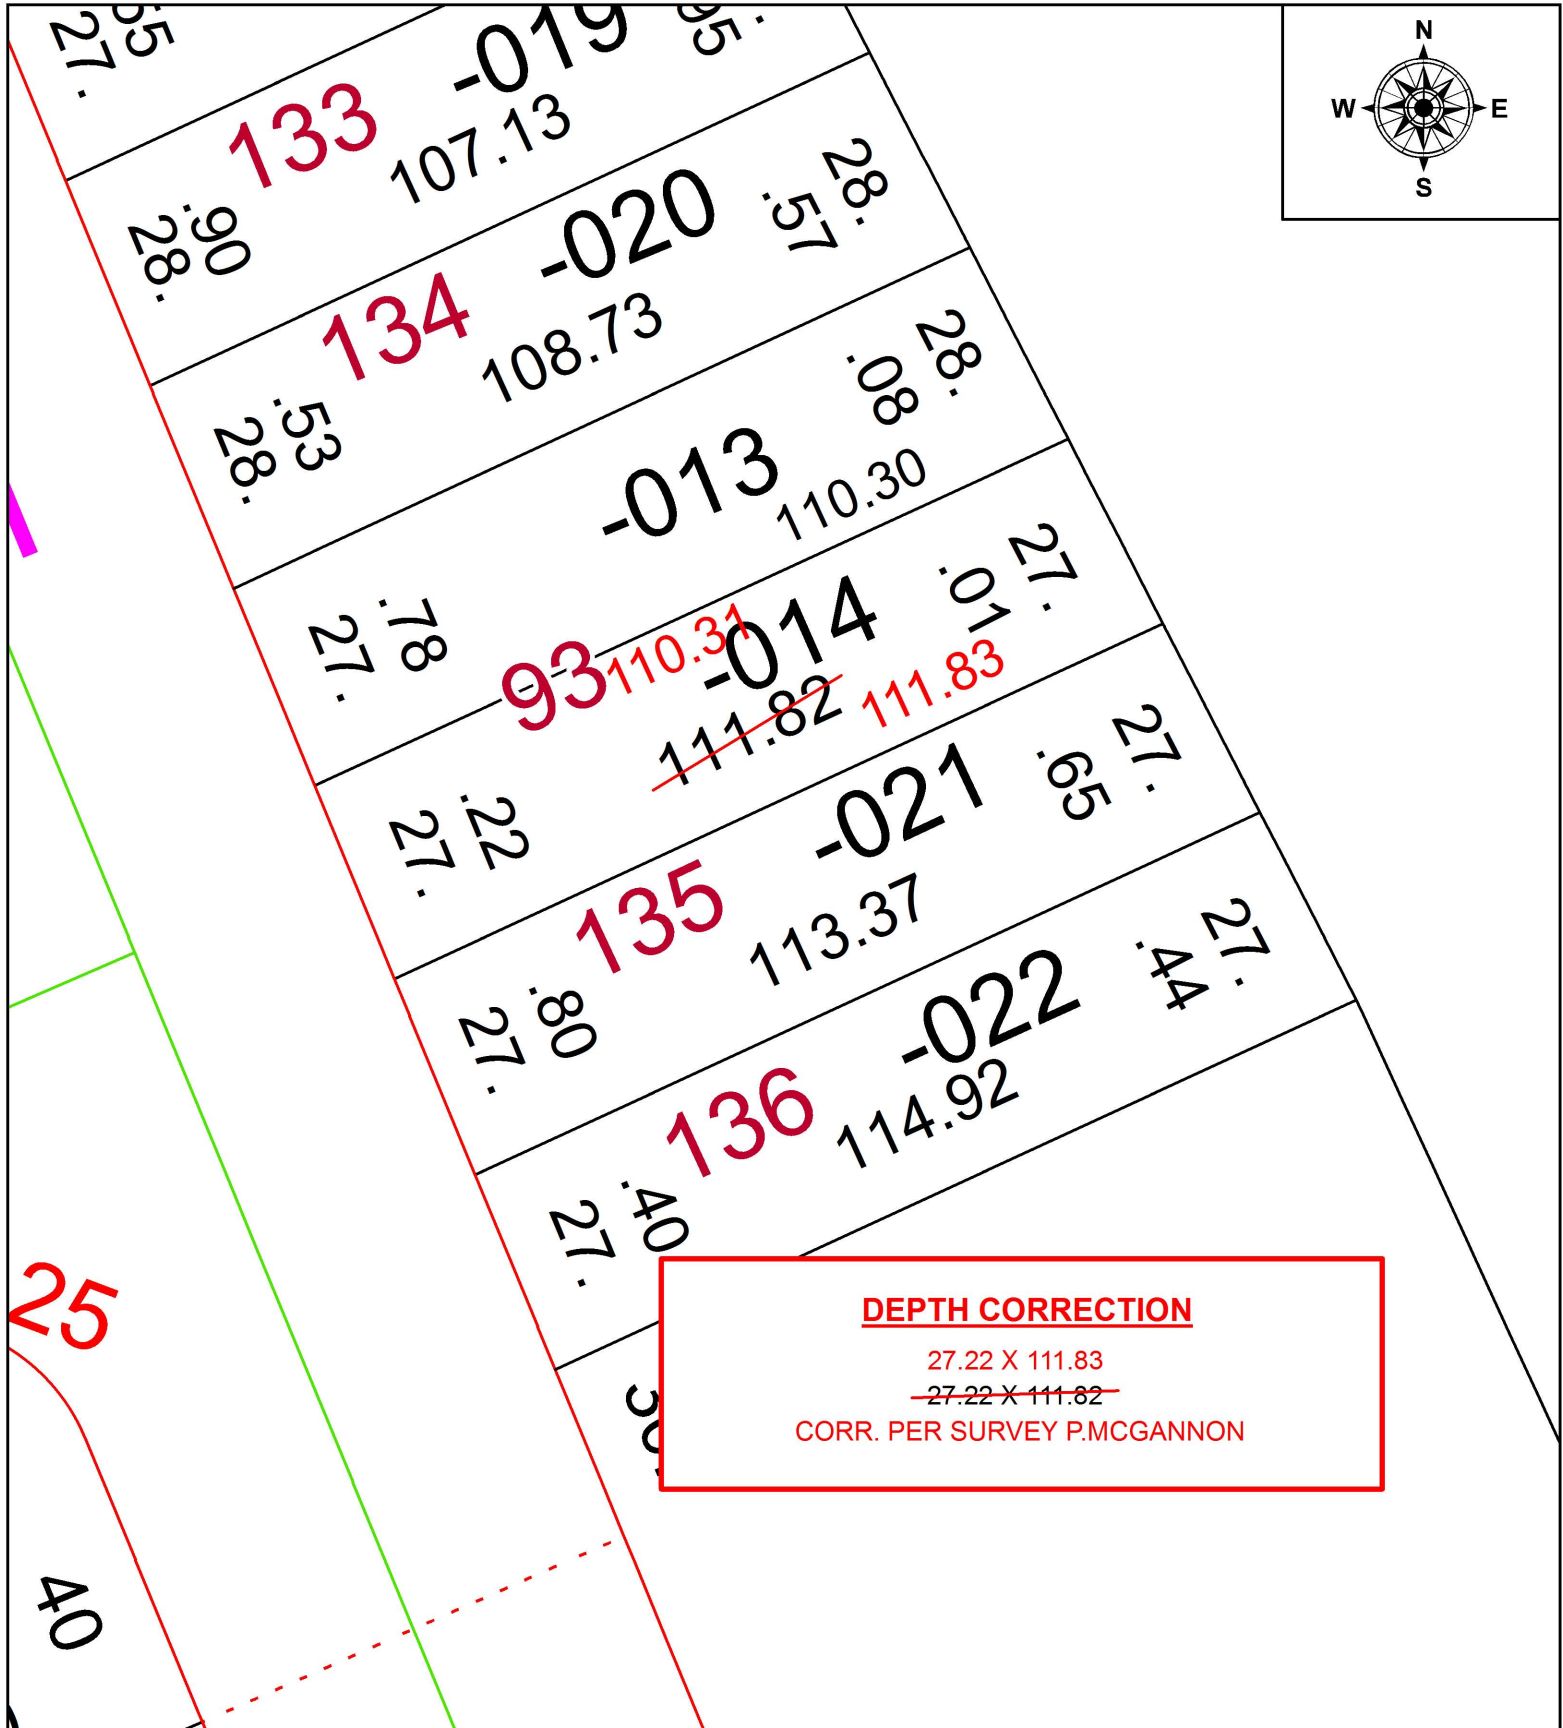

DEPTH CORRECTION
 27.22 X 111.83
~~27.22 X 111.82~~
 CORR. PER SURVEY P.MCGANNON

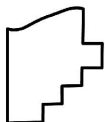

SPLITS/DEEDS PROCESSED
 LORAIN COUNTY TAX MAP DEPARTMENT
 226 MIDDLE AVE. ELYRIA, OH

SURVEYED BY: PATRICK A. MCGANNON
 CLOSURE: 1: 189,833
 MAP PAGE(S): 3-00-077
 APPROVED BY: RRM DATE: 2-12-18
 SCALE: 1" = 25' PRIOR INSTRUMENT: 20170649933