


PARENT PARCEL: 10-00-002-000-057, -058

CHILD PARCEL: 10-00-002-000-063 THRU -067

STARTING POINT: INTERSECTION OF C/L OF RUSSIA RD. AND C/L OF MURRAY RIDGE RD.



18-03832

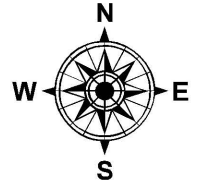

1414.20

1414.09

~~-058~~  
~~63.31~~  
-066  
61.32

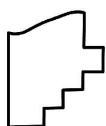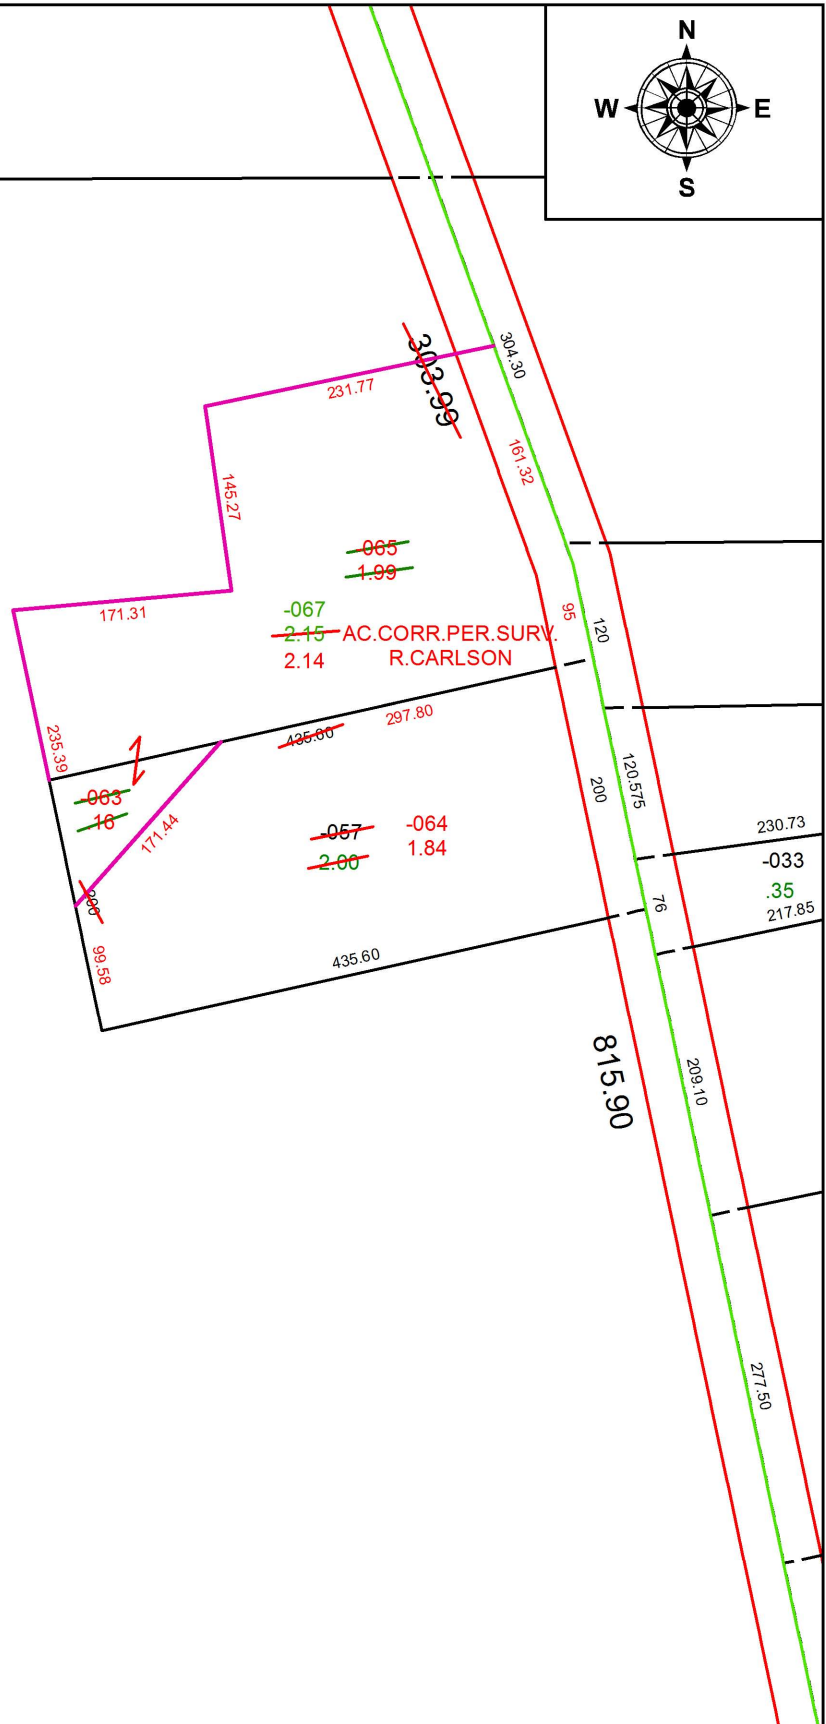

**SPLITS/DEEDS PROCESSED**  
LORAIN COUNTY TAX MAP DEPARTMENT  
226 MIDDLE AVE. ELYRIA, OH

SURVEYED BY: RICHARD D. CARLSON

CLOSURE: 1: 105,314

MAP PAGE(S): 10-00-002

APPROVED BY: RRM DATE: 7-2-18

SCALE: 1" = 150 PRIOR INSTRUMENT: 20040042982