


PARENT PARCEL: 02-00-051-142-017

CHILD PARCEL: XX-XX-XXX-XXX-XXX

STARTING POINT: INTERSECTION OF SOUTH LINE OF COLORADO AVE AND WEST LINE OF HENDERSON DR.

18-03837-C

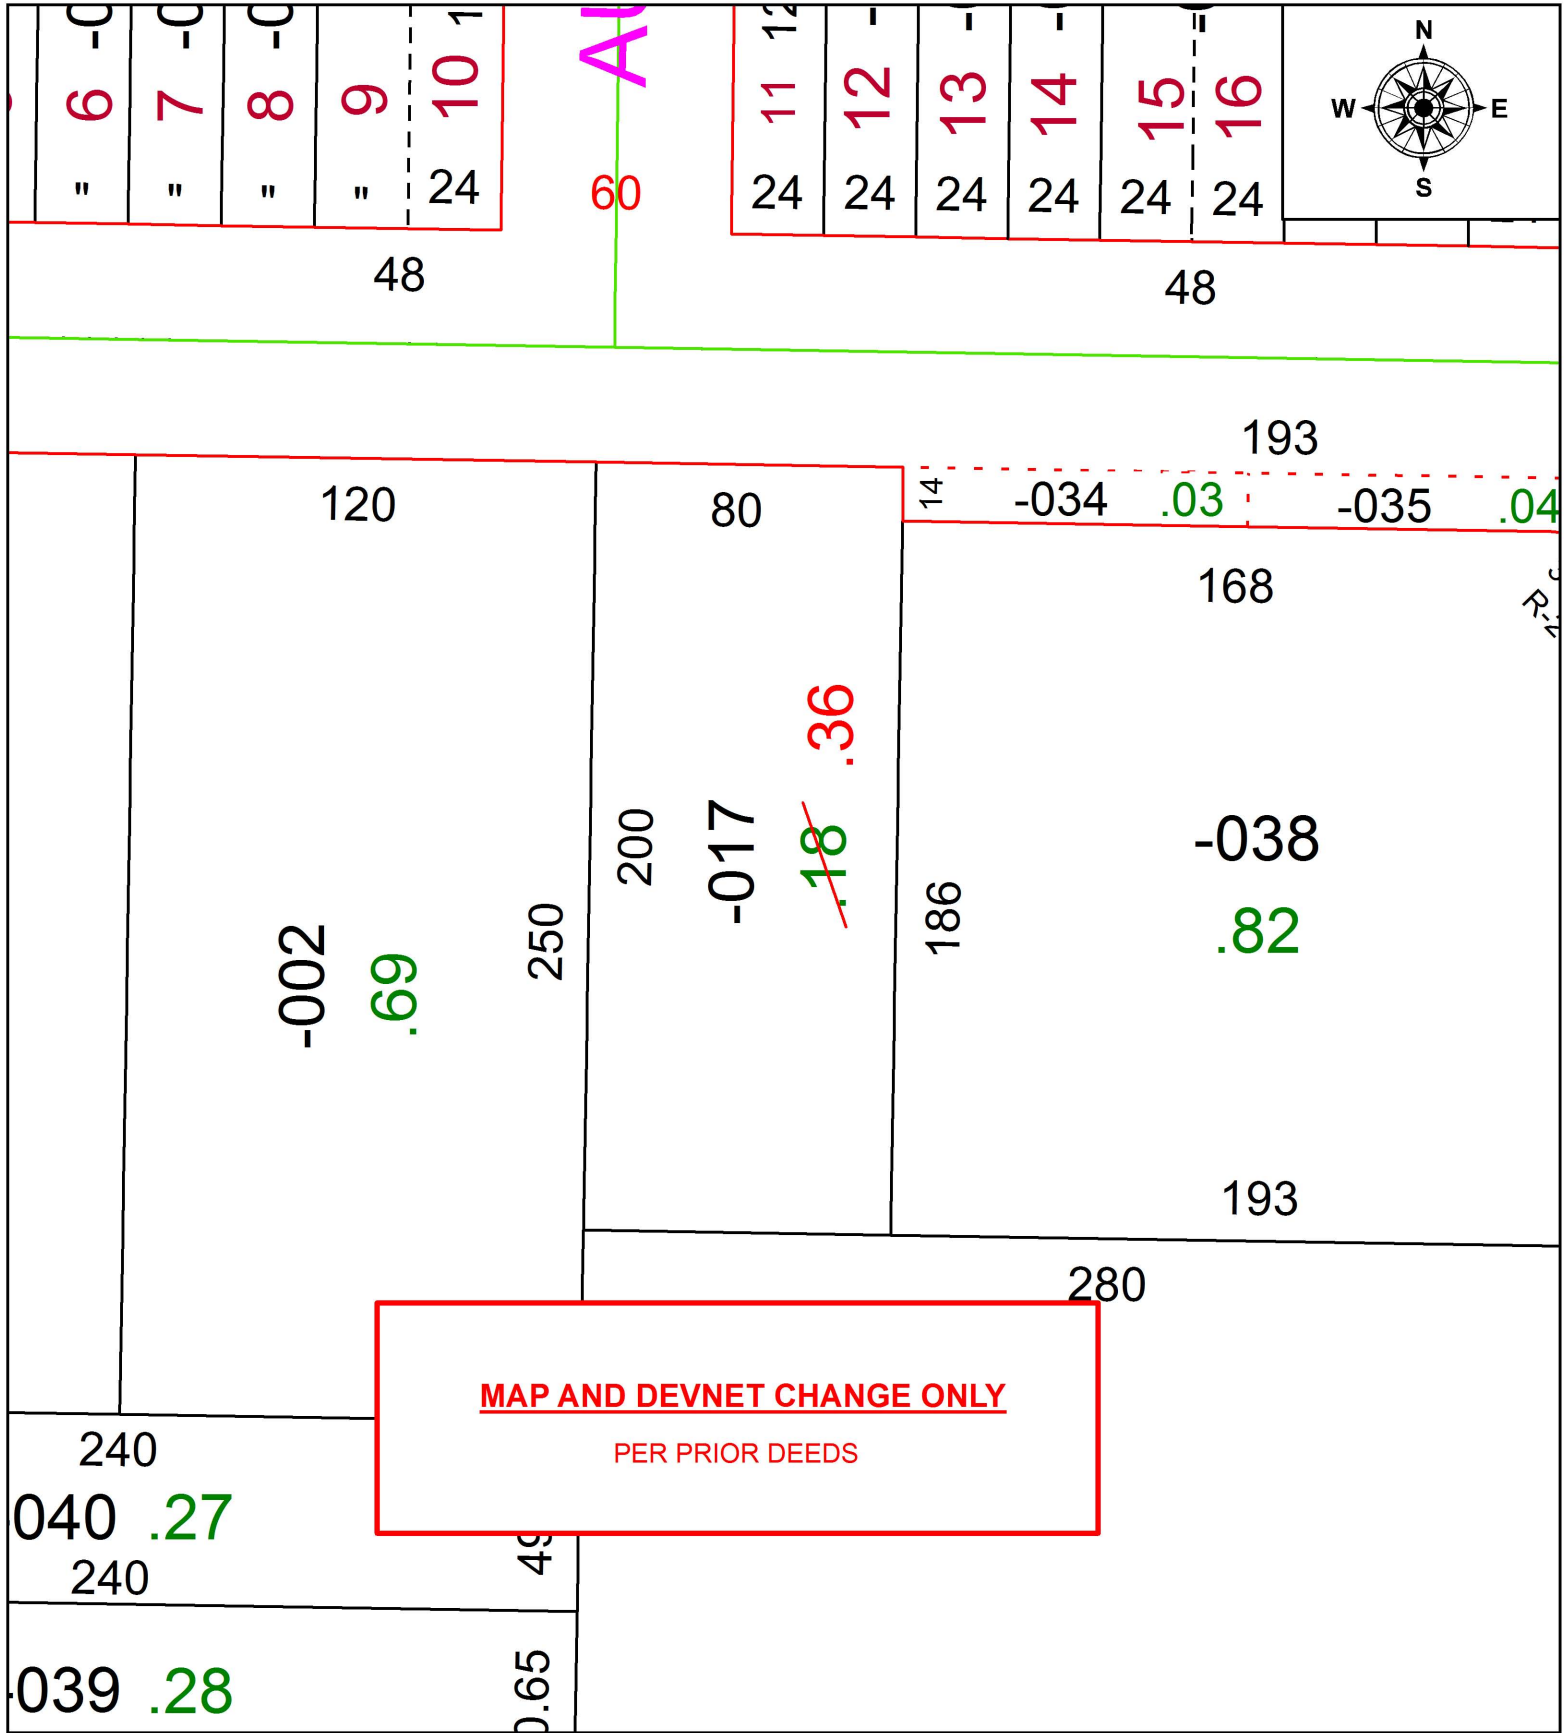

**MAP AND DEVNET CHANGE ONLY**  
 PER PRIOR DEEDS



**SPLITS/DEEDS PROCESSED**  
 LORAIN COUNTY TAX MAP DEPARTMENT  
 226 MIDDLE AVE. ELYRIA, OH

SURVEYED BY: \_\_\_\_\_ N/A  
 CLOSURE: \_\_\_\_\_ N/A  
 MAP PAGE(S): \_\_\_\_\_ 18-00-041  
 APPROVED BY: \_\_\_\_\_ RRM DATE: \_\_\_\_\_ 2-13-18  
 SCALE: \_\_\_\_\_ 1" = 50 \_\_\_\_\_ PRIOR INSTRUMENT: \_\_\_\_\_ OR 704/865